

145  
5/3/73 Ready

app  
5-11-73  
2224

# PERMIT

SEWAGE DISPOSAL SYSTEM

MARYLAND STATE DEPARTMENT OF HEALTH

HOWARD COUNTY

TAVED 05-345014

ELLICOTT CITY

DISTRICT 5

**INDEXED**

P 17888

A 14567

DATE 1/23/73

Jack Fyock

IS PERMITTED TO INSTALL  ALTER

ADDRESS Ten Oaks Road, Clarksville, Maryland

PHONE 286-2939

A SEWAGE DISPOSAL SYSTEM LOCATED AT

SUBDIVISION Wood Ridge

ROAD

Nichols Drive

LOT

1

PROPERTY OWNER

Charles R. Leap  
Heath & Karen Burroughs

ADDRESS

SPECIFICATIONS - 3 bedrooms

DRAIN FIELD \_\_\_\_\_ DEPTH \_\_\_\_\_ FEET, BOTTOM AREA \_\_\_\_\_ SQ. FT.

SEEPAGE PITS \_\_\_\_\_ ABSORBENT SIDE-WALL AREA \_\_\_\_\_ SQ. FT.

SEPTIC TANK CAPACITY 1,000 GALLONS

FOR GARBAGE GRINDER, INCREASE DISPOSAL AREA 22% & TANK CAPACITY 50%.

OTHER ~~Dry well - dig pit 12 ft. sq. - set block and top for 10 ft. dia. and fill in rest of pit with gravel. Dry well to have 5 ft. effective depth below the first 7 ft. of original grade. Max. depth permitted for dry well is 12 ft. below original grade. Come off dry well 5 ft. - start trench - trench to be 40 ft. long, 2 ft. wide, 12 ft. deep with 5 ft. of gravel under pipe. Place dry well 80 ft. from front lot line and 20 ft. from left side line as seen when facing lot from Nichols Drive. The trench is to go across slope; that is run directly towards right side line - 11 to front line. CALL FOR INSPECTION OF TRENCH BEFORE GRAVEL IS INSTALLED.~~

NOTE: ALL PIPE FROM HOUSE TO SEPTIC TANK MUST BE CAST IRON.

PLANS APPROVED BY D. W. Monaghan DATE 1/10/73


PERMIT VOID AFTER THREE YEARS.

NOTE: INSTALL STAND PIPE ON DRY WELL AND SEPTIC TANK.

FILL SEPTIC TANK AND DISTRIBUTION BOX WITH WATER BEFORE CALLING FOR AN INSPECTION. COVER NO WORK UNTIL INSPECTED AND APPROVED.

NEITHER THE HOWARD COUNTY COMMISSIONERS NOR THE HEALTH DEPARTMENT IS RESPONSIBLE FOR THE SUCCESSFUL OPERATION OF ANY SYSTEM.

A 14567

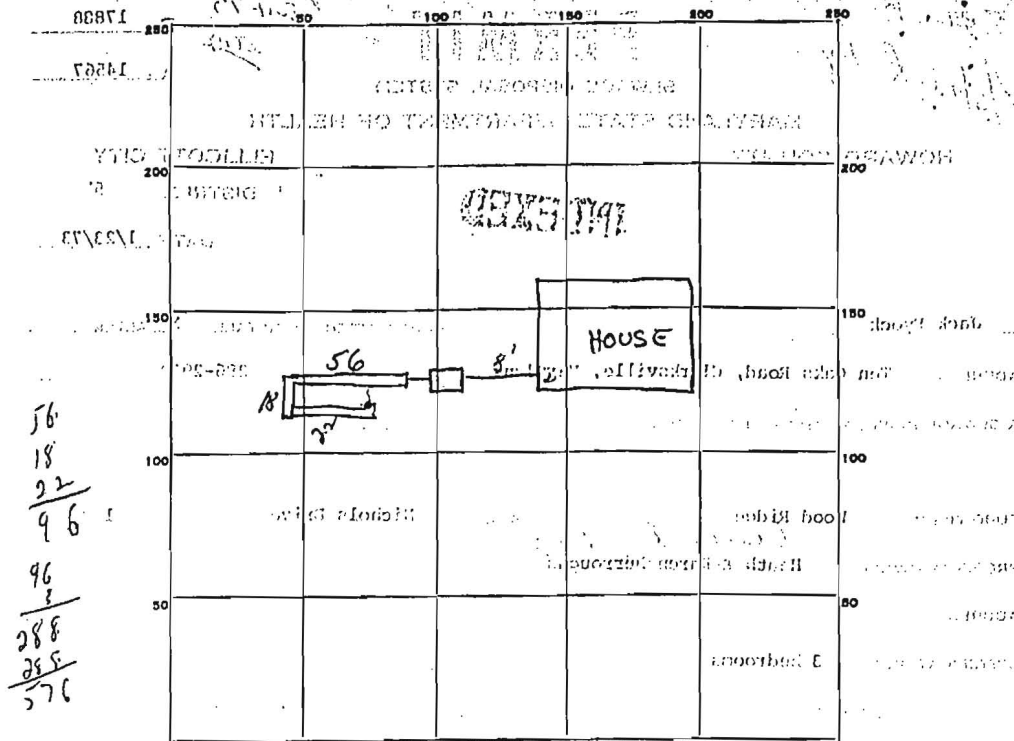

INDICATE NORTH. - NAME ADJOINING ROADWAY AS BASE LINE.

PERMIT CARD OK \_\_\_\_\_ 000,1

SEPTIC TANK, LEVEL OK \_\_\_\_\_ CLEANOUTS OK \_\_\_\_\_

DISTRIBUTION BOX LEVEL \_\_\_\_\_

TILE FIELD DEPTH 10 TRENCH WIDTH 2

GRAVEL DEPTH 60 TOTAL LENGTH 96

NUMBER OF TRENCHES \_\_\_\_\_ TOTAL BOTTOM AREA \_\_\_\_\_

SEEPAGE PITS, INSIDE DIAMETER \_\_\_\_\_ DEPTH BELOW INLET \_\_\_\_\_

ABSORBENT AREA \_\_\_\_\_ SQ. FT.

REMARKS Trench to be 75' was 10ft deep long portion to here

5ft. stone FF. 79 and 14' of gravel

5-4-73 Trench overall length 96' = 5ft + stone = 576 sq ft actual area

198 bottom area

774 sq ft total

DATE SYSTEM APPROVED 5-4-73 INSPECTOR [Signature]

56  
18  
22  
96  
96  
188  
288  
576