

WR-74 6/70

C 1 6933  
SEQUENCE NO. (DOWN USE ONLY)  
THIS NUMBER IS TO BE PUNCHED IN COLS. 3-8 (ALL CANS)

STATE OF MARYLAND  
DEPARTMENT OF WATER RESOURCES  
STATE OFFICE BLDG., ANNAPOLIS, MARYLAND 21401  
WELL COMPLETION REPORT

THIS REPORT MUST BE SUBMITTED WITHIN 30 DAYS AFTER WELL COMPLETION  
FILL IN THIS FORM COMPLETELY

DATE RECEIVED (DOWN USE ONLY)  
DATE WELL COMPLETED 3/25/73  
6-13

DEPTH OF WELL 100  
22 (TO NEAREST FOOT) 20

PERMIT NO. FROM "PERMIT TO DRILL WELL"  
28 29 30 31 32 33 34 35 36 37  
DRILLERS IDENTIFICATION NO. 709

OWNER BURROUGHS HEATH  
LAST NAME FIRST NAME  
STREET OR RFD P. O. Box 320 BROOKVILLE POST OFFICE 70729

WELL LOG  
STATE THE KIND OF FORMATIONS PENETRATED, THEIR COLOR, DEPTH, THICKNESS AND IF WATER BEARING  
DESCRIPTION (USE ADDITIONAL SHEETS IF NECESSARY)

Table with columns: FEET (FROM, TO), CHECK IF WATER BEARING. Includes handwritten entries: 'Mica Sand 0 70' and 'Mica Rock 70 66'.

GROUTING RECORD  
WELL HAS BEEN GROUTED (CIRCLE APPROPRIATE BOX) YES [X] NO [ ]

TYPE OF GROUTING MATERIAL (CIRCLE BOX)  
CEMENT [C] M BENTONITE CLAY [B] C  
NO. OF BAGS 17 NO. OF POUNDS 1720  
GALLONS OF WATER 146  
DEPTH OF GROUT SEAL (TO NEAREST FOOT)  
FROM 0 FT. TO 60 FT.

CASING RECORD  
CASING TYPES (CIRCLE APPROPRIATE BOX)  
STEEL [S] T CONCRETE [C] O  
PLASTIC [P] L OTHER [O] T

MAIN CASING TYPE [S] T  
NOMINAL DIAMETER TOP (MAIN) CASING (NEAREST INCH) 6  
TOTAL DEPTH OF MAIN CASING (NEAREST FOOT) 70

OTHER CASING (IF USED)  
DIAMETER (INCH) DEPTH (FEET) FROM TO

SCREEN RECORD  
SCREEN TYPE OR OPEN HOLE (CIRCLE APPROPRIATE BOX)  
STEEL [S] T BRASS OR BRONZE [B] R OPEN HOLE [H] O  
PLASTIC [P] L OTHER [O] T

DEPTH (NEAREST WHOLE FOOT)  
FROM TO  
1 2 3 (SEQ. NO.) 0  
1 8 9 11 15 17 21  
2 23 24 26 30 32 36  
3 38 39 41 45 47 51  
SLOT SIZE 1, 2, 3,

CIRCLE APPROPRIATE BOXES  
A WELL WAS ABANDONED AND SEALED WHEN THIS WELL WAS COMPLETED  
E ELECTRIC LOG OBTAINED  
C COPY OF ELECTRIC LOG ATTACHED

I HEREBY CERTIFY THAT I HAVE COMPLIED WITH ALL CONDITIONS STATED ON THE ABOVE-CAPTIONED "PERMIT TO DRILL WELL", AND THAT INFORMATION CONTAINED IN THIS REPORT IS TRUE, ACCURATE, AND COMPLETE TO THE BEST OF MY KNOWLEDGE, INFORMATION AND BELIEF.  
DRILLERS NAME  
SIGNATURE Howard Dillan

DIAMETER OF SCREEN 56 (NEAREST INCH)  
FROM 60 TO  
GRAVEL PACK  
IF WELL DRILLED WAS A FLOWING WELL CIRCLE BOX 08 [X] F  
OWN USE ONLY (NOT TO BE FILLED IN BY DRILLER) (I.R.O.S.)  
TELESCOPE CASING LOG INDICATOR OTHER DATA AVAILABLE

C 3  
1 2 3 (SEQ. NO.) 0  
PUMPING TEST

HOURS PUMPED (TO NEAREST HOUR) 6  
PUMPING RATE (GALLONS PER MINUTE TO NEAREST GALLON) 20

METHOD USED TO MEASURE PUMPING RATE TIME  
WATER LEVEL (DISTANCE FROM LAND SURFACE) BEFORE PUMPING 15 (NEAREST FOOT)

WHEN PUMPING 22 (NEAREST FOOT)  
TYPE OF PUMP USED (CIRCLE APPROPRIATE BOX)  
AIR [A] PISTON [P] TURBINE [T]  
CENTRIFUGAL [C] ROTARY [R] OTHER [O]

JET [J] SUBMERSIBLE [S]

PUMP INSTALLED  
TYPE OF PUMP (WRITE APPROPRIATE LETTER IN BOX - SEE ABOVE: A, C, J, P, R, S, T, O)


DRILLER WILL INSTALL PUMP (CIRCLE APPROPRIATE BOX) YES [X] NO [ ]  
CAPACITY: GALLONS PER MINUTE (TO NEAREST GALLON) 31 35

PUMP HORSE POWER 37 41  
PUMP COLUMN LENGTH (NEAREST FOOT) 43 47

CASING HEIGHT (CIRCLE APPROPRIATE BOX AND ENTER CASING HEIGHT)  
+ ABOVE LAND SURFACE  
- BELOW (NEAREST FOOT)

LOCATION OF WELL ON LOT  
SHOW PERMANENT STRUCTURE SUCH AS BUILDINGS, SEPTIC TANKS, AND/OR OTHER LAND MARKS AND INDICATE NOT LESS THAN TWO DISTANCES (MEASUREMENTS TO WELL).

HEALTH

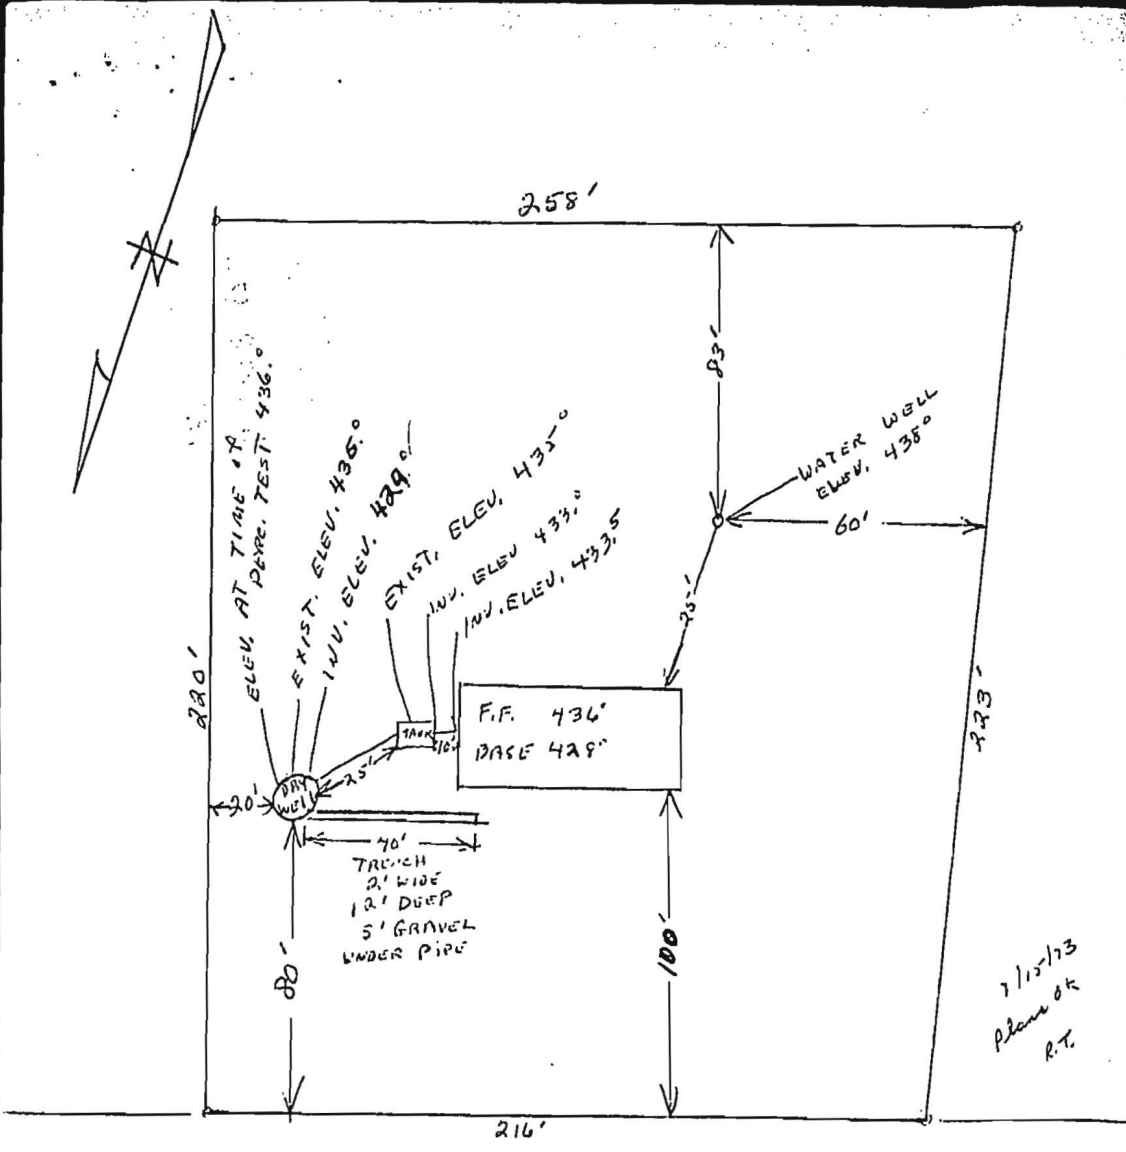

NICHOLS DRIVE

I CERTIFY THE ABOVE MEASUREMENTS  
 ARE ACTUAL AND CORRECT FOR THIS  
 PROPERTY,

SIGNED Stanley A. Sander  
 256-2058

LOT #1  
 WOOD RIDGE SUB.  
 5th ELECTRIC DIST.  
 HO. CO. MD.