

# APPLICATION

A 04038

SEWAGE DISPOSAL TESTING

P

MARYLAND STATE DEPARTMENT OF HEALTH

HOWARD COUNTY

ELLICOTT CITY

SEPTIC TANK - 750 gallons

DISTRICT 5

DATE 7-24-61

DRY WELL - 936 SIF. of side-wall area <sup>below the</sup> <sup>incident</sup> - 2 dry wells, each 12' in diameter, 13' deep, installed in the area which passed the percolation test.

TO: THE COUNTY HEALTH OFFICER  
ELLICOTT CITY, MARYLAND

I, HEREBY, APPLY FOR THE NECESSARY TESTS IN ORDER TO CONSTRUCT (OR RECONSTRUCT) A SEWAGE DISPOSAL SYSTEM.

PROPERTY OWNER B. Rust Canby

ADDRESS Highland Road PHONE Walker 4-9811 (Agents Mr. Johnson)

PROPERTY LOCATION:

SUBDIVISION Wood Ridge LOT NO. 1

ROAD AND DESCRIPTION High Nichols Drive

OCCUPANT \_\_\_\_\_ PHONE \_\_\_\_\_

PERSON TO CONSTRUCT SYSTEM \_\_\_\_\_

ADDRESS \_\_\_\_\_ PHONE \_\_\_\_\_

SIZE OF LOT 52,196 sq. ft. TYPE BLDG. 3  
NUMBER OF BEDROOMS

IF NOT SINGLE RESIDENCE DESCRIBE \_\_\_\_\_

SIGNATURE OF APPLICANT Robert Johnson agent.


APPROVED BY Walker 4-9811 FOR DRY WELL DATE 7/26/61  
(KIND OF SYSTEM)

REJECTED BY \_\_\_\_\_ FOR \_\_\_\_\_ DATE \_\_\_\_\_  
(KIND OF SYSTEM)

HOLD PENDING FURTHER TESTS \_\_\_\_\_ DATE \_\_\_\_\_

REASONS FOR REJECTION OR HOLDING \_\_\_\_\_

## THIS IS NOT A PERMIT

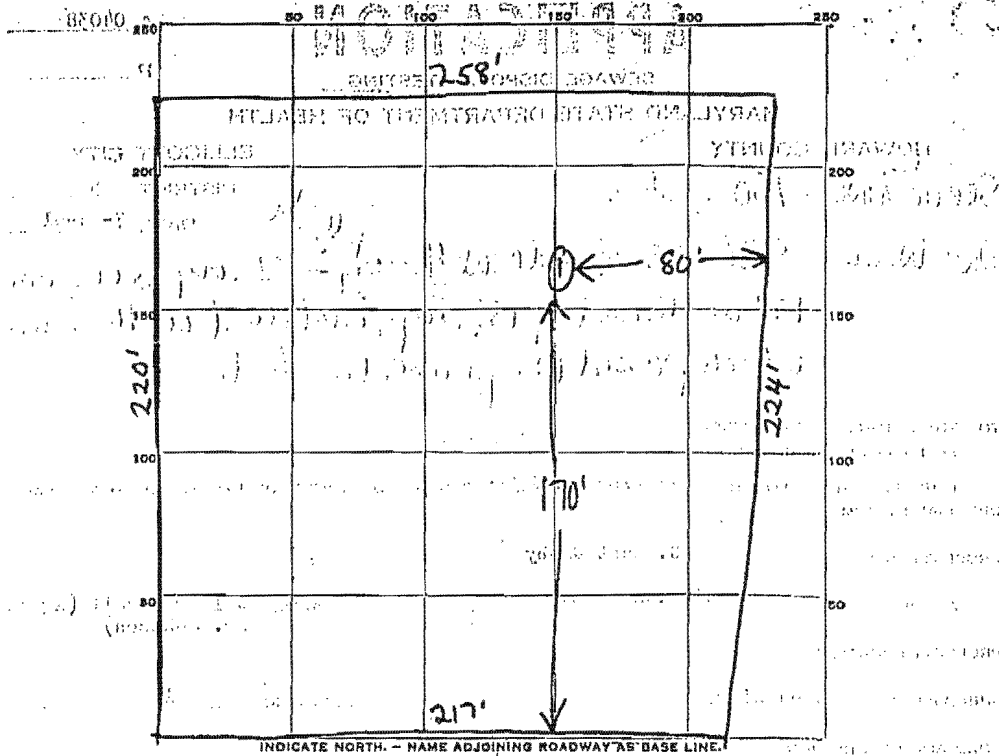

DATE	TEST NO.	DEPTH	PRE-WET		TEST - 1" DROP		TIME
			START	STOP	START	STOP	
7/26/61	1	13'	137	205	205	245	40 min

SOIL AUGER FINDING \_\_\_\_\_  
 TESTED BY Walter J. Lowry  
 REMARKS \_\_\_\_\_  
 ALSO PRESENT Robert S. Behrendt LOT NO. 1