

**HOWARD COUNTY
 PERMIT APPLICATION**

PERMIT NUMBER
 B00157507

Building Address 7394 Hopkins way
Clarksville MD, 21209
 Suite/Apt. #: _____ SDP/WP/Petition #: _____
 Census Tract _____ Subdivision _____
 Section 1 Area _____ Lot 20
 Tax Map _____ Parcel _____ Grid _____
 Zoning _____ Map Coordinates _____ Lot size _____

Property Owner's Name Bhruvash N. Vyas
 Address 7394 Hopkins way
 City Clarksville State MD Zip Code 21029
 Home Phone 301-362-9174 Work Phone 301-902-4439
 Applicant's Name & Mailing Address, (if other than stated hereon):
Mark Krda
86 John St. Westminster MD, 21157
 Phone 410-857-3519 Fax _____

Existing Use Residential Home
 Proposed Use sunroom addition
 Estimated Construction Cost \$ 60,000
 Description of Work Construct new Insulated
Floor on post & pier footings, for
New sunroom addition

Contractor Company Classic Conservatories
 Contact Person Robin Dee
 Address 86 John St.
 City Westminster State MD Zip Code 21157
 License No. _____
 Phone 410-857-3519 Fax _____

Occupant or Tenant _____
 Contact Name _____
 Address _____
 City _____ State _____ Zip Code _____
 Phone _____ Fax _____

Engineer or Architect Company _____
 Contact Person _____
 Address _____
 City _____ State _____ Zip Code _____
 Phone _____ Fax _____

BUILDING DESCRIPTION - COMMERCIAL

BUILDING DESCRIPTION - RESIDENTIAL

Building Characteristics	Utilities
Height: _____	Water Supply: Public _____ Private <input checked="" type="checkbox"/>
No. of stories: _____	Sewage Disposal: Public _____ Private <input checked="" type="checkbox"/>
Gross area, sq. ft. per floor: _____	Electric Yes <input type="checkbox"/> No <input type="checkbox"/> Gas Yes <input type="checkbox"/> No <input type="checkbox"/>
Use group: _____	Heating System: Electric <input type="checkbox"/> Oil <input type="checkbox"/> Natural Gas <input type="checkbox"/> Propane Gas <input type="checkbox"/>
Construction type: Reinforced Concrete _____ Structural Steel _____ Masonry _____ Wood Frame _____ State Certified Modular _____	Sprinkler system: N/A <input type="checkbox"/> Full _____ Partial _____ Other Suppression _____ # of Heads _____

Building Characteristics	Utilities
SF Dwelling <input checked="" type="checkbox"/> SF Townhouse <input type="checkbox"/> Depth _____ Width _____ 1st floor: _____ 2nd floor: _____ Basement: _____ Finished Basement <input type="checkbox"/> Unfinished Basement <input type="checkbox"/> Crawl space <input type="checkbox"/> Slab on Grade <input type="checkbox"/> No. of Bedrooms: _____ Multi-family dwellings: No. of efficiency units: _____ No. of 1 BR units: _____ No. of 2 BR units: _____ No. of 3 BR units: _____ Other Structure: _____ Dimensions: _____ Footings: _____ Roof: _____ State Certified Modular _____ Manufactured Home _____	Water Supply: Public _____ Private _____ Sewage Disposal: Public _____ Private _____ Electric Yes <input type="checkbox"/> No <input type="checkbox"/> Gas Yes <input type="checkbox"/> No <input type="checkbox"/>
	Heating System: Electric <input type="checkbox"/> Oil <input type="checkbox"/> Natural Gas <input type="checkbox"/> Propane Gas <input type="checkbox"/>
	Sprinkler system: N/A <input type="checkbox"/> NFPA #13D _____ NFPA #13R _____ Other: _____

THE UNDERSIGNED HEREBY CERTIFIES AND AGREES AS FOLLOWS: (1) THAT HE/SHE IS AUTHORIZED TO MAKE THIS APPLICATION; (2) THAT THE INFORMATION IS CORRECT; (3) THAT HE/SHE WILL COMPLY WITH ALL REGULATIONS OF HOWARD COUNTY WHICH ARE APPLICABLE THERETO; (4) THAT HE/SHE WILL PERFORM NO WORK ON THE ABOVE REFERENCED PROPERTY NOT SPECIFICALLY DESCRIBED IN THIS APPLICATION; (5) THAT HE/SHE GRANTS COUNTY OFFICIALS THE RIGHT TO ENTER ONTO THIS PROPERTY FOR THE PURPOSE OF INSPECTING THE WORK PERMITTED AND POSTING NOTICES.

Mark R. Krda Jr.
 Applicant's Signature
Permit Spec. / Classic Conservatories
 Title/Company

Mark R. Krda Jr.
 Print Name
12-29-05
 Date

Checks payable to: **DIRECTOR OF FINANCE OF HOWARD COUNTY**
 ** PLEASE WRITE NEATLY AND LEGIBLY. **
 - FOR OFFICE USE ONLY -


AGENCY	DATE	SIGNATURE APPROVAL
Land Development, DPZ		
State Highways		
Building Official		
Dev. Engineering, DPZ		
Health	<u>12/29/05</u>	<u>[Signature]</u>
Fire Protection		
Is Sediment Control approval required prior to issuance? YES <input type="checkbox"/> NO <input type="checkbox"/>		
CONTINGENCY CONSTRUCTION START: <input type="checkbox"/>		
ONE STOP SHOP: <input type="checkbox"/>		

DPZ SETBACK INFORMATION	PROPERTY ID#:
Front: _____	Filing fee \$ _____
Rear: _____	Permit fee \$ _____
Side: _____	Excise tax \$ _____
Side St.: _____	Add'l per. fee \$ _____
All minimum setbacks met? YES <input type="checkbox"/> NO <input type="checkbox"/>	TOTAL FEES \$ _____
Is Entrance Permit required? YES <input type="checkbox"/> NO <input type="checkbox"/>	Sub-total paid \$ _____
Historic District? YES <input type="checkbox"/> NO <input type="checkbox"/>	Balance due \$ _____
Lot Coverage for NewTown Zone _____	Check # _____
SDP/Red-line approval date _____	Validation # _____
	Accepted by _____

85720

VYAS

Lot Number: 20
Block/Section: -
Plat Reference: C.M.P. 3870
Title of Plat: Hallmark, Section One,
Lot 1 thru Lot 47

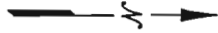

Location Drawing

Scale: 1" = 60'

The plat is of benefit is to a consumer only insofar as it is required by a lender or a title insurance company or its agent in connection with contemplated transfer, financing or refinancing. The plat is not to be relied upon for the establishment or location of fences, garages, buildings, dwellings or other existing or future improvements nor does the plat purport to reflect setbacks or other distances with any specific level of accuracy. The plat does not provide for the accurate identification of property boundary lines, but such identification may not be required for the transfer of title or securing financing or refinancing. The approximate location of the dwelling is shown in relation to the apparent property lines for the property known as

7394 Hopkins Way
Howard County, Maryland

William T. Matthews 4/17/00

Ruxton Design Corporation

8422 Bellona Lane
Suite 300

Towson, Maryland 21204

410-823-5000
410-823-0115fax

rdc@ruxtondesign.com


www.ruxtondesign.com

173-032

Lot 19

Lot 21

Lot 47

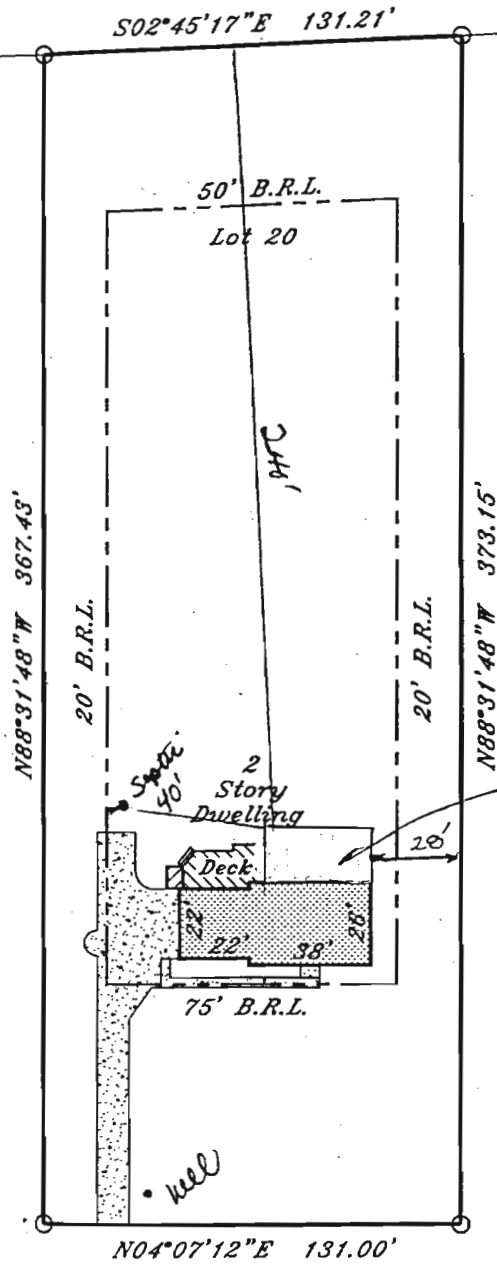

31x16
CONSERVATORY

APPROVED

WALK-THRU BUILDING PERMIT

BP# B00157507 A# 26212

APP. SAN KSB DATE: 12/29/05


DESC. OF WORK: 31 x 16

Conservatory

HOPKINS WAY

4965 wtr

Dwelling lies in Flood Zone
C

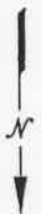

Location Drawing

Scale: 1" = 60'

The plat is of benefit is to a consumer only insofar as it is required by a lender or a title insurance company or its agent in connection with contemplated transfer, financing or refinancing. The plat is not to be relied upon for the establishment or location of fences, garages, buildings, dwellings or other existing or future improvements nor does the plat purport to reflect setbacks or other distances with any specific level of accuracy. The plat does not provide for the accurate identification of property boundary lines, but such identification may not be required for the transfer of title or securing financing or refinancing. The approximate location of the dwelling is shown in relation to the appurtenant property lines for the property known as

7394 Hopkins Way
Howard County, Maryland

William Matthews 4/17/00


Ruxton Design Corporation

8422 Bellona Lane
Suite 300

Towson, Maryland 21204

410-823-5000
410-823-0115 fax

rdc@ruxtondesign.com www.ruxtondesign.com

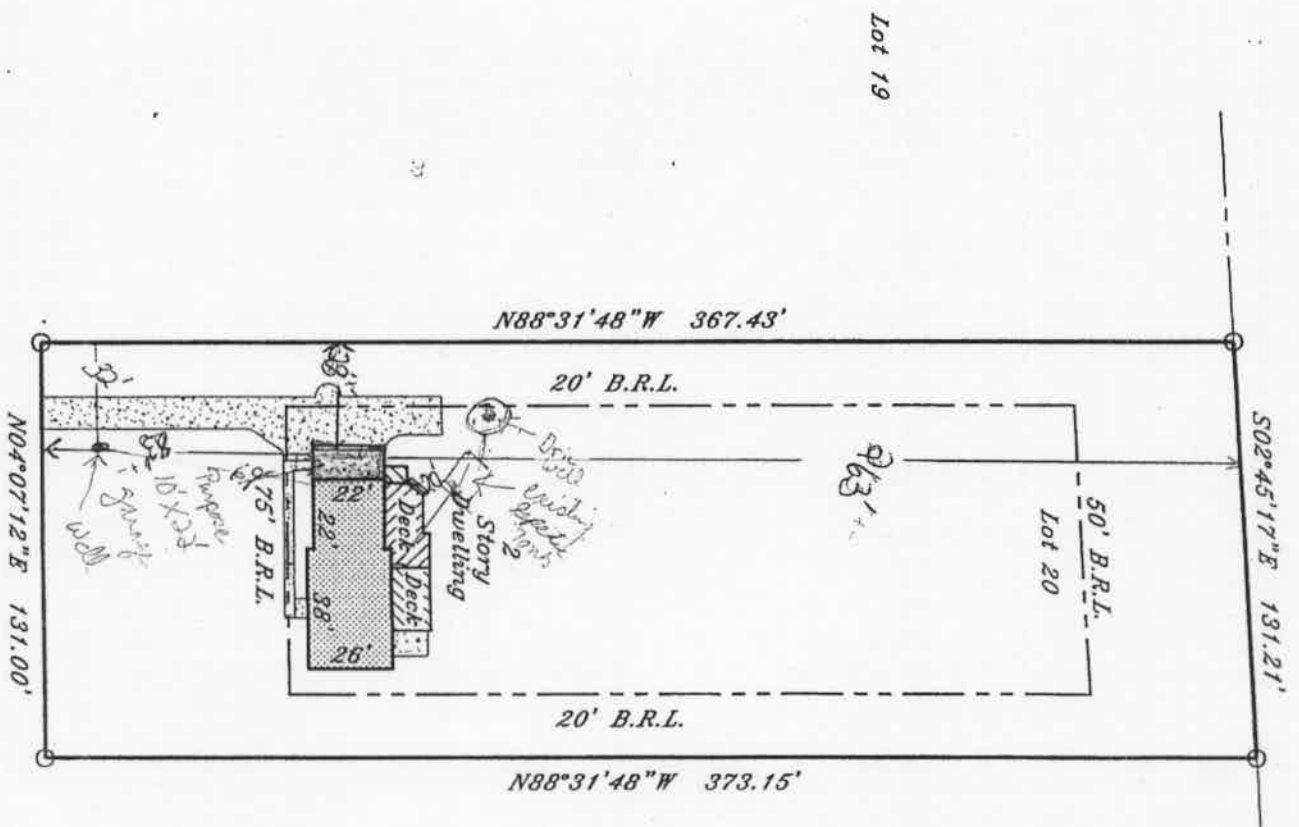

Lot 21

Lot Number: 20
Block/Section: C.M.P. 3870
Plat Reference: Hallmark, Section One,
Title of Plat: Lot 1 thru Lot 47

APPROVED

WALKTHRU BUILDING PERMIT
BP# _____
APP. SAN #8 _____
DESC. OF WORK: 10' x 23'
garage addition
DATE: 9-1-09

HOPKINS WAY

Dwelling lies in Flood Zone C