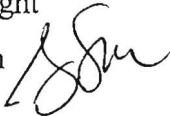


# Memorandum

---

**To:** Carletta McKnight

**From:** Gregory Mellon 

**Date:** 10/2/2002

**Re:** Refund for Friendship Chiropractic Center/Dr. Steven Boesche

---

On September 26, 2002, Dr. Boesche's office paid \$80 fee for a well permit, which has not been issued. The receipt number was 517934. A copy of the receipt is attached. Subsequent to paying for the permit, his existing well was repaired successfully. He no longer needs a well permit, so he has requested a refund. Please send the refund to Friendship Chiropractic Center at the address on the receipt.

Thank you for your assistance in this matter.



HOWARD COUNTY HEALTH DEPARTMENT

W5 17934

DATE 9/26/2002

Received From Friendship Chiropractic Center 410-442-8088  
PO Box 325, W. Friendship MD 21794

CASH  
 CHECK  
NO. 1202

For Well Permits  
13890 Forsythe Rd  
Eighty and 00/100 Dollars

\$ 80.00

Received By May L Buggs

MLB  
OK to refund because applicant does not want a new well. 10/2/02  
JGG

To Mr Mellon,

on 9/25/02 I met w/ George (Easterday) about a well problem on my property @ 13890 Forsythe Rd. we also met w/a Mr Osterman and discussed a site for a new well. with the advise of George I gave Mr Osterman a ck for \$80.00 for a permit. About 1-2 hrs. afterward a well tech. from Easterday opened my existing well and determined that it was sound w/ a good 4 gal/min yield and repaired my circulator jet and foot valve wh/ took care of my water problem. I assumed that Easterday would have notified your office about cancelling the new well. the next day I found that they had not so I called your dept and spoke to Sarah about stopping the permit and having me back the \$80 check. Sarah told me that it had already been deposited. I therefore ask you to formally cancel my request for a permit for a new well @ 13890 Forsythe Rd and mail refund to me at that address.

DR. STEVEN BOESCHE  
[Signature]

9/25/02 10:30

518557-A

**SITE INSPECTION SHEET**

**INDEXED**

OWNER: Steve Boesche PHONE #: 410-442-2217


ADDRESS: 13890 1390 Forsythe Road CONTRACTOR: Easterday

WELL TAG #: \_\_\_\_\_

SUBDIVISION: \_\_\_\_\_ LOT: \_\_\_\_\_ COUNTY #: \_\_\_\_\_

PROPOSAL: Out of water - DRY

**LOCATION DIAGRAM**

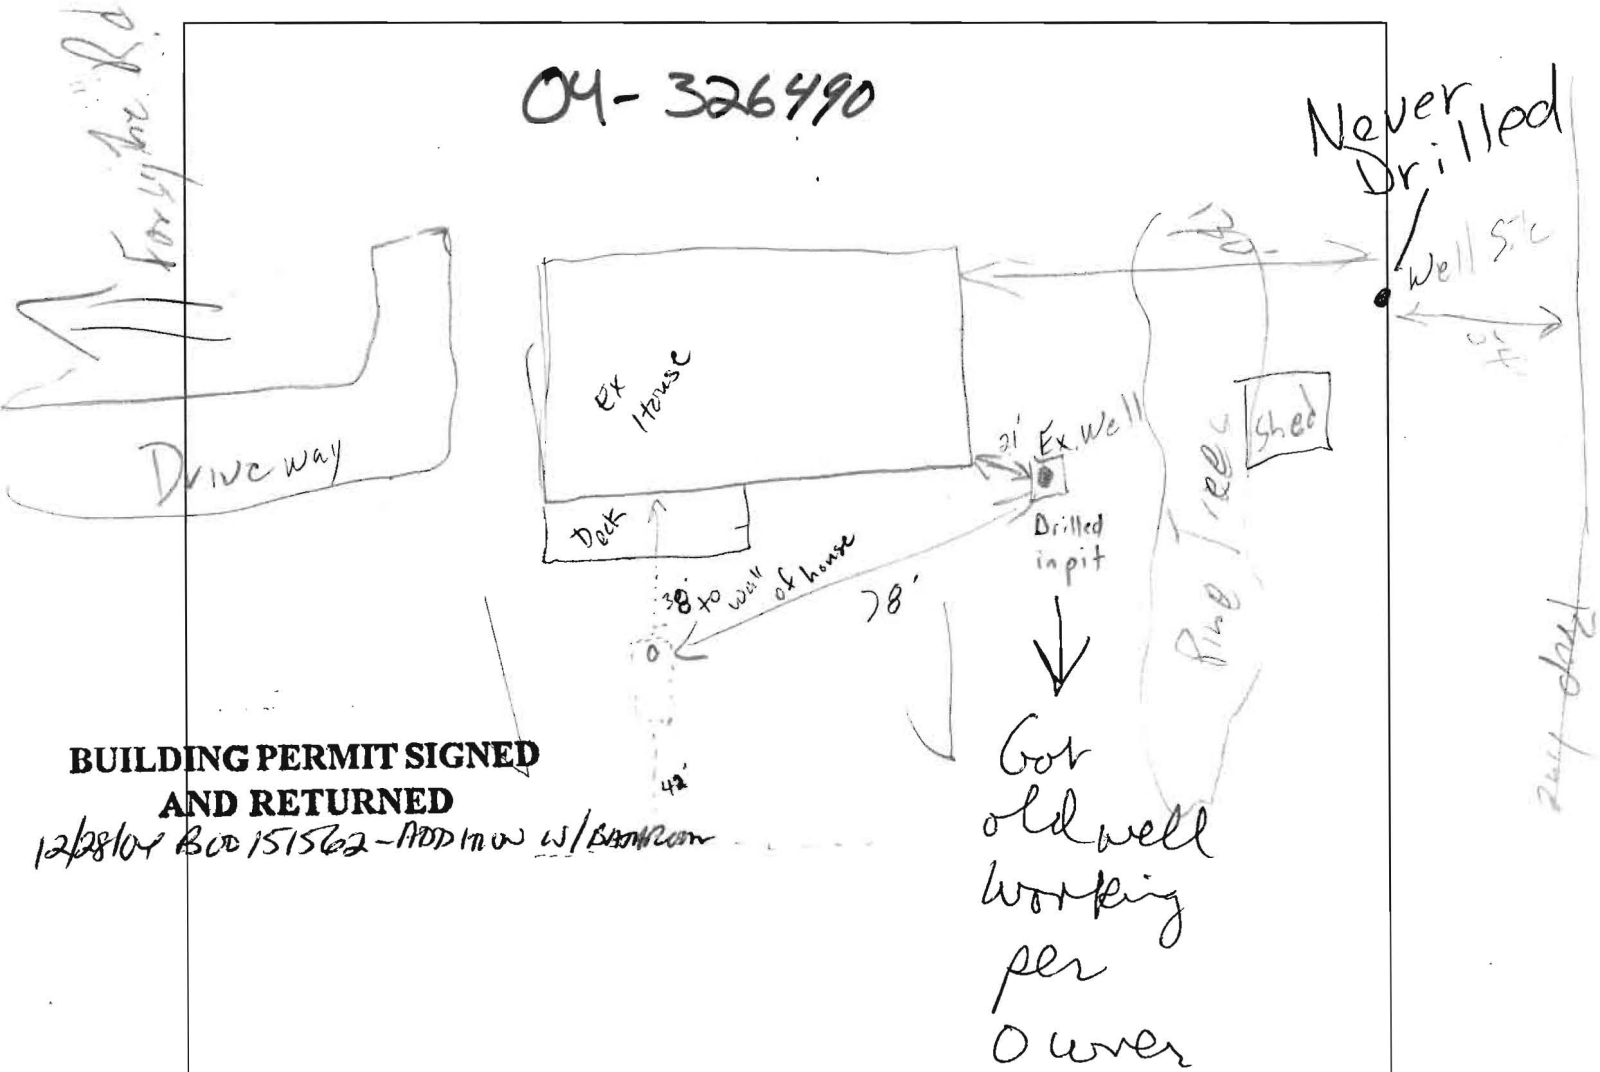

COMMENTS: Replacement well site OK

DATE: 9/25/02 INSPECTOR: Steve Boesche

A518557-A