

7/25/81  
as soon as possible

# PERMIT

Approved: 7/23/81  
L. Kil  
P 31485  
A 31219

SEWAGE DISPOSAL SYSTEM

MARYLAND STATE DEPARTMENT OF HEALTH\*

HOWARD COUNTY

05-391105

ELLICOTT CITY

DISTRICT 5th

DATE 7/13/81

## INDEX

Jack Fyock

IS PERMITTED TO INSTALL X ALTER

ADDRESS 13775 Triadelphia Road, Glenelg, Md. 21737 PHONE 988-9270

SUBDIVISION \_\_\_\_\_ ROAD 13975 Howard Road LOT \_\_\_\_\_

PROPERTY OWNER Clyde H. Brown, Jr.

**BUILDING PERMIT SIGNED**

ADDRESS 13825 Howard Road, Dayton, Md. 21036

**AND RETURNED**

5-13-05 BOWLING - GARAGE

SPECIFICATIONS 3 bedrooms

SEPTIC TANK CAPACITY 1000 GALLONS

DRAIN FIELD \_\_\_\_\_ DEPTH \_\_\_\_\_ FEET, BOTTOM AREA \_\_\_\_\_ SQ. FT.

DEEP TRENCH \_\_\_\_\_ DEPTH \_\_\_\_\_ FEET, BOTTOM AREA \_\_\_\_\_ SQ. FT.

SEEPAGE PITS \_\_\_\_\_ ABSORBENT SIDE-WALL AREA \_\_\_\_\_ SQ. FT.

INLET PIPE \_\_\_\_\_ FT. BELOW ORIGINAL GRADE, MAXIMUM DEPTH \_\_\_\_\_ FT. BELOW ORIGINAL GRADE

EFFECTIVE DEPTH AT \_\_\_\_\_ FT. BELOW ORIGINAL GRADE.

LOCATE DISPOSAL AREA \_\_\_\_\_ FT. FROM \_\_\_\_\_ LOT LINE AND \_\_\_\_\_ FT. FROM \_\_\_\_\_ LOT LINE AS SEEN WHEN FACING LOT FROM

DRAIN FIELDS - 120 sq. ft. bottom area per bedroom. Drain fields to be 3 to 5 ft. deep with 1 1/4 ft. of stone. Run drain fields between perc hole 2 and perc hole 3. Perc hole 3 is located 68 ft. from the right side of lot as seen from the road and 105 ft. from the front lot line. Perc hole 2 is located 208 ft. from the right lot line and 125 ft. from the front lot line.

7/14/81 O.K. to use 92' long & 8' deep 2' wide inlet at trench @ 4 1/2' below original grade in area of high that valley (A) & (B) 5 ft. of gravel and distribution pipe  
PLANS APPROVED BY Raymond Hodges DATE 4/6/81, 7/22/81

COVER NO WORK UNTIL INSPECTED AND APPROVED.

NEITHER THE HOWARD COUNTY COUNCIL NOR THE HEALTH DEPARTMENT IS RESPONSIBLE FOR THE SUCCESSFUL OPERATION OF ANY SYSTEM.

NOTE: IF TRENCH IS USED CALL FOR INSPECTION BEFORE PLACING GRAVEL IN TRENCH.

NOTE: NO DRY WELL SHALL EXCEED 15 FOOT IN DIAMETER.


NOTE: ALL PIPE FROM HOUSE TO DISPOSAL AREA MUST BE CAST IRON.

PERMIT VOID AFTER THREE YEARS.

NOTE: INSTALL STAND PIPE ON SEPTIC TANK AND DRY WELL. STAND PIPES MUST BE 6 INCHES IN DIAMETER. CAST IRON, CONCRETE OR TERRA COTTA ACCEPTED.

\*INSTALLER IS RESPONSIBLE FOR OBTAINING FINAL APPROVAL ON THIS PERMIT.

A 31219

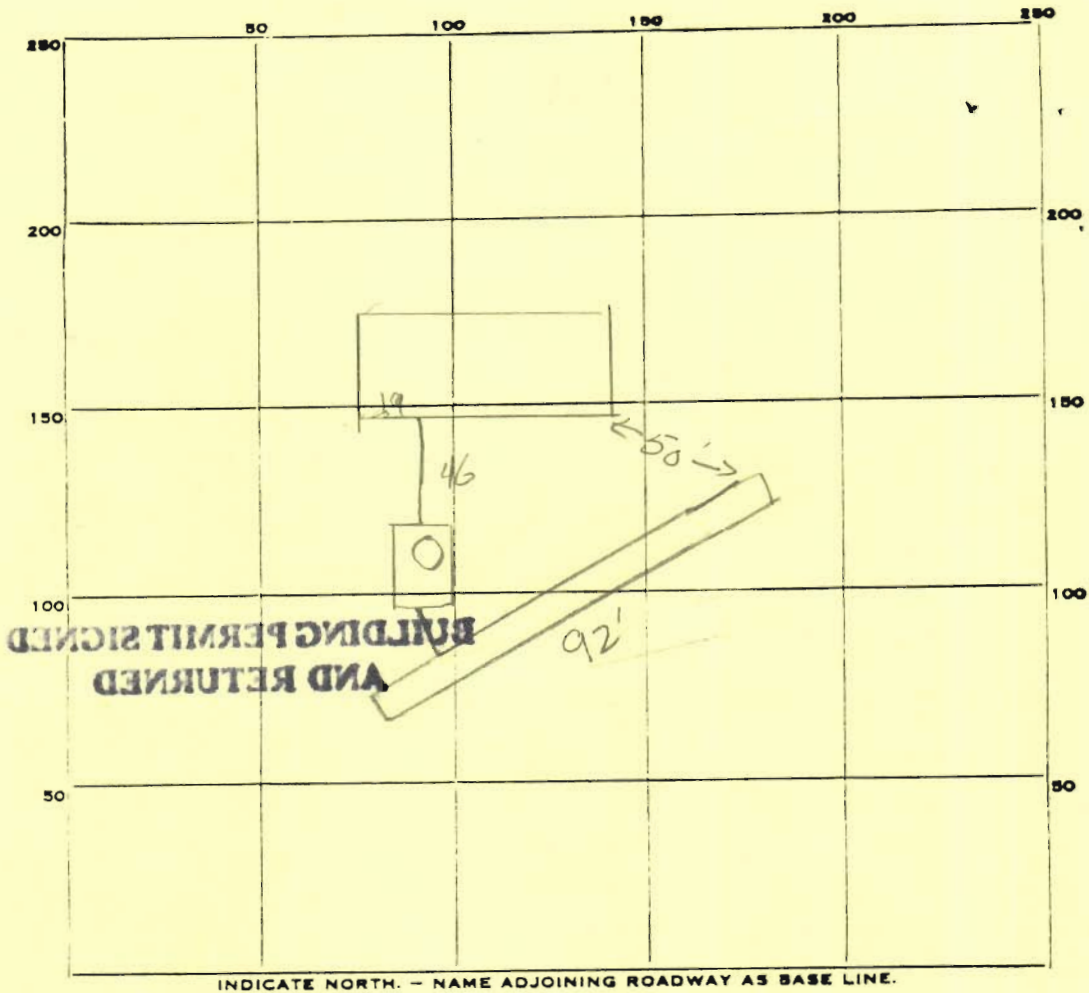

INDICATE NORTH. - NAME ADJOINING ROADWAY AS BASE LINE.

PERMIT CARD \_\_\_\_\_

SEPTIC TANK, LEVEL 1500

CLEANOUTS Manholes

DISTRIBUTION BOX, LEVEL \_\_\_\_\_

TILE FIELD, DEPTH 9 FT. TRENCH WIDTH 2 FT.

GRAVEL DEPTH 5' IN. TOTAL LENGTH 92' FT.

NUMBER OF TRENCHES 1 TOTAL BOTTOM AREA 460  $\phi$

SEEPAGE PITS, INSIDE DIAMETER \_\_\_\_\_ FT. DEPTH BELOW INLET \_\_\_\_\_ FT.

ABSORBENT AREA \_\_\_\_\_ SQ. FT.

REMARKS 1/31/21 OK to add gravel, 1/21/21 cover all work &

DATE SYSTEM APPROVED 1/23/21

INSPECTOR Stephen G. Kiel