

SEQUENCE NO. WRA USE ONLY

STATE OF MARYLAND APPLICATION FOR PERMIT TO DRILL WELL

WRA PERMIT NUMBER

HO-73-3877

(THIS NUMBER IS TO BE PUNCHED IN GOLS. 3-6 ON ALL CARDS)

please print or type

fill in this form completely

DATE RECEIVED 4/16/81 4/27/81 1:30 8 (WRA USE ONLY) 13 OWNER INFORMATION

LAST NAME: Brown, OWNER: H., FIRST NAME: Clyde, STREET OR RFD: Howard Rd., TOWN: Dayton Md., STATE: 21036, ZIP: 21036

LOCATION OF WELL: COUNTY: Howard, SUBDIVISION: 23, SECTION: 44, LOT: 48, NEAREST TOWN: Dayton, MILES FROM TOWN: 9.10


DRILLER INFORMATION: DRILLER'S NAME: Joseph L. Mayne, LICENSE NO.: 238, SIGNATURE: Joseph L. Mayne, DATE: April 6, 81

DIRECTION OF WELL FROM TOWN: TOWN, NEAR WHAT ROAD: Howard, ON WHICH SIDE OF ROAD: WEST, DISTANCE FROM ROAD: 340

WELL INFORMATION: APPROX. PUMPING RATE: 5 GAL. PER MIN, AVERAGE DAILY QUANTITY NEEDED: 750 GAL. PER DAY

USE FOR WATER: HOME (D), FARMING (F), INDUSTRIAL (I), PUBLIC OR PRIVATE WATER COMPANY (P), TEST, OBSERVATION, MONITORING (T). SHOW LOCATION OF WELL WITH AN 'X' IN THIS BOX: 4/27/81 WELL OK SEE OTHER SIDE RH

APPROXIMATE DEPTH OF WELL: 180 FEET, APPROXIMATE DIAMETER OF WELL: 6 INCH, Method of Drilling: BORED (OR AUGERED), JETTED, JETTED & DRIVEN, AIR ROTARY, AIR PERCUSSION, ROTARY (HYDRAULIC), CABLE, REVERSE ROTARY, DRIVE POINT, ROTARY, other

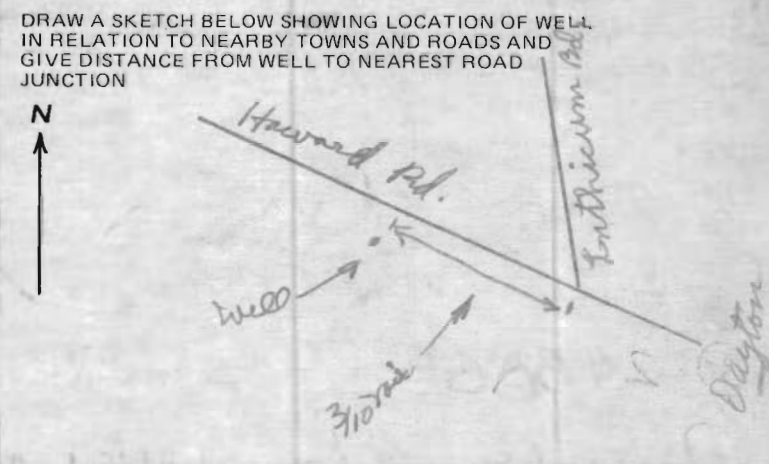

REPLACEMENT OR DEEPEMED WELLS: THIS WELL WILL NOT REPLACE AN EXISTING WELL (N), THIS WELL WILL REPLACE A WELL THAT WILL BE ABANDONED AND SEALED (Y), THIS WELL WILL REPLACE A WELL THAT WILL BE USED AS A STANDBY (S), THIS WELL WILL DEEPEM AN EXISTING WELL (D)


NOT TO BE FILLED IN BY DRILLER HEALTH DEPARTMENT APPROVAL. COUNTY NAME: Howard, COUNTY NO.: 21036

Not to be filled in by driller (WRA USE ONLY): APPROP. PERMIT NUMBER: GAP, FORCE INITIALS IN BOX, CONDITIONS

EHA SIGNATURE: Frank Skinner, Sanitarian, STATE HEALTH SIGNATURE: Frank Skinner, DATE: 4/13/81, NORTH GRID: S12, EAST GRID: 0799, ELEV. (FT.): 000

SPECIAL CONDITIONS (WRA USE ONLY)

HEALTH

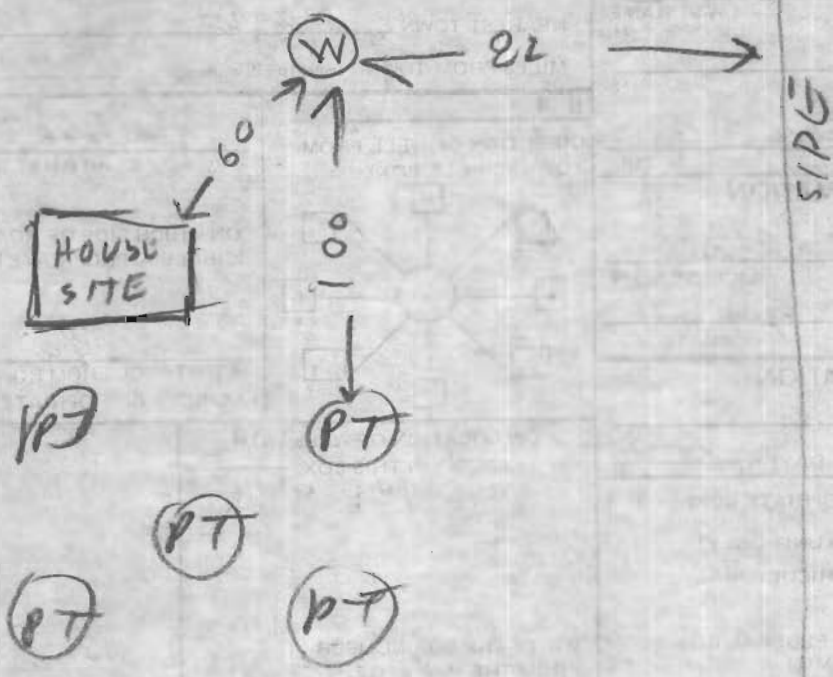

- ① 55 FT CASING 1 FT OUT OF GROUND
- ② 40 FT OPEN HOLE
- ③ 24 BAGS
- ④ WELL OK

4/27/81
 R. HODGES

