


A/P _____

TP # 16
 Br Org Im 0-16"
 Red/Br SILT Im 16"-3'
 Red/Br SILT 3'-6'
 Red/TAN SAND (FINE) 6'-8'
 TAN SAND (FINE) 8'-13'

TP # 17
 Br Org Im 0-16"
 Br SILT Im ROCK FRAGS 10% 16"-6"
 TAN/YELLOW SAND (FINE) 6'-13' 6"

TP # 18
 Br Org Im 0-16"
 Br SILT Im 16"-4'
 TAN/YELLOW SAND (FINE) 4'-13'

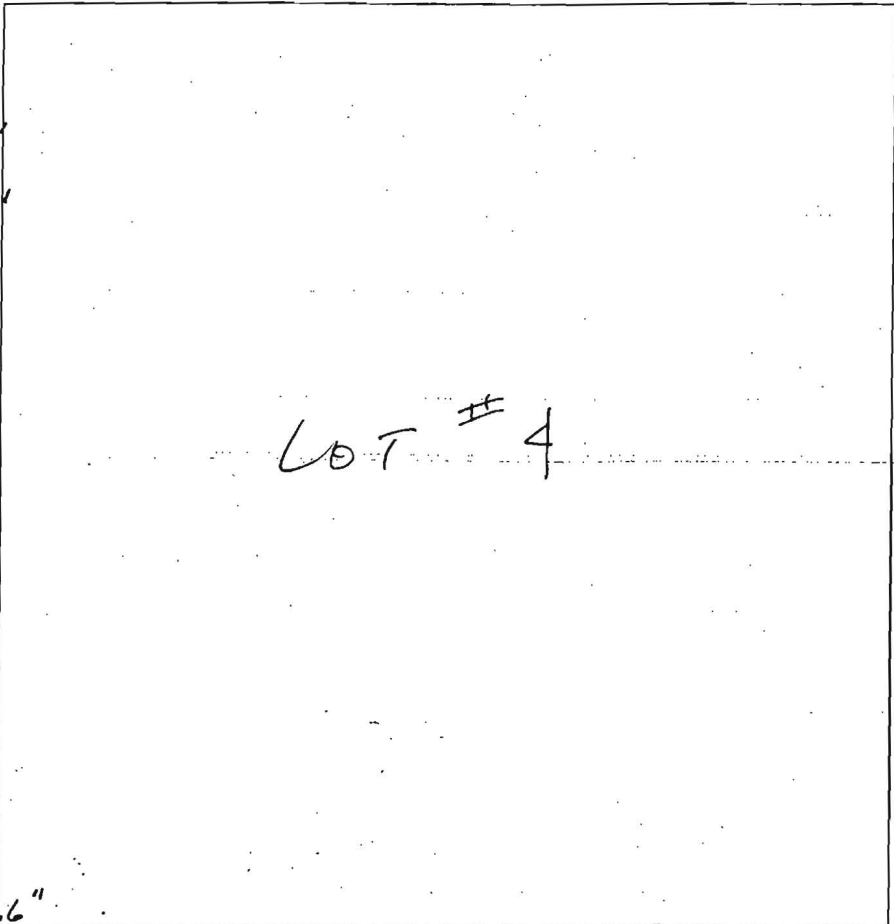

TP # 19
 Br Org Im 0-16"
 Br SILT 16"-3'
 TAN SAND (FINE) 3'-11'

TP # 20
 Br Org Im 0-16"
 Red/Br SILT Im 16"-3'
 YELLOW/TAN SAND (FINE) 3'-6"
 LT. TAN SAND (FINE) 6'-14'

DATE	TEST #	DEPTH	START	BREAK 1" DROP	STOP 2" DROP	TIME OF 2nd INCH	P/F/H	
10/26/04	# 16	13'		VISUAL			P	
	# 17	7' 13'-6"	12:08	12:11	12:14	3 min	P	
	# 18	5' 13'	12:15	12:17	12:21	4 min	P	
	# 19	* REFER TO SOIL EVALUATION BY						
	# 20	14'	COUNTY PERSONNEL DATA FOR RESULTS OF TEST.					
		↑ VISUAL						

REMARKS _____
 SANITARIAN R. Sheeley BACKHOE Acc OTHERS _____
 TEST HOLES USED IN SDA _____ AVG. PERC TIME _____ SQ. FT/BR _____
 TRENCH WIDTH _____ INLET DEPTH _____ MAX. BOT DEPTH _____ EFFECTIVE SW _____