

3/22/73 2-12' holes 50 ft. apart

APPLICATION

A 07537

SEWAGE DISPOSAL TESTING

P _____

MARYLAND STATE DEPARTMENT OF HEALTH

HOWARD COUNTY

ELLICOTT CITY

DISTRICT 5

DATE 10-7-63

Try well 11ft. dia. by 11ft. deep below the inlet located 335 ft. from the front property line and 155 ft. from the left side property line as seen when facing the lot from Howard Rd. Place system in area tested

750 gal. septic Tank

TO: THE COUNTY HEALTH OFFICER
ELLICOTT CITY, MARYLAND

I, HEREBY, APPLY FOR THE NECESSARY TESTS IN ORDER TO CONSTRUCT (OR RECONSTRUCT) A SEWAGE DISPOSAL SYSTEM.

PROPERTY OWNER Norothy Jones

ADDRESS Howard Rd. Dkgt PHONE _____

PROPERTY LOCATION:

SUBDIVISION _____ LOT NO. _____

ROAD AND DESCRIPTION Howard Rd - approx 3/4 mile from Luthicum Rd on right - lot borders Whitehurst's property

OCCUPANT _____ PHONE _____

PERSON TO CONSTRUCT SYSTEM _____

ADDRESS _____ PHONE _____

SIZE OF LOT 2.2 acre TYPE BLDG. 3 NUMBER OF BEDROOMS _____

IF NOT SINGLE RESIDENCE DESCRIBE _____

SIGNATURE OF APPLICANT Mrs. Mitchell G. Seal - Box 294 Waterloo Rd. HOS-2943


APPROVED BY J. Fanning FOR Paywell DATE 12-3-63

REJECTED BY _____ FOR _____ DATE _____

HOLD PENDING FURTHER TESTS _____ DATE _____

REASONS FOR REJECTION OR HOLDING _____

THIS IS NOT A PERMIT

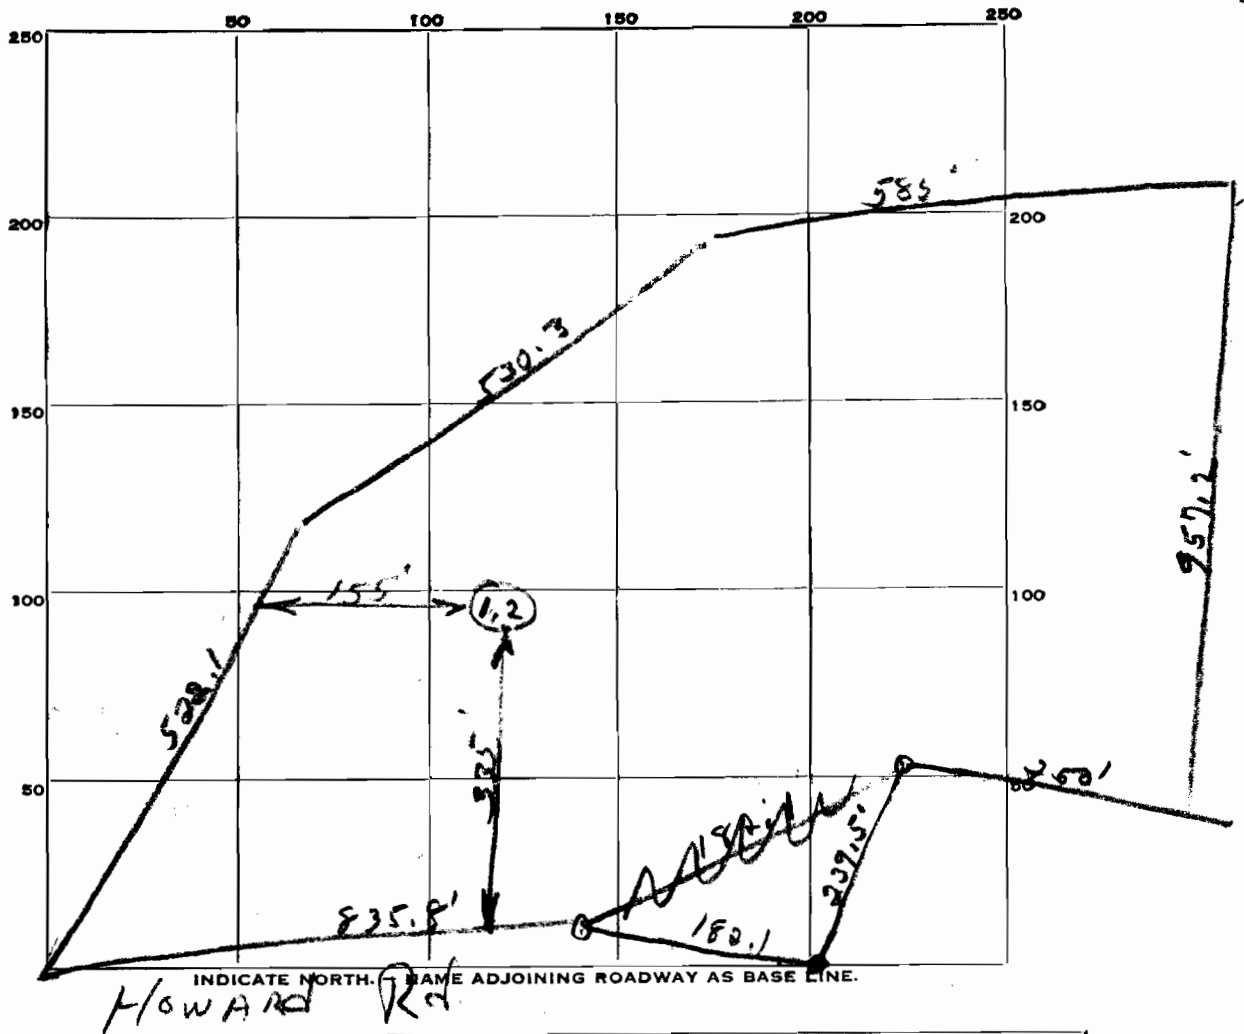

DATE	TEST NO.	DEPTH	PRE-WET		TEST - 1" DROP		TIME
			START	STOP	START	STOP	
12-3-63	1	9	1:29	1:35	1:38	1:51	12 min
1	2	3	1:30	1:32	1:32	1:38	6 min

SOIL AUGER FINDING _____

TESTED BY _____

REMARKS _____

ALSO PRESENT P. W. Ketchum LOT NO. _____