

APPLICATION

PERCOLATION TESTING

A 43384
P _____
DISTRICT R
DATE 12/19/88

HOWARD COUNTY HEALTH DEPARTMENT
BUREAU OF ENVIRONMENTAL HEALTH
P.O. BOX 476 ELLICOTT CITY, MARYLAND 21043
TELEPHONE: 461-9933

TO: THE COUNTY HEALTH OFFICER
ELLICOTT CITY, MARYLAND

I, HEREBY, APPLY FOR THE NECESSARY TEST IN ORDER TO CONSTRUCT (OR RECONSTRUCT) A SEWAGE DISPOSAL SYSTEM.

PROPERTY OWNER Oakton Associates, Inc. Martin II, Inc

ADDRESS 1200 18th Street, NW, Washington, DC 20036 PHONE (202) 457-8637

PROSPECTIVE BUYER Anchor Capital Group

ADDRESS 133 Defense Highway, Suite 206 PHONE (301) 261-8727
Annapolis, MD 21401

PROPERTY LOCATION:

SUBDIVISION Cabin Branch Farm LOT NO. 2.8

ROAD AND DESCRIPTION Rte 94 (Ellicott Road) Approximately 2 miles North East
from Damascus Road (3228 Starting Gate Court)

TAX MAP 13 PARCEL # 42 BLDG. PERMIT. SIGNED AND RETURNED 10/7/93 BLDG. PERMIT. SIGNED AND RETURNED 10/7/93 SFD

SIZE OF LOT 3 acres TYPE BLDG. Serial # 50820 - detached Garage Serial # 50814 Single Family 3 Bedrm
(SINGLE FAMILY DWELLING OR COMMERCIAL)

THE SYSTEM INSTALLED UNDER THIS APPLICATION IS ACCEPTABLE ONLY UNTIL PUBLIC FACILITIES BECOME AVAILABLE. I FULLY UNDERSTAND THE FEE CONNECTED WITH THE FILING OF THIS PERC TEST APPLICATION IS NON-REFUNDABLE UNDER ANY CIRCUMSTANCES. I ALSO AGREE TO COMPLY WITH ALL M.O.S.H.A. REQUIREMENTS IN TESTING THIS LOT. James Hanna
(SIGNATURE OF APPLICANT)

APPROVED BY _____ FOR _____ DATE _____

REJECTED BY _____ FOR _____ DATE _____

HOLD PENDING FURTHER TESTS _____ DATE _____



REASONS FOR REJECTION OR HOLDING 4/20/89 Perc OK Hold for Plat R/H

HD-216

THIS IS NOT A PERMIT

Lot 9
43384

SOIL PROFILE

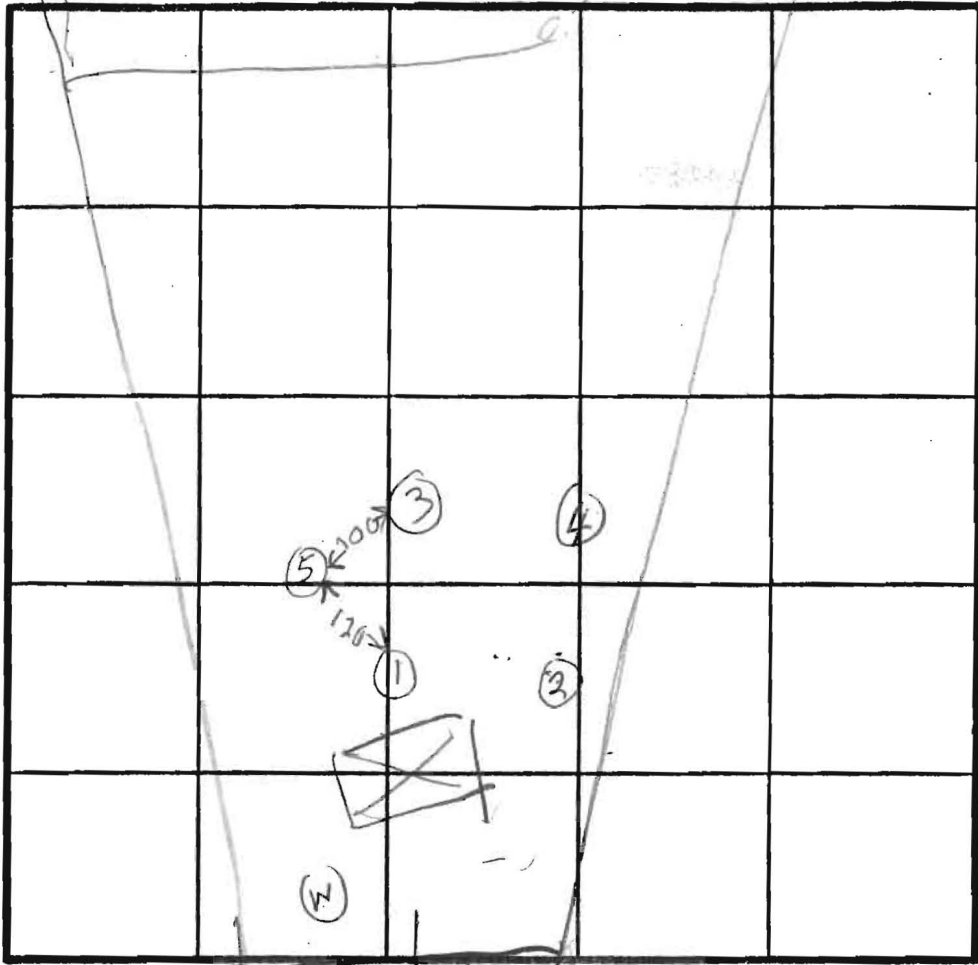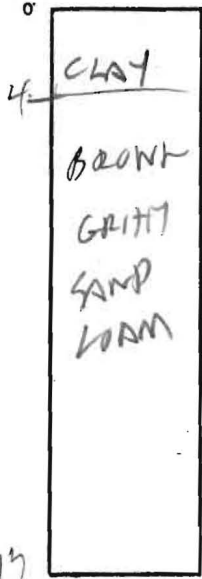


INDICATE NORTH - NAME ADJOINING ROADWAY AS BASE LINE.

ROAD



W/ST 4"
X 10 MIN

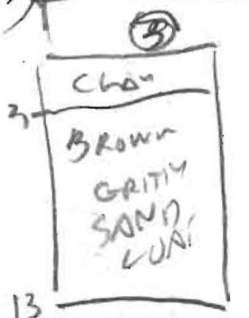


DATE	TEST NO.	DEPTH	PRE-WET		TEST - 1" DROP		TIME
			START	STOP	START	STOP	
4/20/89	10	7	1004	1013	1013	133	20
	15	4	1005	1013	1013	1037	24
4/21/89	14	13	OK			113	
	25	5	1011	1018	1018	1020	2
	26	13	OK				
	35	5	1015	1015	1015	1017	2
	36	13	OK				
	44	13 1/2	WATER		12 FT	UNSAT	
	51	11 1/2	OK				

REMARKS: Holes 1, 2, 3, 4 dug on stake. Hole 5 Pefferend

TYPE OF SOIL _____
TESTED BY B. Ho ALSO PRESENT JAMIE ROCKY JIM


Plot Cogo File: A:\2153

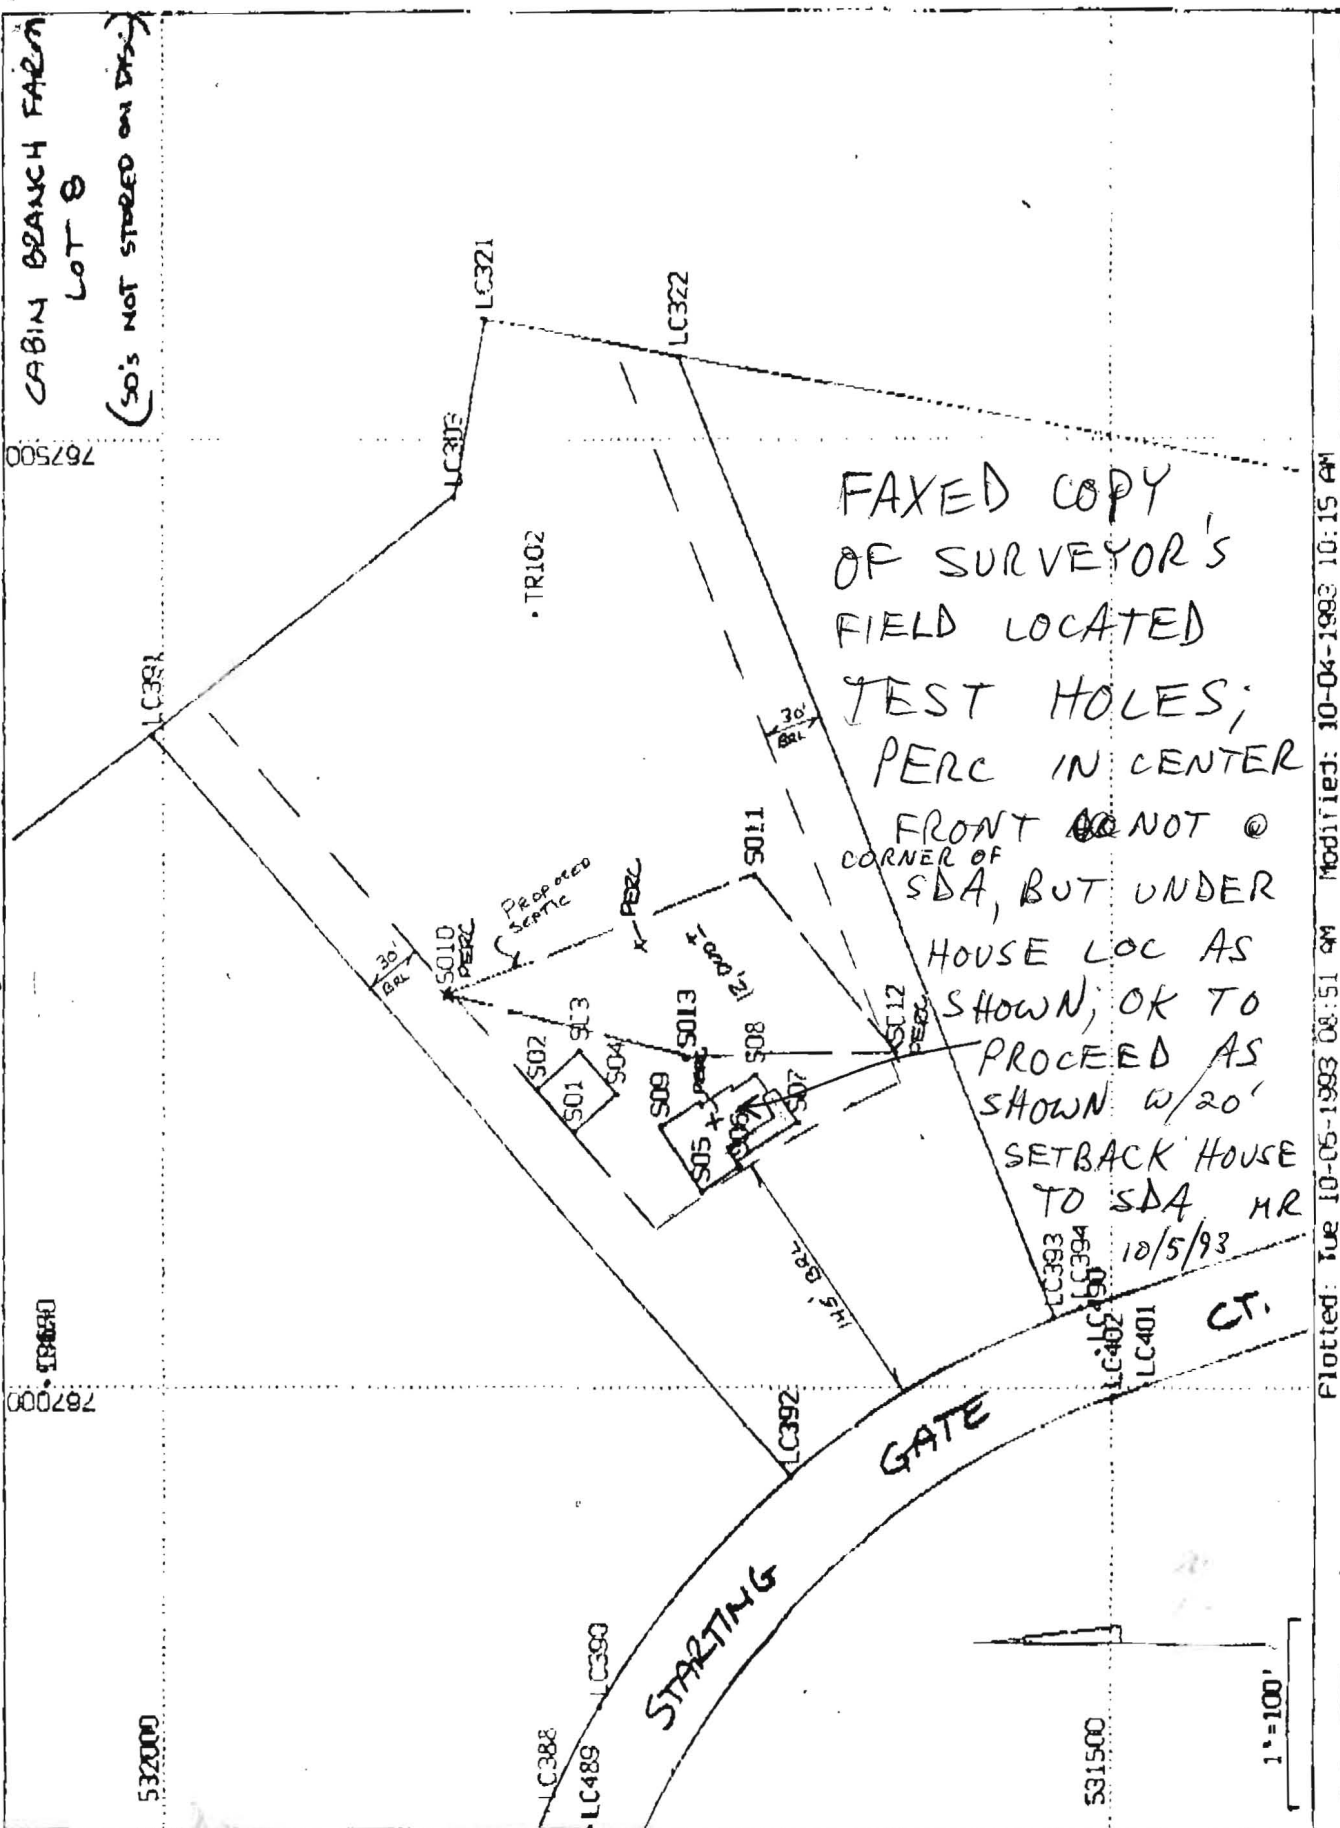

FAXED COPY
OF SURVEYOR'S
FIELD LOCATED
TEST HOLES;
PERC IN CENTER
FRONT ~~IS~~ NOT @
CORNER OF
SDA, BUT UNDER
HOUSE LOC AS
SHOWN, OR TO
PROCEED AS
SHOWN w/20'
SETBACK HOUSE
TO SDA. MR
10/5/93

Plotted: Tue 10-06-1993 08:51 AM Modified: 10-04-1993 10:15 AM

Handwritten notes: 842648, HLEN DPT.

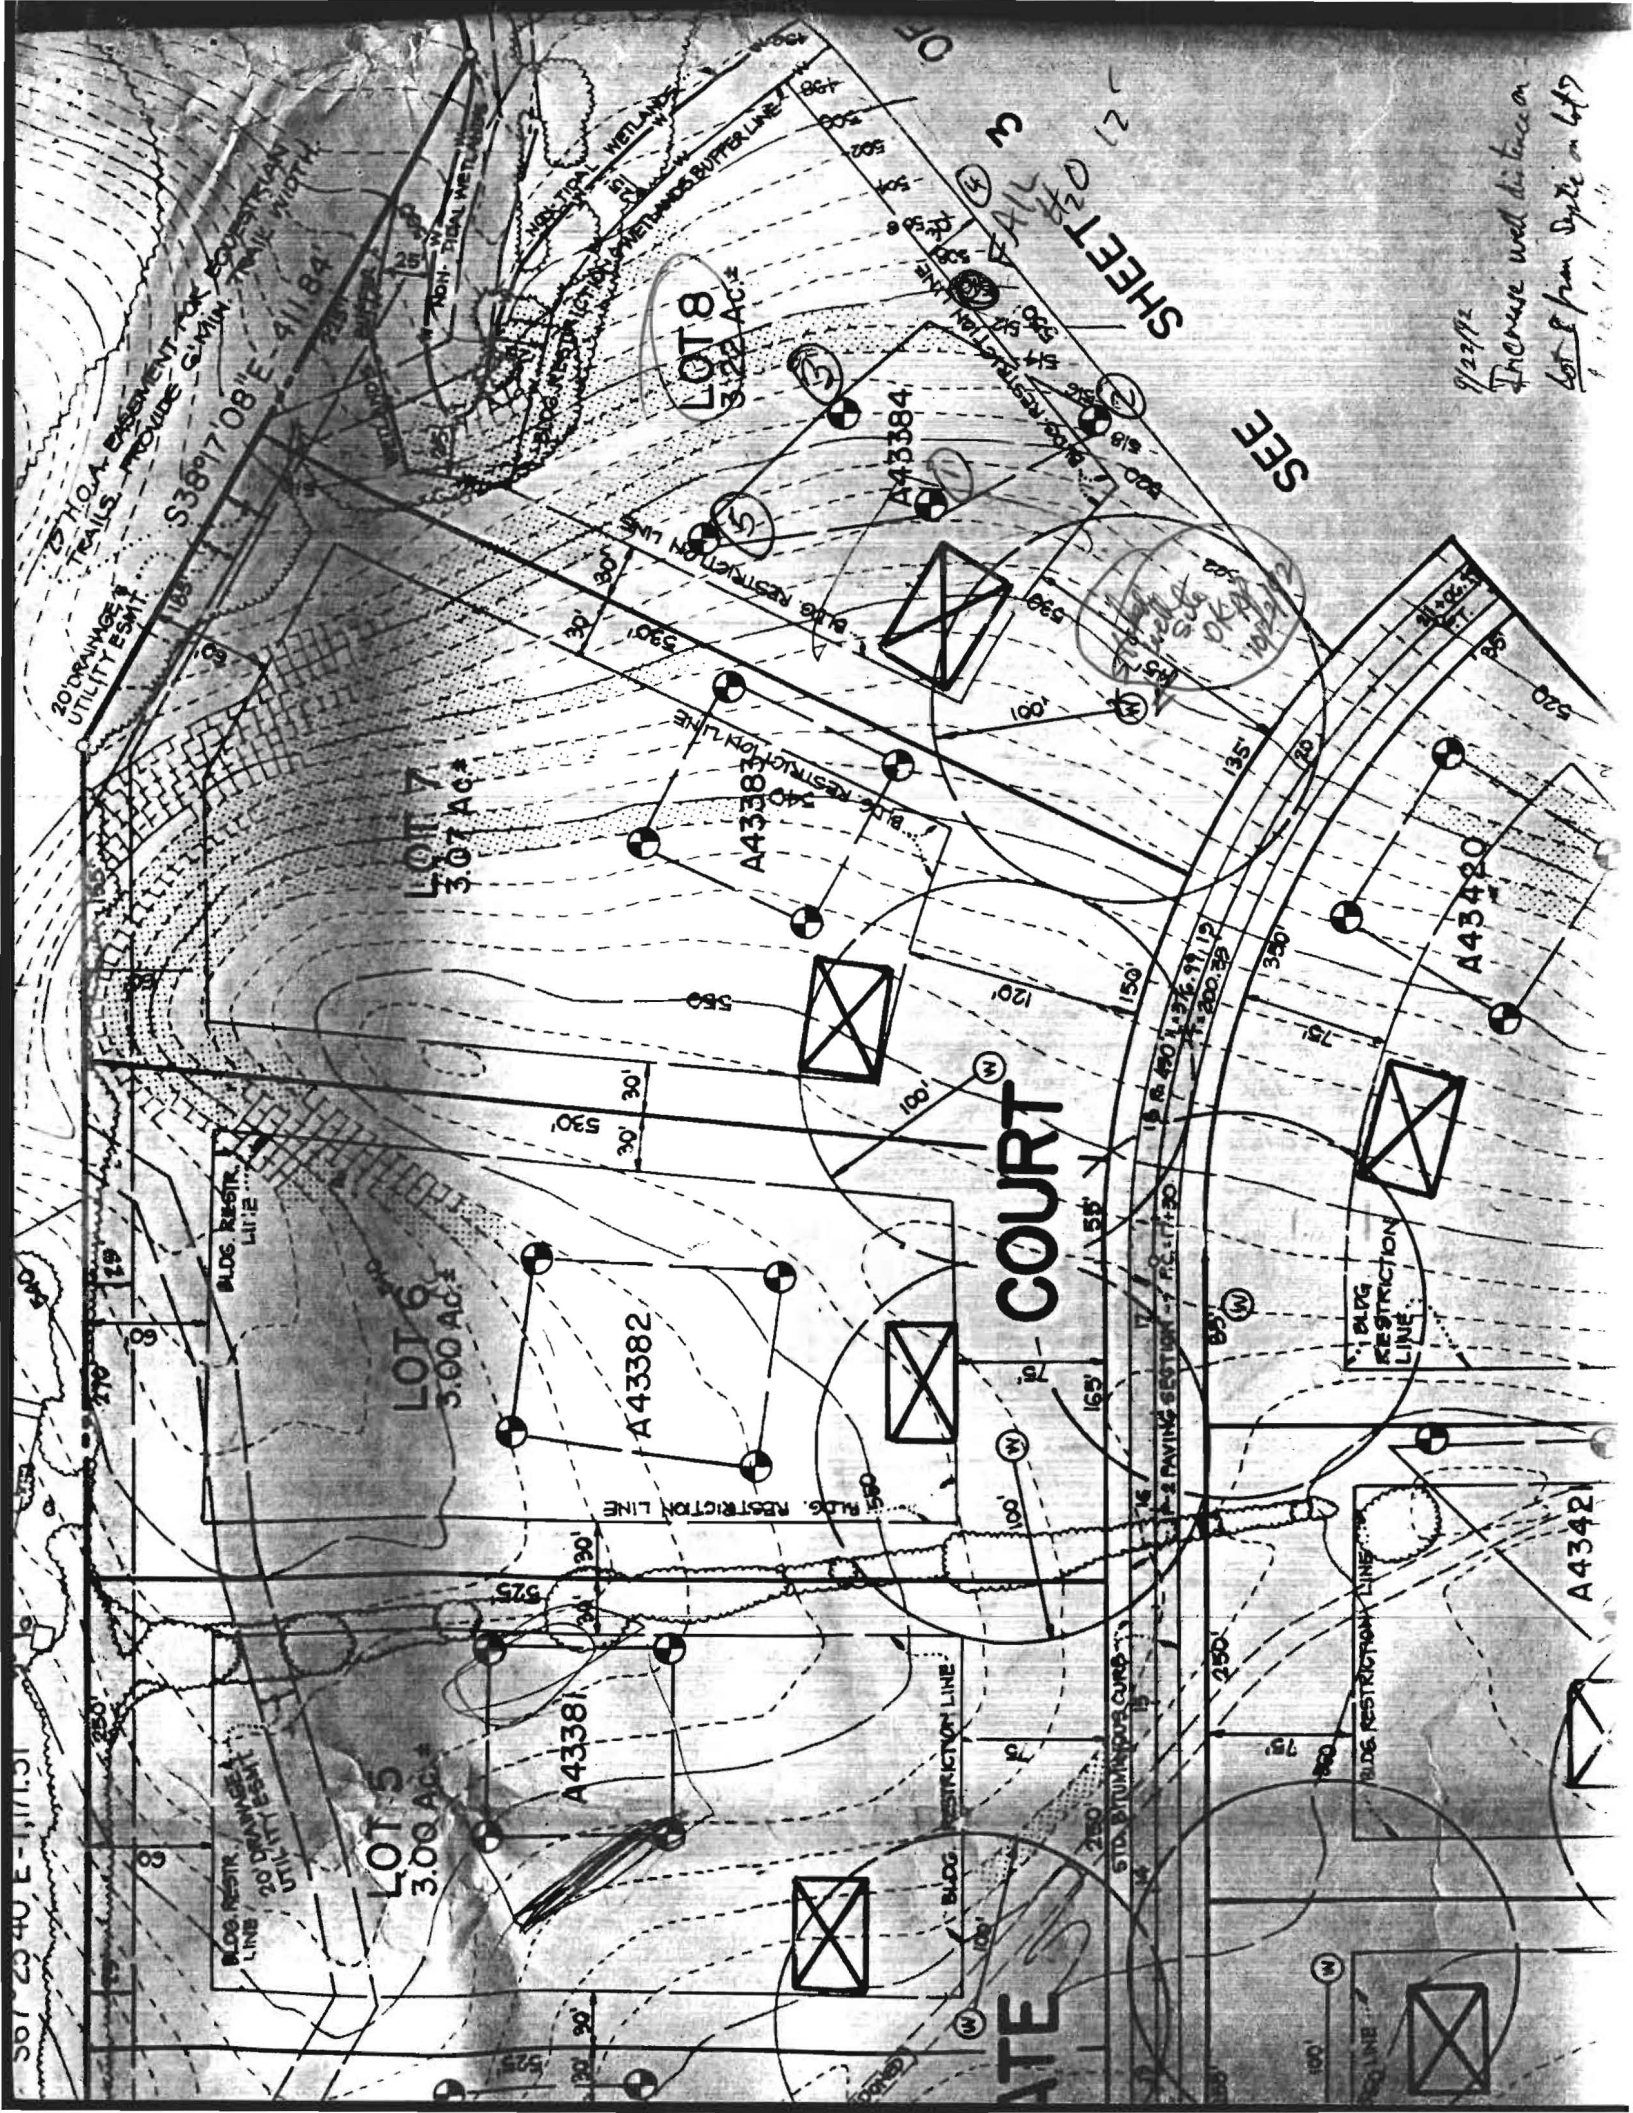

S07 29 40' E - 1171.31'

20' DRAINAGE UTILITY ESM'T

H.O.A. EASEMENT FOR EQUINE
 TRAILS ROADS 6' MIN. TRAIL WIDTH
 S36°17'08" E - 411.84'

LOT 5
 3.00 AC ±

LOT 6
 3.00 AC ±

LOT 7
 3.07 AC ±

LOT 8
 3.22 AC ±

COURT

ATE

STD. 8" MIN. CURB

PAVING SECTORS - 8' x 12' - 30'

15' x 40' x 26' 7 1/2'

11' x 200' ±

135'

120'

150'

175'

250'

BUDG. RESTRICTION LINE

BUDG. RESTRICTION LINE

922712

Increase well distance on lot 8 from 50' to 60'

SEE SHEETS 21, 22, 23

SEE

A4342

A43420

A43384

A43383

A43382

A43381

BUDG. RESTR. LINE

BUDG. RESTR. LINE

BUDG. RESTRICTION LINE

BUDG. RESTRICTION LINE

