

4-13 Lales

Fill out in duplicate
Make 10.000 copies available:
Howard County Health Dept. - San

APPLICATION

A 23250

SEWAGE DISPOSAL TESTING

P _____

Recorded
1974

STATE OF MARYLAND - DEPARTMENT OF HEALTH AND MENTAL HYGIENE

DISTRICT 5th

HOWARD COUNTY HEALTH DEPARTMENT
ENVIRONMENTAL HEALTH SERVICES

DATE 5-11-76

P. O. BOX 476, ELLICOTT CITY, MARYLAND 21043
TELEPHONE: 465-5000, EXT. 356

Files - CM 671
Index - 374

6/11/76
4.30 - 1st
No. Test Ac. Bd
3/1/74

TO: THE COUNTY HEALTH OFFICER
ELLICOTT CITY, MARYLAND

I, HEREBY, APPLY FOR THE NECESSARY TEST IN ORDER TO CONSTRUCT (OR RECONSTRUCT) A SEWAGE DISPOSAL SYSTEM.

PROPERTY OWNER A. Leo + Barbara H. Howard, Sr

ADDRESS 4851 Ten Oaks Rd, Duxton, Md. PHONE 988-9208
351-354
Mrs. Howard

PROPERTY LOCATION:

SUBDIVISION none LOT NO. none

ROAD AND DESCRIPTION Howard Rd to Right of way to A. Leo Howard, Sr property.

SIZE OF LOT 1 acre TYPE BLDG. 3 bedroom home
NUMBER OF BEDROOMS

IF NOT SINGLE RESIDENCE DESCRIBE n/a (single)

THE SYSTEM INSTALLED UNDER THIS APPLICATION IS ACCEPTABLE ONLY UNTIL PUBLIC FACILITIES BECOME AVAILABLE

SIGNATURE OF APPLICANT A. Leo Howard, Sr Barbara H. Howard

APPROVED BY _____ FOR _____ DATE _____
(KIND OF SYSTEM)

REJECTED BY _____ FOR _____ DATE _____
(KIND OF SYSTEM)

HOLD PENDING FURTHER TESTS C. B. Heath DATE 6/11/76

REASONS FOR REJECTION OR HOLDING _____

THIS IS NOT A PERMIT

APPLICATION

A 23250

P _____

SEWAGE DISPOSAL TESTING

STATE OF MARYLAND - DEPARTMENT OF HEALTH AND MENTAL HYGIENE

HOWARD COUNTY HEALTH DEPARTMENT
ENVIRONMENTAL HEALTH SERVICES
P. O. BOX 476, ELLICOTT CITY, MARYLAND 21043
TELEPHONE: 465-5000, EXT. 356

DISTRICT 5th

DATE 5-11-76

TO: THE COUNTY HEALTH OFFICER
ELLICOTT CITY, MARYLAND

I, HEREBY, APPLY FOR THE NECESSARY TEST IN ORDER TO CONSTRUCT (OR RECONSTRUCT) A SEWAGE DISPOSAL SYSTEM.

PROPERTY OWNER A. Leo and Barbara H. Howard, Jr.

ADDRESS 4851 Ten Cakes Rd, Dayton, Md PHONE 988-9208

PROPERTY LOCATION:

SUBDIVISION none LOT NO. none

ROAD AND DESCRIPTION Howard Rd to Right-of-way to the
A. Leo Howard, Sr property

SIZE OF LOT one acre TYPE BLDG. 3 bedroom home
NUMBER OF BEDROOMS

IF NOT SINGLE RESIDENCE DESCRIBE N/A (single)

THE SYSTEM INSTALLED UNDER THIS APPLICATION IS ACCEPTABLE ONLY UNTIL PUBLIC FACILITIES BECOME AVAILABLE

SIGNATURE OF APPLICANT x A Leo Howard Jr Barbara H. Howard

APPROVED BY G Keller FOR Sept 78 DATE 10/78
(KIND OF SYSTEM)


REJECTED BY _____ FOR _____ DATE _____
(KIND OF SYSTEM)

HOLD PENDING FURTHER TESTS G Keller DATE 8/78

REASONS FOR REJECTION OR HOLDING _____

P.M. -> Hold (300 sufficient tests done C.B.)
(4/15/77 -> Hold for certified holes of G Keller; house
P.M. site, + water well tests, and complete elevations of lot
Hold for Mr. C. Mellison

THIS IS NOT A PERMIT

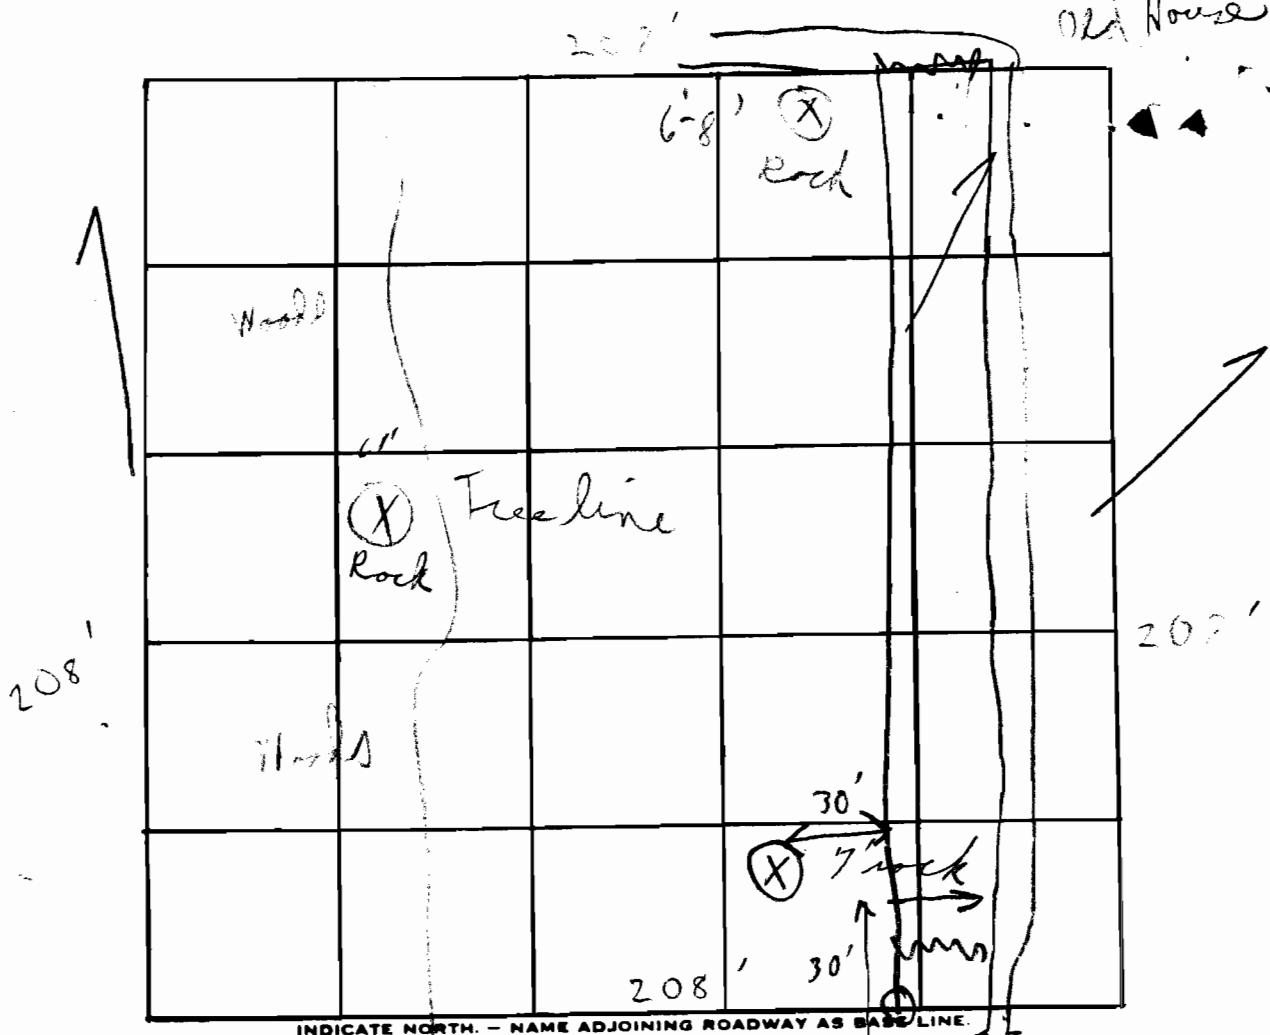


INDICATE NORTH. - NAME ADJOINING ROADWAY AS BASE LINE.

DATE	TEST NO.	DEPTH	PRE-WET		TEST 1" DROP		Road TIME
			START	STOP	START	STOP	
6/1/76		S	:	:	:	:	
		D	:	:	:	:	
		S	:	:	:	:	
		D	:	:	:	:	
		S	:	:	:	:	
		D	:	:	:	:	
			V wood				
							Rock shale

REMARKS 6/1/76 S Open field + woods Notes Hold for
No tests 6/1/76 C.B.S. further Test.
 TYPE OF SOIL _____
 TESTED BY _____ ALSO PRESENT: W. Fyock + Howard

10/19/78

GLK

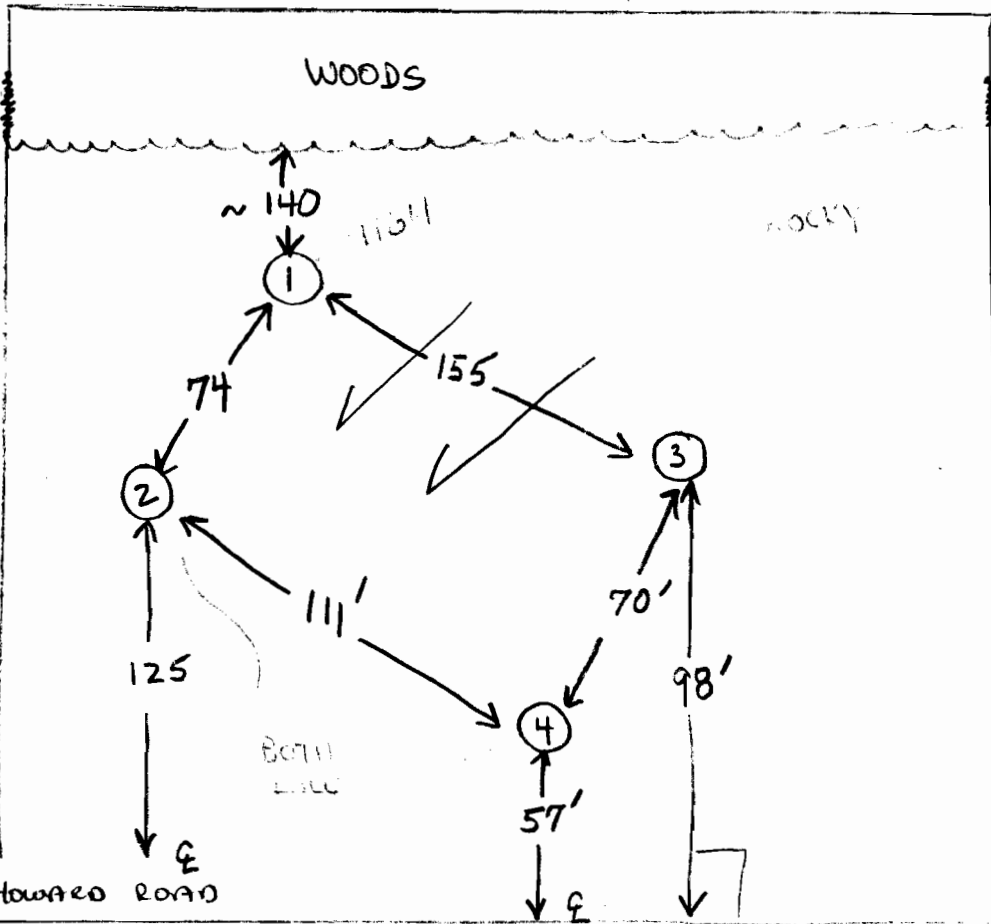

SOIL PROFILE

Hole ③ ④

06 _____
 5 CLAYEY
 CLAYEY LOAM
 W/WEATHERED SHALE
 SMALL AMTS.
 12-12½ _____

Hole ②

06 CLAYEY
 3 _____
 SANDY
 LOAM W/
 SOME CLAY


13½ _____

Hole ①

06 _____
 3 CLAYEY
 HARD-PACKED
 FINE-GRAINED
 SANDY LOAM
 (WHITE)


14 _____

Spotty soil - recommend trenches.

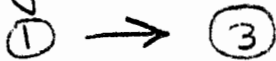

Elevation

HIGH → LOW 3' max

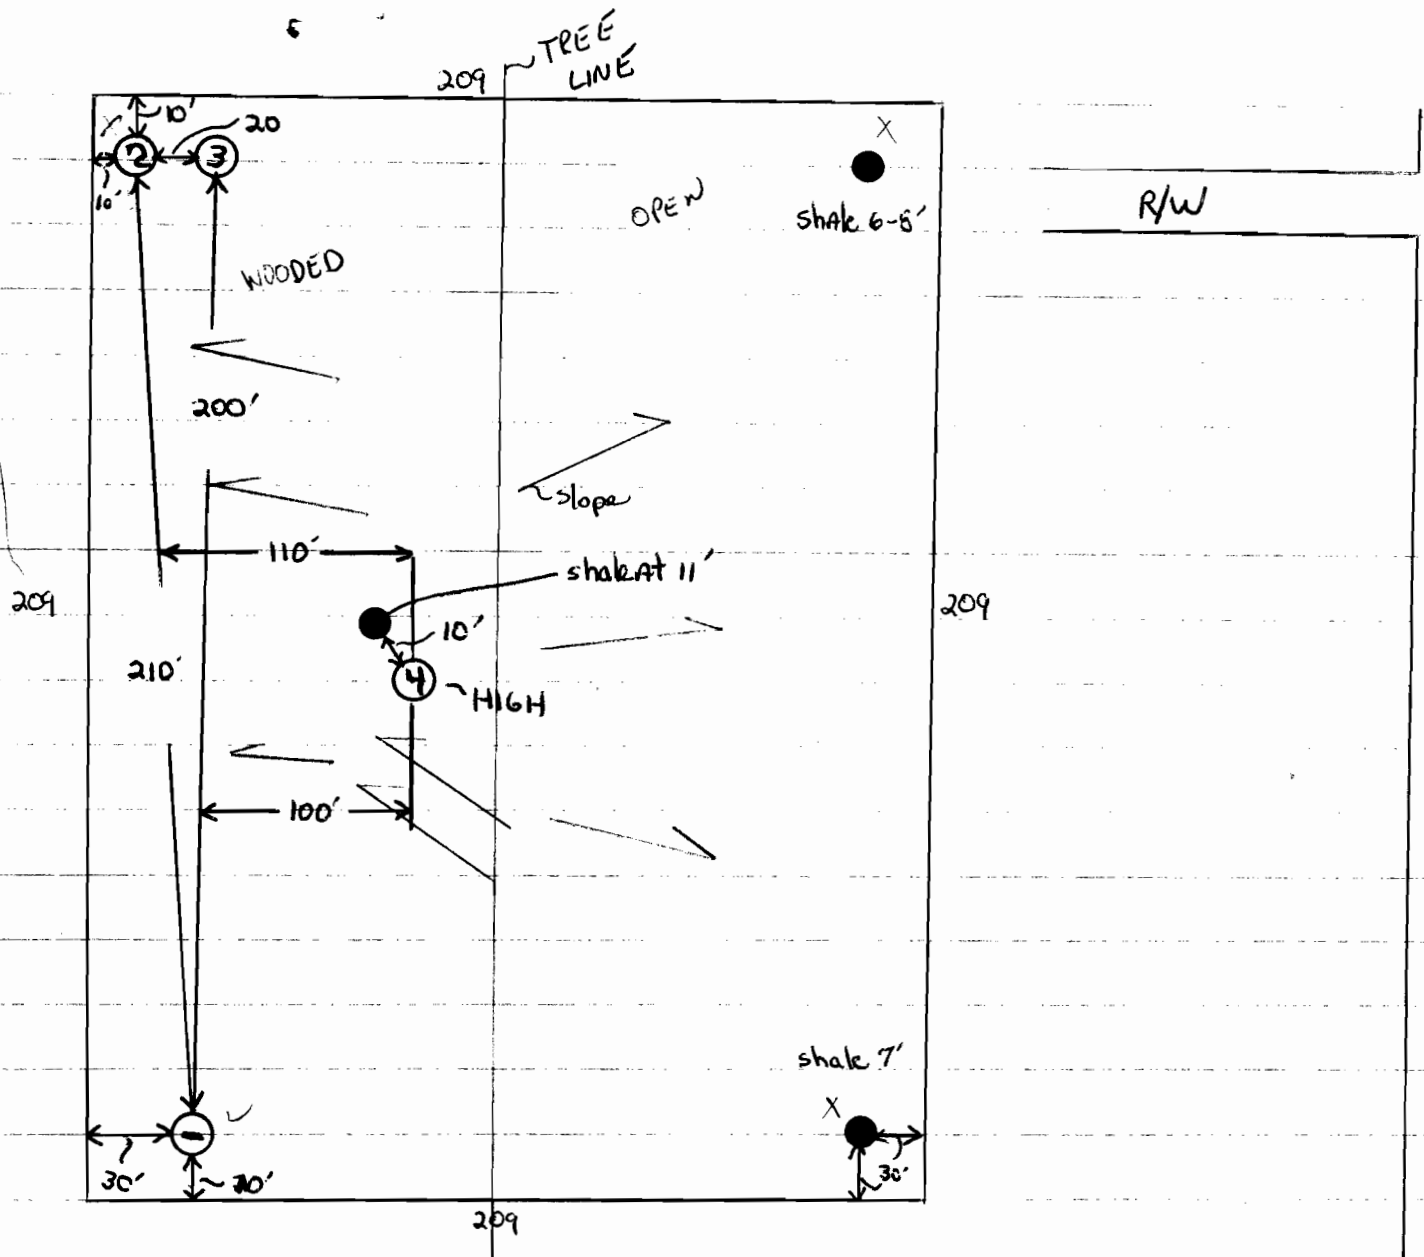


● Holes tested 6/11/76

Hole

- ① Medium amts. hard blue mica 4' to 5', silty clay loam to 13'
- ② Large amts. hard blue mica ~~to~~ 3 to 4', solid at 5'
- ③ Medium amts. hard blue mica ~~to~~ to 4', silty clay loam to 10'
- ④ Weathered/unweathered shale, blue mica at 3'

All holes - (Rock) clay layer to 3' to 5'

HOWARD PD

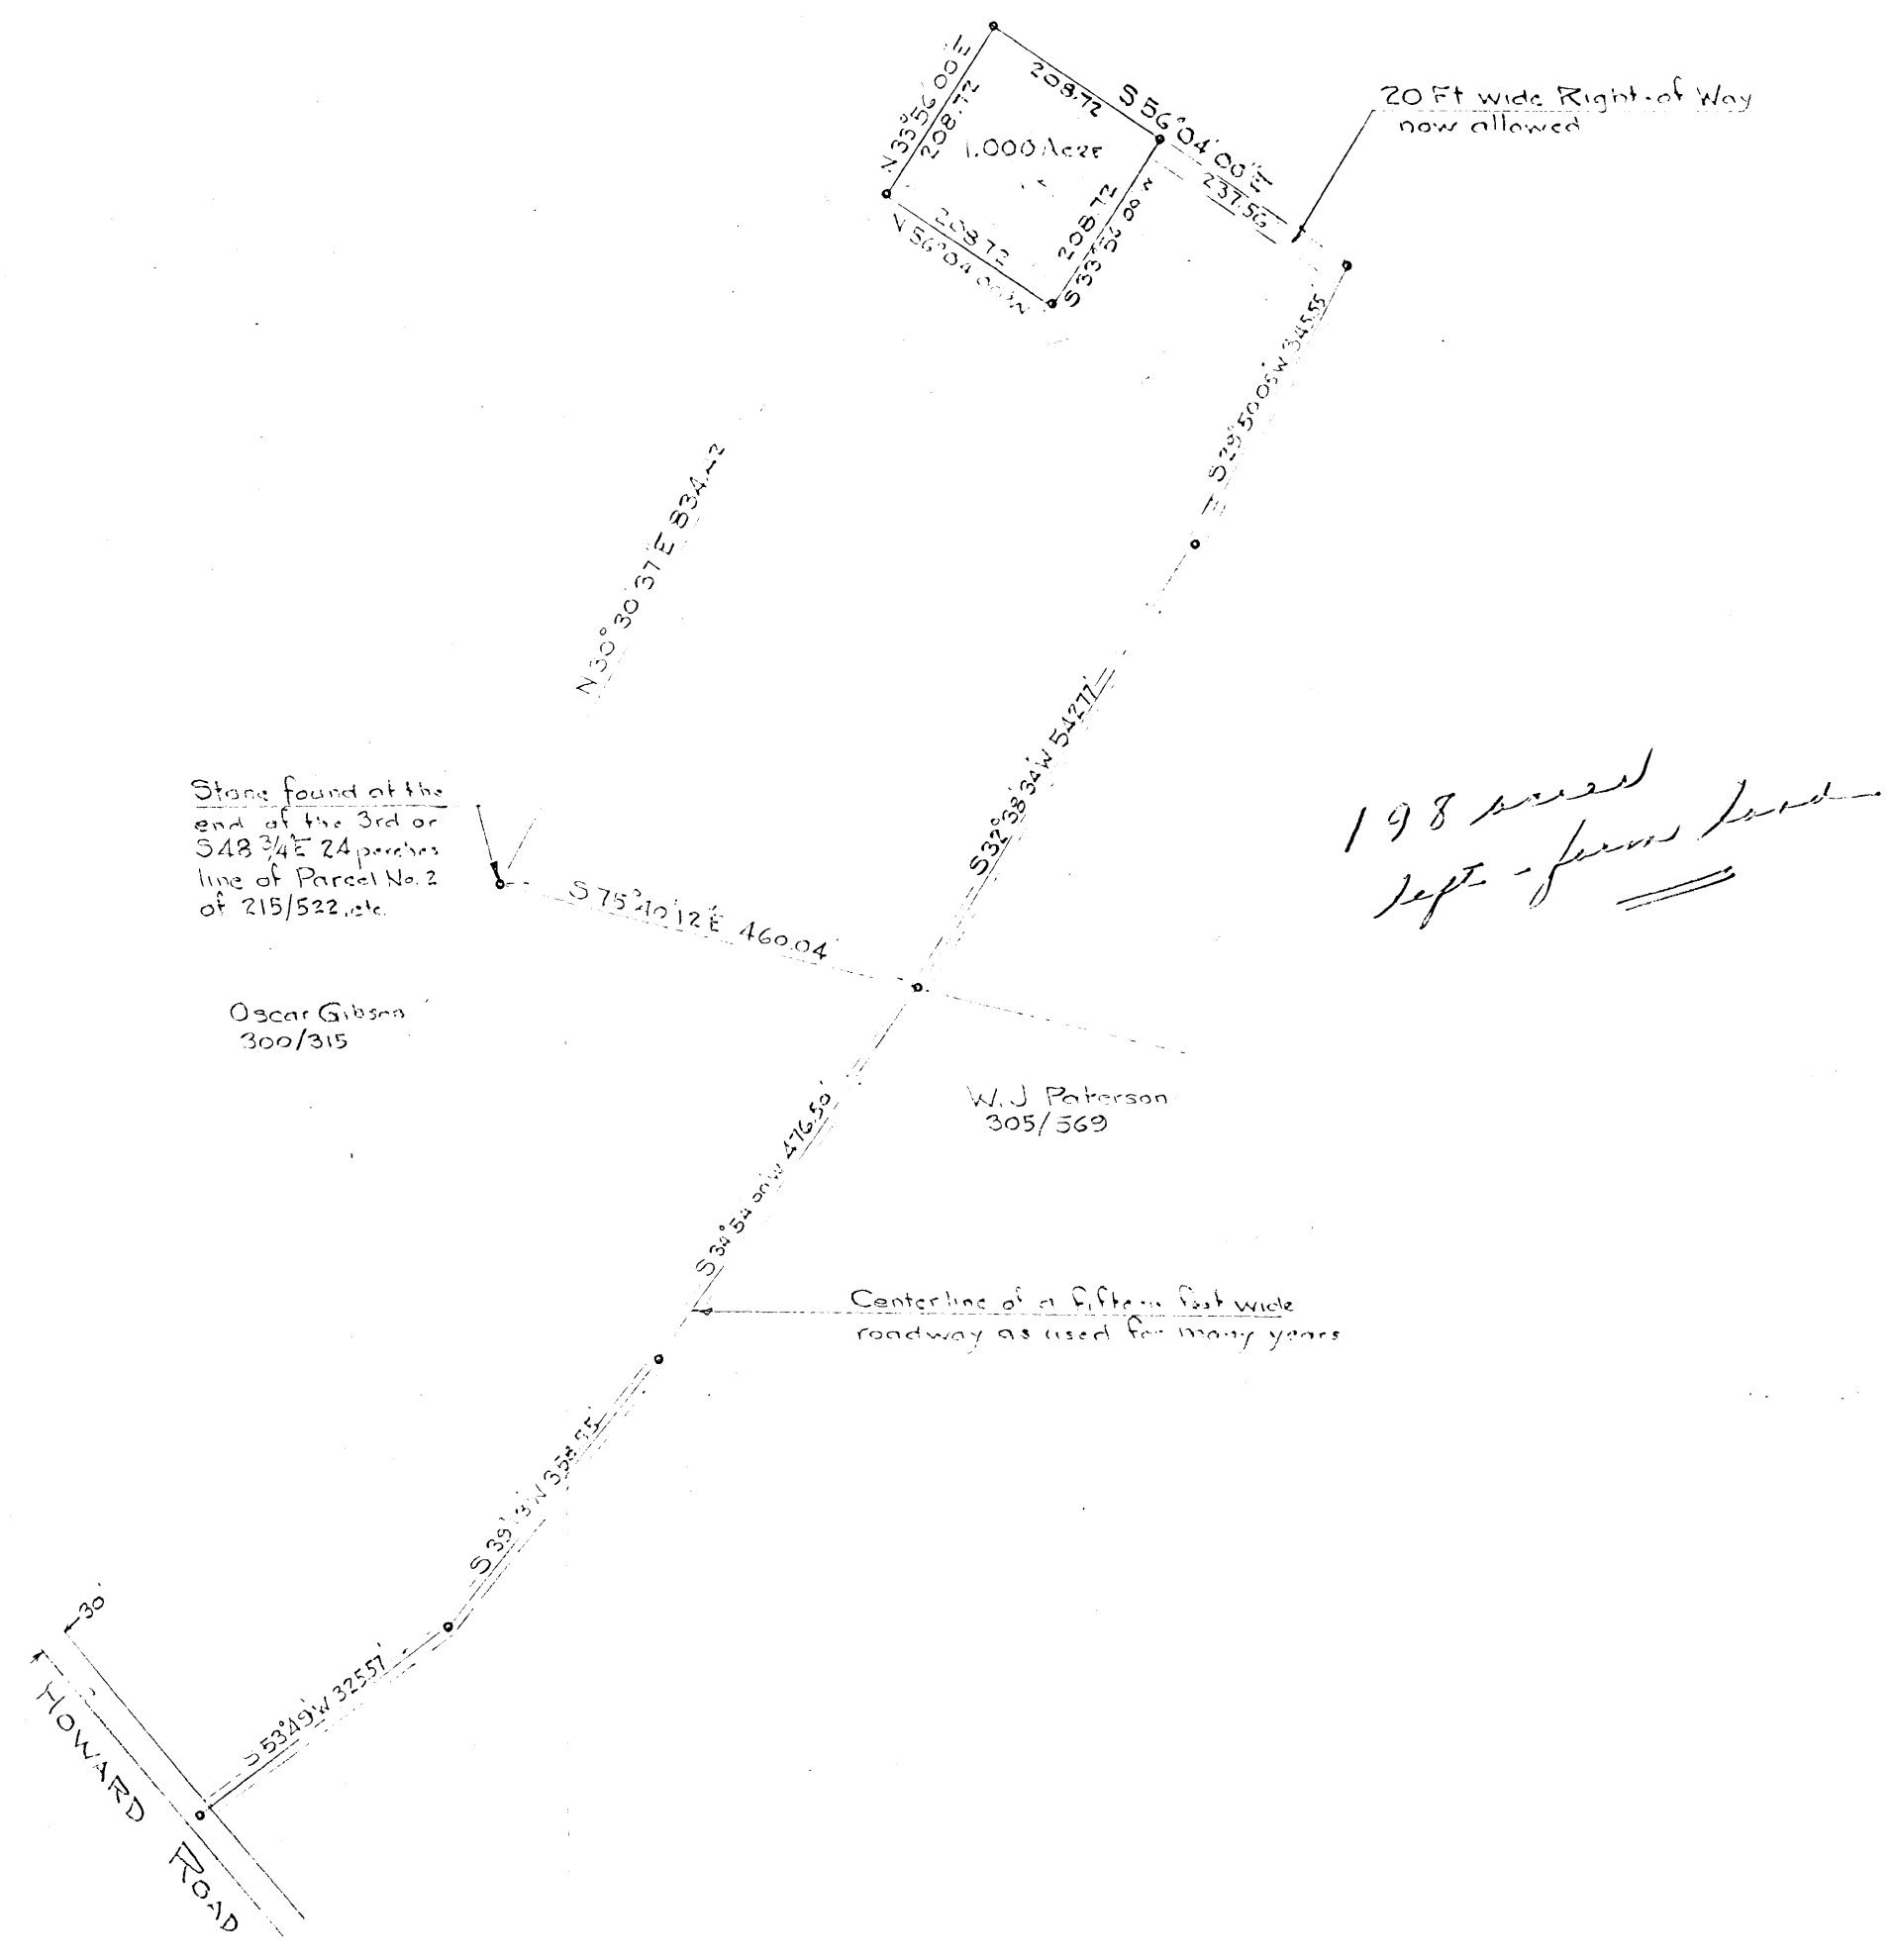

PLAT OF SURVEY
 FOR
 A. LEO HOWARD, JR.
 FIFTH ELECTION DISTRICT, HOWARD COUNTY,
 DAYTON, MARYLAND.
 SCALE: 1 IN = 200 FT. FEBRUARY 28, 1974

XXXXXX
992-2330

November 21, 1977

Mr. & Mrs. A. Leo Howard
4851 Ten Oaks Road
Dayton, Maryland 21036

Dear Mr. & Mrs. Howard:

This is to inform you that the property owned by you on Howard Road and is one (1) acre in size failed to pass the standard percolation test on June 11, 1976. Therefore, this land is non-buildable until public sewer becomes available.

Very truly yours,

Palmer F. Wine, Director
Environmental Health

PFW:hs

*Never used
this letter to
get that relief.*