

2/6/73
Poutch
ok
Bess

PERMIT

P 17885
A 16289

SEWAGE DISPOSAL SYSTEM

MARYLAND STATE DEPARTMENT OF HEALTH

HOWARD COUNTY

THE SYSTEM UNDER THIS PERMIT
IS ACCEPTABLE ONLY UNTIL
PUBLIC FACILITIES BECOME AVAILABLE

ELLICOTT CITY

DISTRICT 1st

DATE 1/19/73

INDEXED

Richard Love

IS PERMITTED TO INSTALL ALTER

ADDRESS Ilchester ~~Rm~~ Road, Ellicott City, Md.

PHONE 747-7598

A SEWAGE DISPOSAL SYSTEM LOCATED AT _____

SUBDIVISION Bonnie Acres

ROAD 513 Bonnie Branch Rd.

LOT 2

PROPERTY OWNER Joseph R. Carruba

ADDRESS 1959 Frames Road, Baltimore, Md. 21222

Phone: 284-3904

SPECIFICATIONS 3 bedrooms

DRAIN FIELD _____ DEPTH _____ FEET, BOTTOM AREA _____ SQ. FT.

SEEPAGE PITS _____ ABSORBENT SIDE-WALL AREA _____ SQ. FT.

SEPTIC TANK CAPACITY 1000 GALLONS

FOR GARBAGE GRINDER, INCREASE DISPOSAL AREA 22% & TANK CAPACITY 50%.

OTHER DRY WELL - 438 sq. ft. of absorbent sidewall area below inlet. Inlet to begin 6 ft. below original grade and maximum depth of dry well 11½ ft. Location 33 ft. from left property line and 31 ft. from front property line as seen from Bonnie Branch Road.

NOTE: ALL PIPE FROM HOUSE TO SEPTIC TANK MUST BE CAST IRON.

PERMIT VOID AFTER THREE YEARS.

NOTE: INSTALL STAND PIPE ON SEPTIC TANK AND DRY WELL.


PLANS APPROVED BY Charles B. Streaker

DATE 10/5/71

FILL SEPTIC TANK AND DISTRIBUTION BOX WITH WATER BEFORE CALLING FOR AN INSPECTION. COVER NO WORK UNTIL INSPECTED AND APPROVED.

NEITHER THE HOWARD COUNTY COMMISSIONERS NOR THE HEALTH DEPARTMENT IS RESPONSIBLE FOR THE SUCCESSFUL OPERATION OF ANY SYSTEM.

A
16289

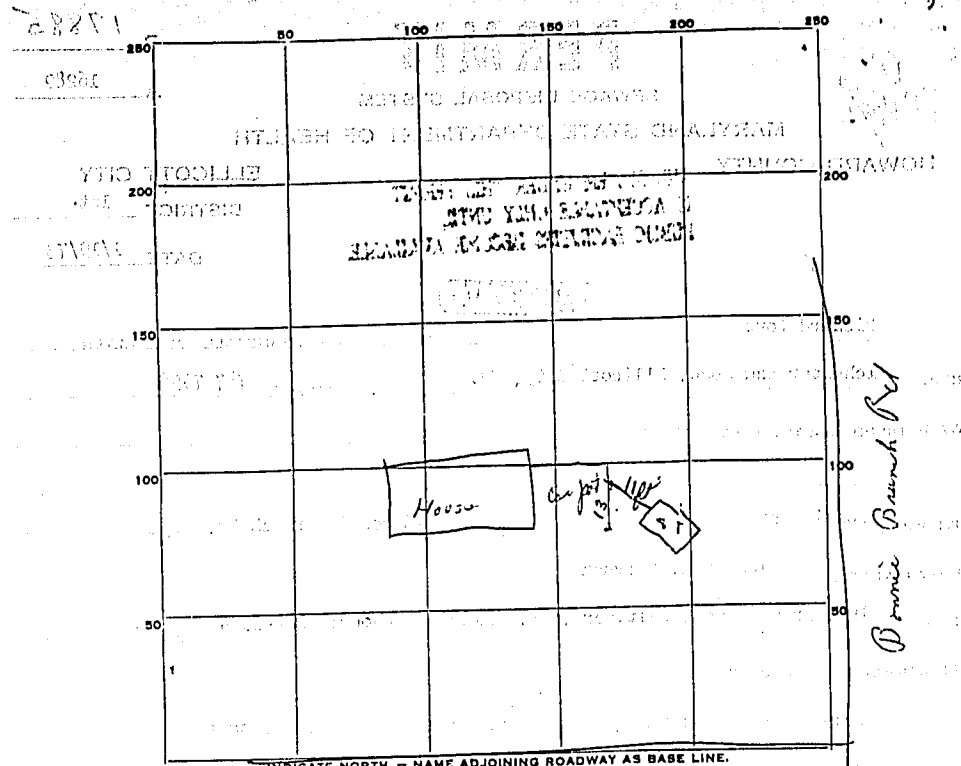

PERMIT CARD OK

SEPTIC TANK, LEVEL OK CLEANOUTS AV

DISTRIBUTION BOX, LEVEL _____

TILE FIELD, DEPTH _____ FT. TRENCH WIDTH _____ FT.

GRAVEL DEPTH _____ IN. TOTAL LENGTH _____ FT.


NUMBER OF TRENCHES _____ TOTAL BOTTOM AREA _____

SEEPAGE PITS, INSIDE DIAMETER _____ FT. DEPTH BELOW INLET _____ FT.

ABSORBENT AREA _____ SQ. FT.

REMARKS 12/10/73 Nothing at all open; no cleanouts visible. WAZ

DATE SYSTEM APPROVED _____ INSPECTOR _____

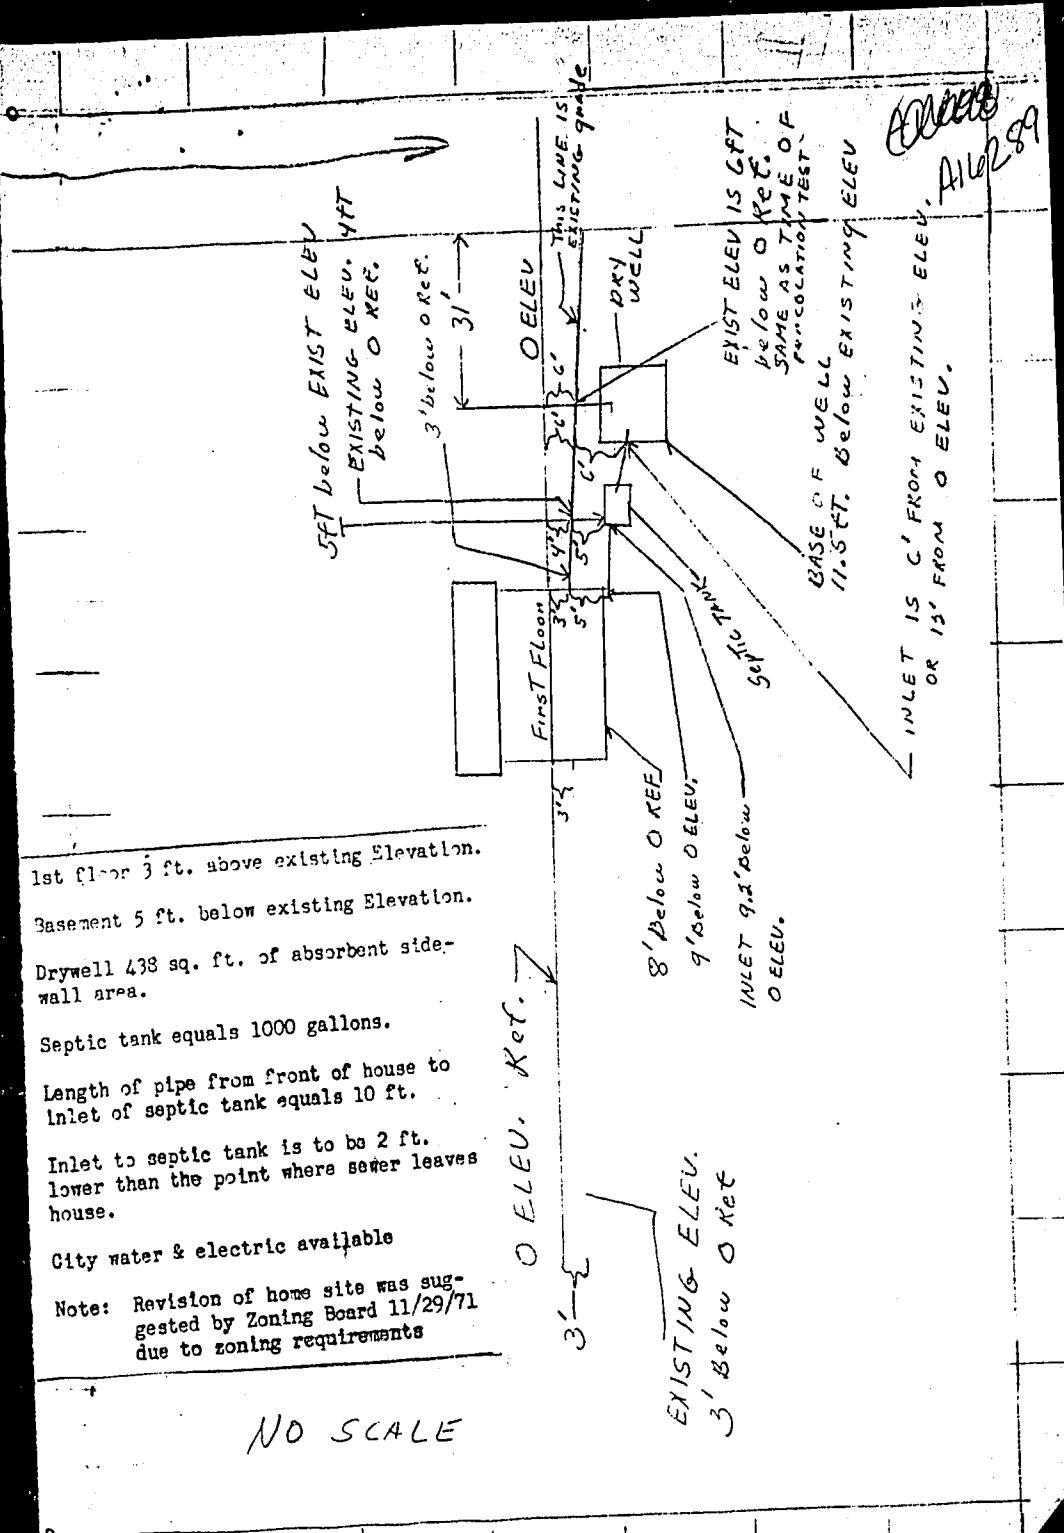

Alvord
 ALV 289

- 1st floor 3 ft. above existing Elevation.
- Basement 5 ft. below existing Elevation.
- Drywell 438 sq. ft. of absorbent side-wall area.
- Septic tank equals 1000 gallons.
- Length of pipe from front of house to Inlet of septic tank equals 10 ft.
- Inlet to septic tank is to be 2 ft. lower than the point where sewer leaves house.
- City water & electric available
- Note: Revision of home site was suggested by Zoning Board 11/29/71 due to zoning requirements

NO SCALE