

03-307115
PERMIT

Approved 1/20/83
Stager

P 32420
A 31882

SEWAGE DISPOSAL SYSTEM

MARYLAND STATE DEPARTMENT OF HEALTH*

ELLICOTT CITY

DISTRICT 3rd.

DATE 1/17/83

HOWARD COUNTY
BUREAU OF ENVIRONMENTAL HEALTH
992-2330

INDEX

Paul Schissler

IS PERMITTED TO INSTALL ALTER

ADDRESS 7311 Brangles Road, Marriottsville, Maryland PHONE 795-2642

SUBDIVISION Farside ROAD 11741 Farside Road LOT 35

PROPERTY OWNER Gil F. Morin PHONE: 766-5198

ADDRESS 12510 Silverbirch Lane
Laurel, Maryland

IF GARBAGE GRINDER IS USED INCREASE SEPTIC TANK CAPACITY BY 50% AND ABSORPTION AREA BY 22%.

GARBAGE GRINDER? YES NO

SEPTIC TANK CAPACITY 1250 GALLONS NUMBER OF BEDROOMS 4

Trench - 163 square foot sidewall area per bedroom. Trench inlet maximum to be 3 feet below original grade and trench bottom to be 9 feet below original grade. Start the trench 75 feet from the back lot line and 135 feet from the left lot line as seen when facing the lot from Farside.

BLDG. PERMIT SIGNED

AND RETURNED 9/7/83

Serial # 50463 - pool.

PLANS APPROVED BY Raymond Hodges

DATE 8/4/82

COVER NO WORK UNTIL INSPECTED AND APPROVED.

NEITHER THE HOWARD COUNTY COUNCIL NOR THE HEALTH DEPARTMENT IS RESPONSIBLE FOR THE SUCCESSFUL OPERATION OF ANY SYSTEM.

NOTE: IF TRENCH IS USED CALL FOR INSPECTION BEFORE AND AFTER PLACING GRAVEL IN TRENCH.

NOTE: NO DRY WELL SHALL EXCEED 15 FOOT IN DIAMETER. NO ABSORPTION TRENCH TO EXCEED 100 FEET IN LENGTH.

NOTE: ALL PIPE FROM HOUSE TO SEPTIC TANK MUST BE CAST IRON OR SCHEDULE 40 PVC OR ABS.

PERMIT VOID AFTER THREE YEARS.

NOTE: INSTALL STAND PIPE ON SEPTIC TANK AND DRY WELL. STAND PIPES MUST BE 6 INCHES IN DIAMETER. CAST IRON, CONCRETE OR TERRA COTTA, OR PVC OR ABS ACCEPTED. IF TOP OF SEPTIC TANK IS DEEPER THAN 3 FEET MANHOLE TO GRADE REQUIRED.

BLDG. PERMIT SIGNED

AND RETURNED 8/24/83

Serial # 50169

Addition


***INSTALLER IS RESPONSIBLE FOR OBTAINING FINAL APPROVAL ON THIS PERMIT**

*CALL 992-2330 FOR INSPECTION OF SEPTIC SYSTEMS.

EH - 2-1082

1/19/83
2 Inset
79,305
2 Inset
11:00 +
1:30 PM
please

31882

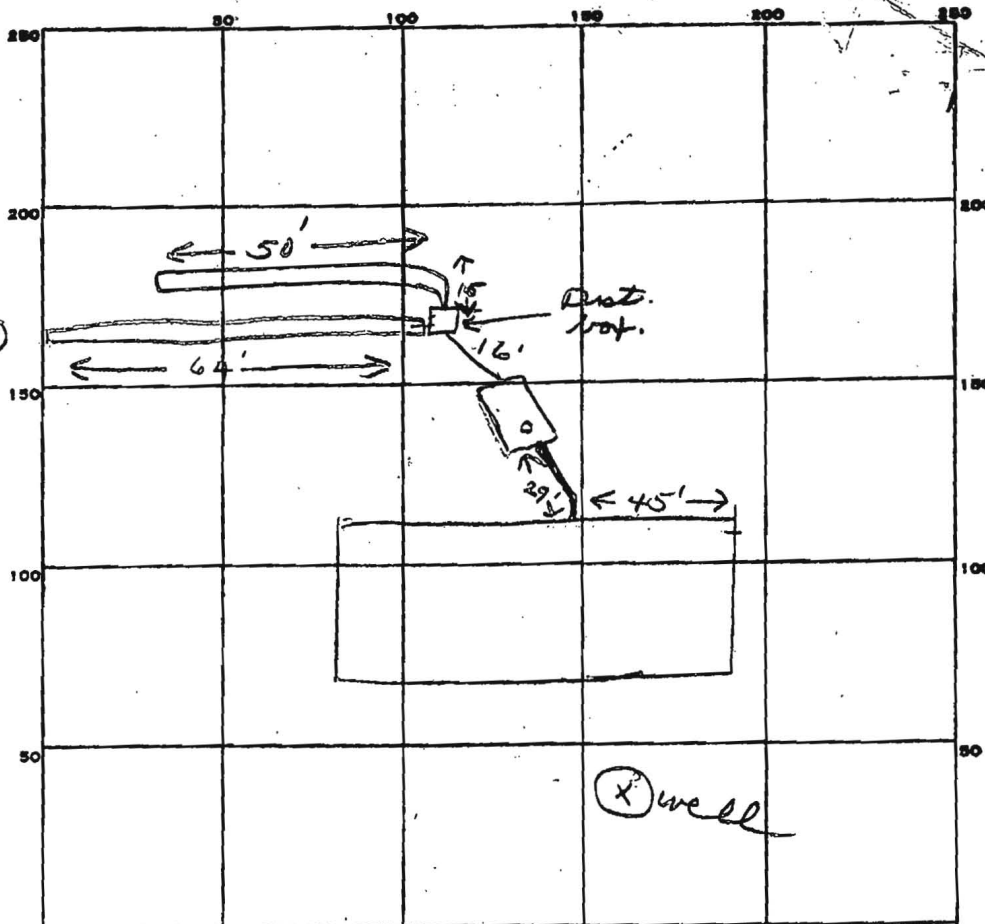

INDICATE NORTH. - NAME ADJOINING ROADWAY AS BASE LINE.

PERMIT CARD _____

SEPTIC TANK, LEVEL _____

✓ 1500 gal

CLEANOUTS _____

57/

DISTRIBUTION BOX, LEVEL _____

TILE FIELD, DEPTH 9 FT. TRENCH WIDTH 2 FT.

GRAVEL DEPTH 6' IN. TOTAL LENGTH 174 FT.

NUMBER OF TRENCHES 2 TOTAL BOTTOM AREA 684

114
6
684

SEEPAGE PITS, INSIDE DIAMETER _____ FT. DEPTH BELOW INLET _____ FT.

ABSORBENT AREA 684 SQ. FT.

REMARKS 1/19/83 OK to add stone in #1 trench. OK to
cover from house to septic tanks. JS
1/19/83 OK to cover #1 trench. JS
1/20/83 OK to add stone in #2 trench. JS
1/20/83 OK to cover all work JS

DATE SYSTEM APPROVED 1/20/83

INSPECTOR _____

Stoyen