

LAYOUT 8/22/08 INSP 4 \_\_\_\_\_  
INSP 2 \_\_\_\_\_ INSP 5 \_\_\_\_\_  
INSP 3 \_\_\_\_\_ INSP 6 \_\_\_\_\_

ISSUE DATE: \_\_\_\_\_

# PERMIT

*logged in*

P 528866

APPROVAL DATE: 8/25/08

A 522884

TAX ID # 05450349

## ON-SITE SEWAGE DISPOSAL SYSTEM HOWARD COUNTY HEALTH DEPARTMENT BUREAU OF ENVIRONMENTAL HEALTH

Jeffrey Cooper / FOGLES WAS THE CONT. IS PERMITTED TO INSTALL  ALTER

ADDRESS: 5126 W. Running Brook Rd PHONE NUMBER: \_\_\_\_\_

SUBDIVISION: Dustin Property LOT NUMBER: 2

ADDRESS: 8072 Hunterbrooke Lane PROPERTY OWNER: Jeff Cooper

SEPTIC TANK CAPACITY (GALLONS): 2000 OUTLET BAFFLE FILTER REQUIRED

PUMP CHAMBER CAPACITY (GALLONS): \_\_\_\_\_ COMPARTMENTED TANK REQUIRED

NUMBER OF BEDROOMS: 4

*2' wide  
Inlet @ 4'*

SQUARE FEET PER BEDROOM: \_\_\_\_\_

*Bottom @ 3'*

LINEAR FEET OF TRENCH REQUIRED: 240  
*165'*

*Effective @ 6' 72 ton stone*

TRENCHES:	Trench to be 2.0 feet wide. Inlet <del>4.0</del> feet below original grade. Bottom maximum depth <del>6.0</del> feet below original grade. Effective area begins at <del>4.0</del> feet below original grade. <del>4.0</del> feet of stone below distribution pipe.
LOCATION:	1) Set septic tank per plan, and distribution box near south corner of septic easement. 2) Install 3x80' trenches on contour
NOTES:	1) Stake septic easement corners; mark property line. 2) Call for layout inspection 3) Gravel tickets must be available for inspector. 4) Basement will not sewer by gravity.

PLANS APPROVED: Robert Bricker DATE: 2/19/08

- NOTE: PERMIT VOID AFTER 2 YEARS
- NOTE: CONTRACTOR RESPONSIBLE FOR SCHEDULING A PRE-CONSTRUCTION INSPECTION FOR ALL INSTALLATIONS
- NOTE: WATERTIGHT SEPTIC TANKS REQUIRED
- NOTE: ALL PARTS OF SEPTIC SYSTEM SHALL BE 100 FEET FROM ANY WATER WELL
- NOTE: MANHOLE RISERS REQUIRED ON ALL SEPTIC TANKS AND PUMP CHAMBERS UNLESS SPECIFICALLY AUTHORIZED

**NEITHER THE HOWARD COUNTY COUNCIL NOR THE HEALTH DEPARTMENT IS RESPONSIBLE FOR THE SUCCESSFUL OPERATION OF ANY SYSTEM PERMITTEE RESPONSIBLE FOR OBTAINING FINAL APPROVAL ON THIS PERMIT CALL 410-313-1771 FOR INSPECTION OF SEPTIC SYSTEM**

NOT TO SCALE

See Separate sheet  
for As Built

ROAD

**TRENCH/DRAINFIELD DATA**

WIDTH	INLET	BOTTOM
2'	4'	8'
NUMBER OF TRENCHES		2
TOTAL LENGTH		162
ABSORPTION AREA		324' x SW
DISTRIBUTION BOX LEVEL		Level 6'
DISTRIBUTION BOX BAFFLE		Yes
DISTRIBUTION BOX PORT		Yes

**SEPTIC TANK DATA**

SEPTIC TANK 1 LEVEL	Yes
CAPACITY	2000 GAL
SEAM LOC	Top
TANK LID DEPTH	1.5'
BAFFLES	Yes
BAFFLE FILTER	—
MANHOLE LOC	Front / R/W
6" PORT LOC	none
WATERTIGHT TEST	—
SEPTIC TANK 2 LEVEL	—
CAPACITY	— GAL
SEAM LOC	—
TANK LID DEPTH	—
BAFFLES	—
BAFFLE FILTER	—
MANHOLE LOC	—
6" PORT LOC	—
WATERTIGHT TEST	—


Babylon  
sketch

PRE-CONSTRUCTION 8/22/08 Contractor to install 2x 82' trenches on center.  
 set Tank & D box per BP Plan. Specs changed to 4' to 8' (K)

INSTALLATION 8/25/08 Tank set. All plumbing installed.  
 Top trench installed only 10' more feet of trench.  
 OK to backfill when finished. (K)

FINAL INSPECTOR K. Wally DATE OF APPROVAL 8/25/08

NOT TO SCALE


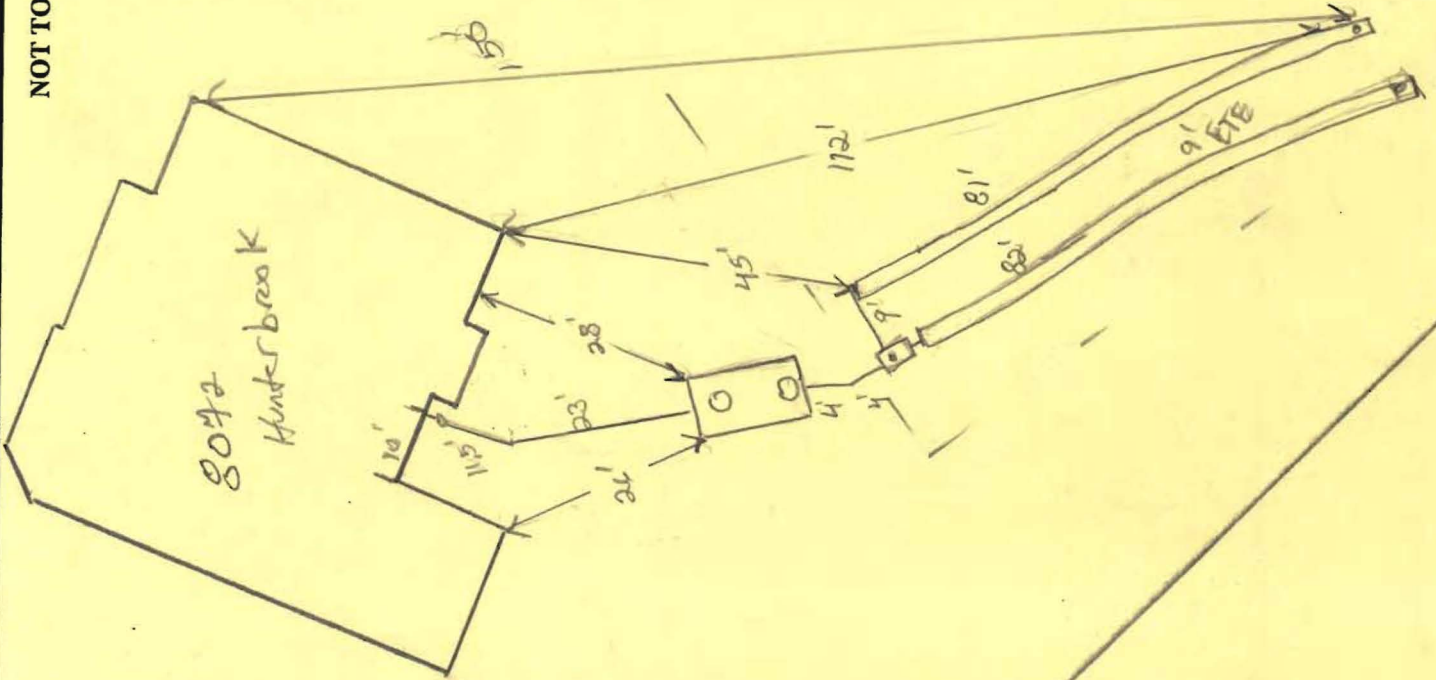


**GENERAL NOTES:**


- 1) THIS LOCATION DRAWING IS PREPARED FOR THE BENEFIT OF THE CLIENT SIGNING THE HOUSE LOCATION SURVEY APPROVAL FORM INsofar AS IT IS REQUIRED BY A LENDER OR TITLE INSURANCE COMPANY OR ITS AGENTS IN CONNECTION WITH THE CONTEMPLATED TRANSFER, FINANCING OR REFINANCING OF THE PROPERTY SHOWN HEREON. UNLESS INDICATED AS BEING A BOUNDARY SURVEY, THIS LOCATION DRAWING IS NOT INTENDED FOR USE IN THE ESTABLISHMENT OF PROPERTY LINES AND IS NOT TO BE RELIED UPON FOR THE ESTABLISHMENT OR LOCATIONS OF FENCES, GARAGES, BUILDINGS OR OTHER EXISTING OR FUTURE IMPROVEMENTS. AS A RESULT, THIS LOCATION DRAWING DOES NOT PROVIDE FOR ACCURATE IDENTIFICATION OF PROPERTY LINES, BUT SUCH IDENTIFICATION MAY NOT BE REQUIRED FOR THE TRANSFER OF TITLE OR SECURING FINANCING FOR RE-FINANCING.
- 2) SUBJECT PROPERTY IS SHOWN IN ZONE C ON THE NATIONAL FLOOD INSURANCE PROGRAM FLOOD INSURANCE RATE MAP OF HOWARD COUNTY, MARYLAND, COMMUNITY PANEL No. 2400440042B EFFECTIVE DEC. 4, 1986.
- 3) THE OFFSETS FROM BUILDING LINE TO PROPERTY LINE AS SHOWN ON THE PLAT HEREON ARE TO AN ACCURACY OF PLUS OR MINUS 1.0' (+)
- 4) NO TITLE REPORT FURNISHED. SUBJECT TO ALL EASEMENTS, RIGHTS OF WAY AND CONDITIONS OF RECORD.
- 5) THE EXISTING WELL SHOWN ON THIS PLAN (IDENTIFIED WITH THE ATTACHED WELL TAG NUMBER HO-95-1150) HAS BEEN FIELD LOCATED BY FISHER, COLLINS AND CARTER, INC. PROFESSIONAL LAND SURVEYORS AND IS ACCURATELY SHOWN.



A:	N08°50'16"E	20.96'(FCE)
B:	N71°09'34"W	54.52'(FCE)
C:	N34°41'04"W	14.73'(FCE)
D:	N13°00'59"E	24.67'(FCE)
E:	N34°58'57"E	46.94'(FCE)
F:	S06°16'03"E	37.69'(FCE)
G:	N39°16'04"E	52.15'(FCE)
H:	N17°51'28"E	85.99'(FCE)

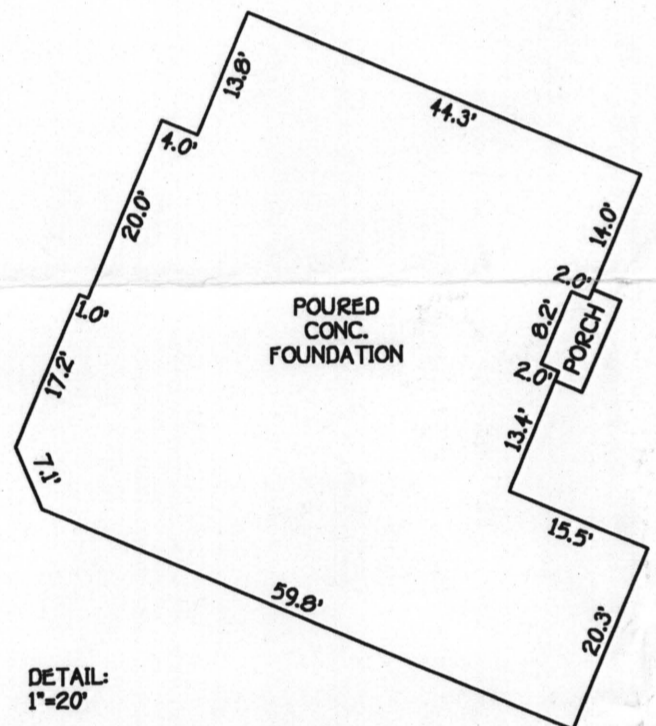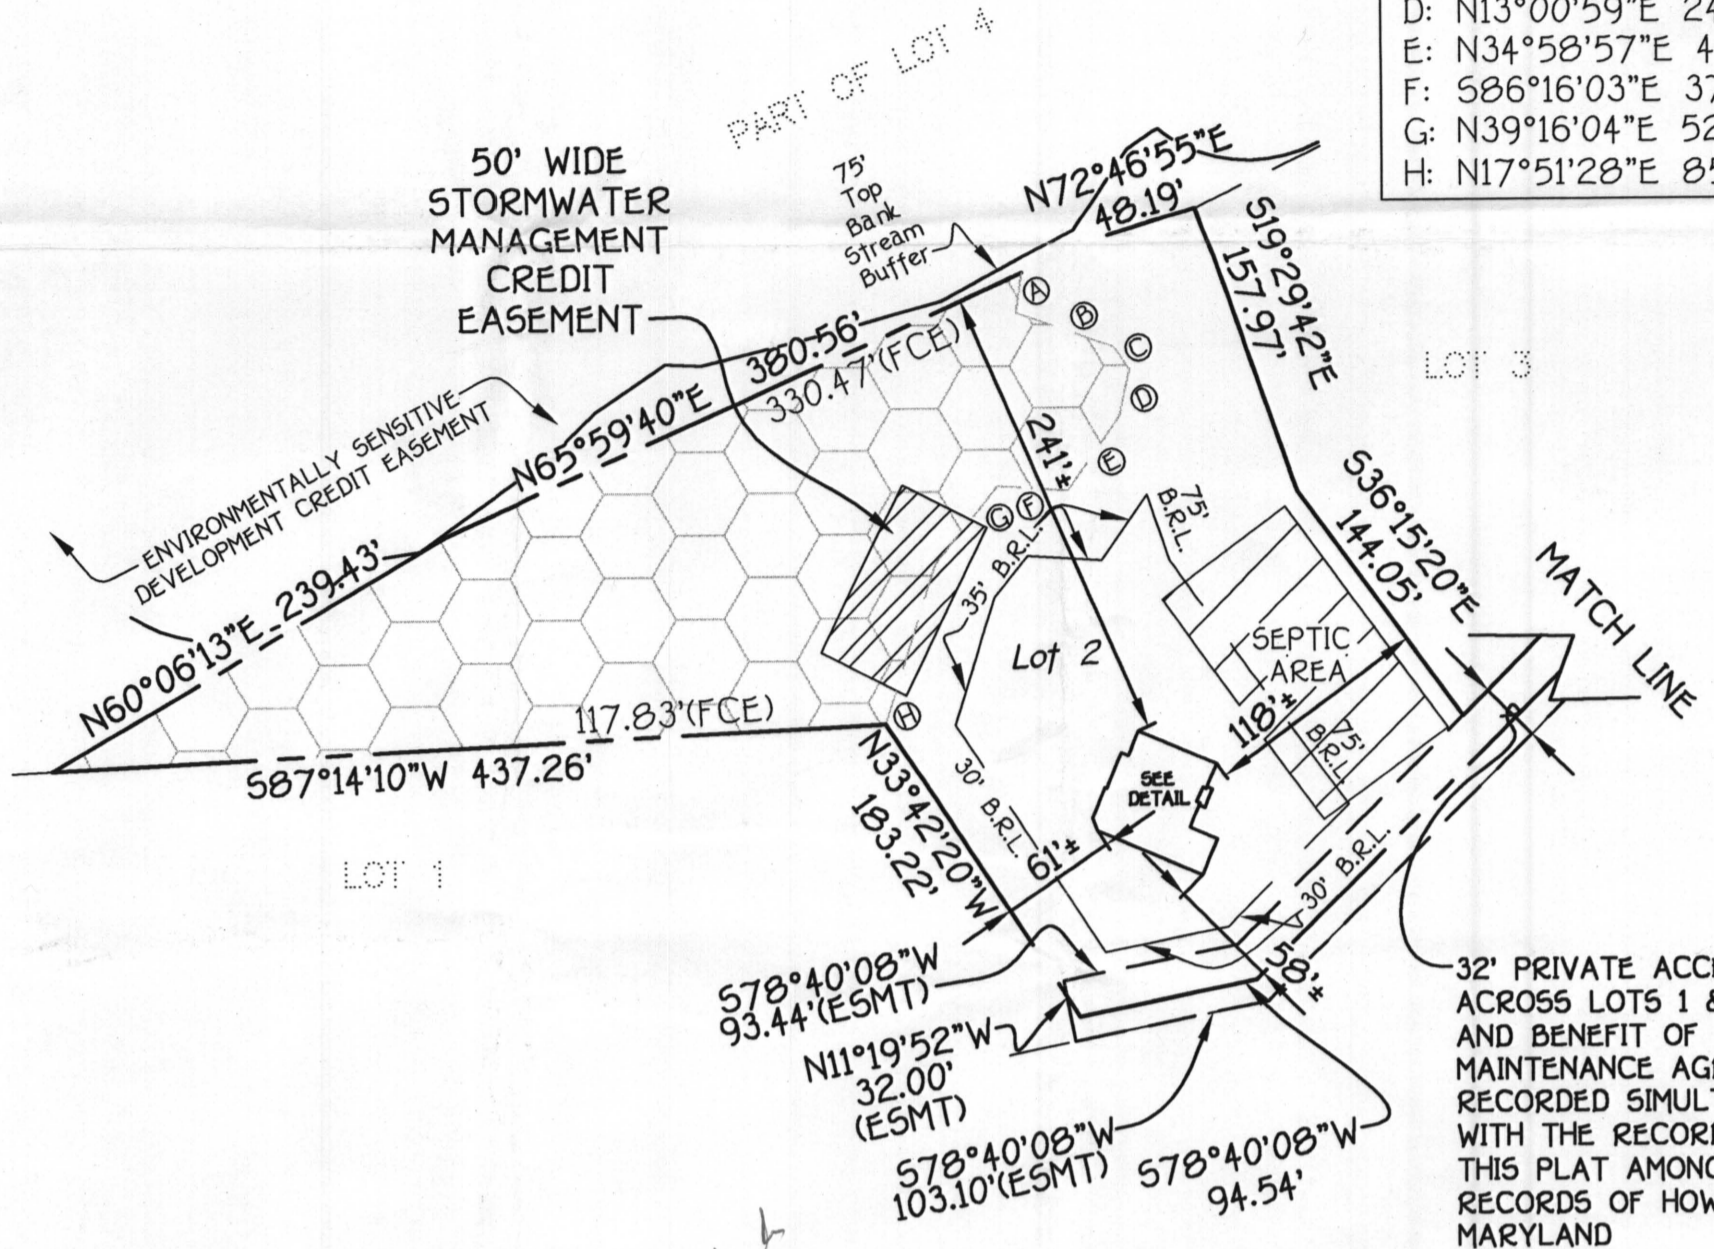

*well check ok 2/30/08*

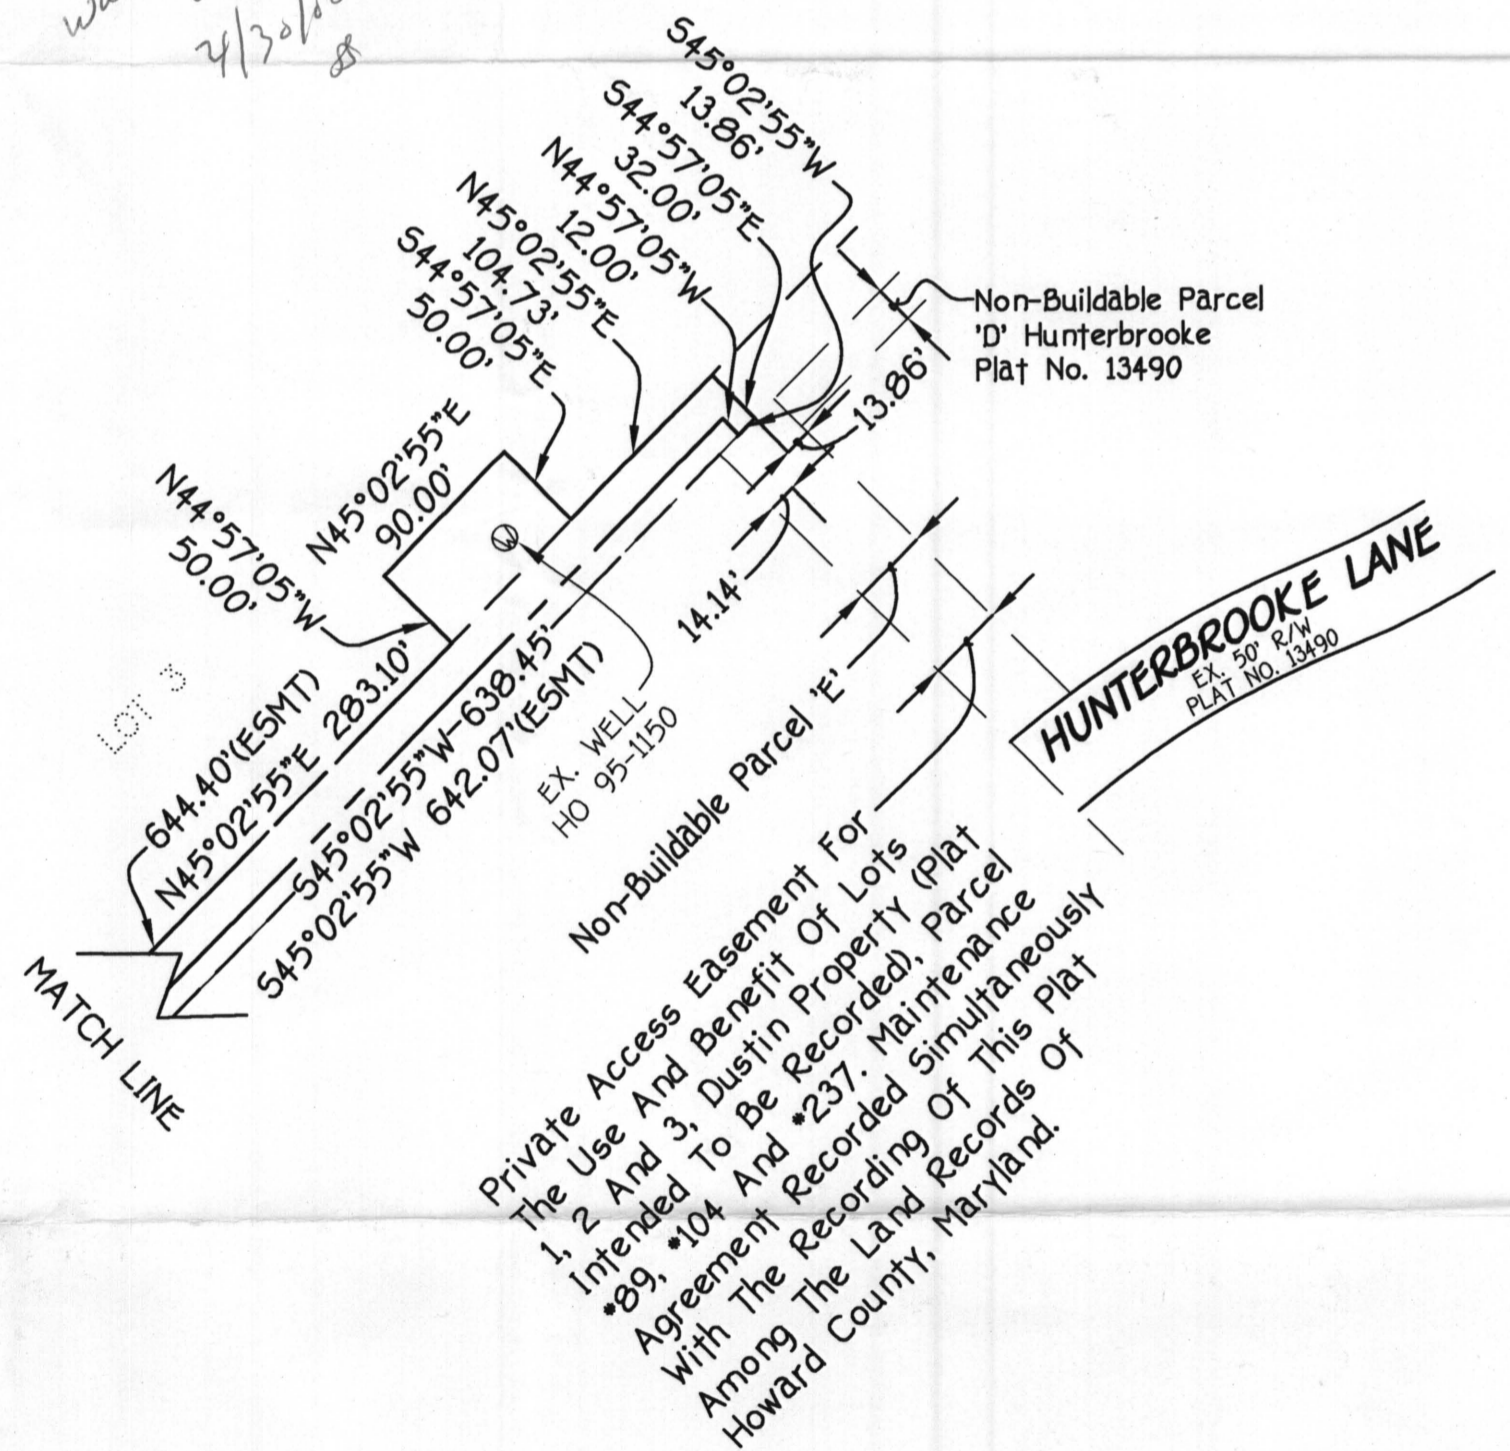

Private Access Easement For The Use And Benefit Of Lots 1, 2 And 3, Dustin Property (Plat #89, #104 And #237. Maintenance Agreement Recorded Simultaneously With The Recording Of This Plat Among The Land Records Of Howard County, Maryland.

**HOUSE LOCATION DRAWING**

LOT 2  
DUSTIN PROPERTY  
LOTS 1 THRU 4  
FIFTH ELECTION DISTRICT  
HOWARD COUNTY, MARYLAND  
PLAT #19666-19668  
#072 HUNTERBROOKE LANE  
B.R.L.= BUILDING RESTRICTION LINE  
TOP OF FOUNDATION WALL= 412.1'

FOUNDATION LOCATION: 3/28/08  
FINAL LOCATION: \_\_\_\_\_  
BOUNDARY SURVEY: \_\_\_\_\_  
SCALE: 1"=100'  
DATE: 04/01/08  
DRAWN BY: V.L.J.  
CHECKED BY: M.L.R.  
PROJECT No.: 05072-6001

*Mark L. Robel* 4/6/08  
PROFESSIONAL LAND SURVEYOR DATE  
REG. # 339  
**FISHER, COLLINS & CARTER, INC.**  
CIVIL ENGINEERING CONSULTANTS & LAND SURVEYORS  
CENTENNIAL SQUARE OFFICE PARK - 10272 BALTIMORE NATIONAL PIKE  
ELLICOTT CITY, MARYLAND 21042  
4100 481 - 2895





# HOWARD COUNTY HEALTH DEPARTMENT

PS 28866

DATE  
3 / 28 / 08

Received From

Jeffrey Cooper

PHONE # 443-324-9511

5126 W. Kemmerly Brook Rd

For Septic permit

DILPV  
FAXL  
CLARKV  
LOEL  
PAT TRACV

District prop lot 2 8972 Huntchamberland

Three hundred ninety six and 00/100

~~Three hundred ninety six and 00/100~~

Dollars

- CASH
- CHECK

NO.

546

\$ 396 | 00

Received By

*[Signature]*