

22nd

APPLICATION

FOR PERCOLATION TESTING AND SITE EVALUATION

TEST DATE(S) _____ TEST TIME _____ ~~AD~~ 521549

AGENCY REVIEW: _____ DATE 10/20/2004

TAX ID # 05-385512

DO NOT WRITE ABOVE THIS LINE

I HEREBY APPLY FOR THE NECESSARY TESTING/EVALUATION PRIOR TO ISSUANCE OF SEWAGE DISPOSAL SYSTEM PERMIT(S) TO:

CHECK AS NEEDED:

- CONSTRUCT NEW SEPTIC SYSTEM(S)
- REPAIR/ADD TO AN EXISTING SEPTIC SYSTEM
- REPLACE AN EXISTING SEPTIC SYSTEM

CHECK AS NEEDED:

- NEW STRUCTURE(S)
- ADDITION TO AN EXISTING STRUCTURE
- REPLACE AN EXISTING STRUCTURE

CHECK ONE:

- CREATE NEW LOT(S)
- BUILD ON AN EXISTING LOT IN A SUBDIVISION
- BUILD ON AN EXISTING PARCEL OF RECORD

IS THE PROPERTY WITHIN 2500' OF ANY RESERVOIR?

- YES
- NO

THE TYPE OF STRUCTURE IS:

- RESIDENTIAL WITH unknown PROPOSED BEDROOMS IN THE COMPLETED STRUCTURE (NOTE UNKNOWN IF APPROPRIATE)
- COMMERCIAL (PROVIDE DETAIL OF NUMBERS AND TYPES OF EMPLOYEES/ CUSTOMERS ON ACCOMPANYING PLAN)
- INSTITUTIONAL/GOVERNMENT (PROVIDE DETAIL OF NUMBERS AND TYPES OF EMPLOYEES/USERS ON ACCOMPANYING PLAN)

PROPERTY OWNER(S) John Morrell

DAYTIME PHONE _____ CELL 1-240-401-2349 FAX _____

MAILING ADDRESS 13989 Route 108 Highland MD 20777
STREET CITY/TOWN STATE ZIP

APPLICANT Same as owner

DAYTIME PHONE _____ CELL _____ FAX _____

MAILING ADDRESS _____
STREET CITY/TOWN STATE ZIP

APPLICANT'S ROLE: DEVELOPER BUILDER BUYER RELATIVE/FRIEND REALTOR CONSULTANT

PROPERTY LOCATION
SUBDIVISION/PROPERTY NAME _____ LOT NO. _____

PROPERTY ADDRESS 13989 E. Route 108 Highland, MD 20777
STREET TOWN/POST OFFICE

TAX MAP PAGE(S) 40 GRID 15 PARCEL(S) 33 PROPOSED LOT SIZE 19.4 ac

AS APPLICANT, I UNDERSTAND THE FOLLOWING: THE SYSTEM INSTALLED SUBSEQUENT TO THIS APPLICATION IS ACCEPTABLE ONLY UNTIL PUBLIC SEWERAGE IS AVAILABLE. THIS APPLICATION IS COMPLETE WHEN ALL APPLICABLE FEES AND A SUITABLE SITE PLAN HAVE BEEN RECEIVED. I ACCEPT THE RESPONSIBILITY FOR COMPLIANCE WITH ALL M.O.S.H.A. AND "MISS UTILITY" REQUIREMENTS. APPROVAL IS BASED UPON SATISFACTORY REVIEW OF A PERC CERTIFICATION PLAN.


TEST RESULTS WILL BE MAILED TO APPLICANT. _____
SIGNATURE OF APPLICANT

HOWARD COUNTY HEALTH DEPARTMENT, BUREAU OF ENVIRONMENTAL HEALTH, WELL AND SEPTIC PROGRAM
3525-H ELLICOTT MILLS DRIVE, ELLICOTT CITY, MARYLAND 21043-4544 (410) 313-1771 FAX (410) 313-2648
TDD (410) 313-2323 TOLL FREE 1-877-4MD-DHMH

A/P
P1
 Str brn
 micac
 LS
 moist
 (w/k ball)
 friable, loose
 6'±
 S.F., med
 gr sand
 mica 25%±
 9'±
 Strong
 v. wk s.p. dete
 Mn on blacky
 faas
 Bottom
 12'±

P2
 str brn
 LS
 v.f.S
 dry v.wk ball
 4 SL
 v.f.S-
 LS
 Trace
 Kx
 ~20%
 mica
 Bottom
 12'±

P3
 org brn
 Loam
 stony frag
 ~10%
 org brn
 Loam
 Si ↑ more
 than P1, P2
 Bottom
 12'

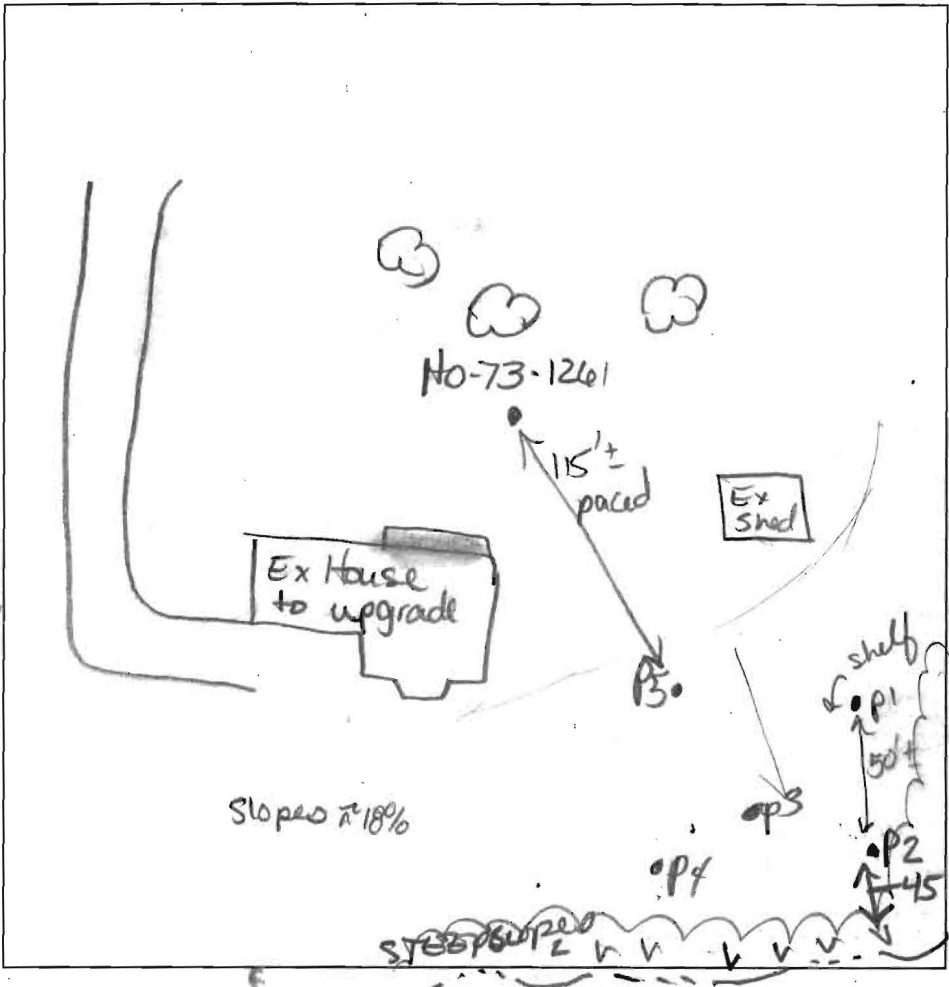

P4/P5
 str brn
 L-hyL
 3'
 micac.
 med
 gr S-
 LS packets
 Trace
 Kx
 Sg
 12' Bottom

DATE	TEST #	DEPTH	START	BREAK 1" DROP	STOP 2" DROP	TIME OF 2nd INCH	P/F/H
11-23-01	P1	3 1/2 M	10:35 ^{PM}	10:36	10:37 ⁴⁰	1 1/2	P
		Surface schist - flagstone					
	P2	3' M	10:59 ¹¹	11:00 ¹⁵	11:01 ⁴⁰	1 1/2	P
	P3	3 1/2 M	11:23	11:31	11:46	15	P
	P4/P5	3 1/2 S	11:54	11:59	12:06	7	P

REMARKS 8" diameter hole
 SANITARIAN KN BACKHOE WTC/Eddie OTHERS _____
 TEST HOLES USED IN SDA _____ AVG. PERC TIME 6.25 SQ. FT/BR _____
 TRENCH WIDTH _____ INLET DEPTH _____ MAX. BOT DEPTH _____ EFFECTIVE SW _____



7178 Columbia Gateway Drive, Columbia, MD 21046

(410) 313-2640 Fax (410) 313-2648

TDD (410) 313-2323 Toll Free 1-866-313-6300

website: www.hchealth.org

Penny E. Borenstein, M.D., M.P.H., Health Officer

November 24, 2004

John Morrell
13989 Route 108
Highland, MD 20777

Re: Percolation Test Results A521549
13989 Route 108
Tax Map: 40 Parcel: 23

Dear Mr. Morrell:


Percolation testing performed on 11-22-04 produced satisfactory soil results. Have your licensed engineer submit a final percolation plat for signature with the following additions and/or changes:

- General Note #2 shall say, ... "grant adjustments to", not "for encroachments into"
- Field locate existing well and add the well tag number to the plan
- Indicate slopes 25% or greater than with shading and add to a legend.
- Add a statement indicating the existing system will be abandoned
- Field locate percolation test holes with spot elevations. Also adjust the final SDA perimeter by cutting away from percolation test hole #5 and adding area 25' further past percolation test holes P1 & P2.


This percolation certification plan may also be incorporated into a building site plan for your convenience. If you create a site plan for the new house, inverts from the house to the septic system will need to be on the plan. Upon your needs, inverts into the septic system may be adjusted. Have your engineer contact me to discuss the options.

Thank you for your time in this important matter. I may be reached at 410-313-1771.

Sincerely,

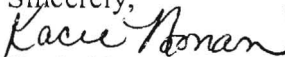
Kacie Noonan

Cc: Benchmark Engineering
file

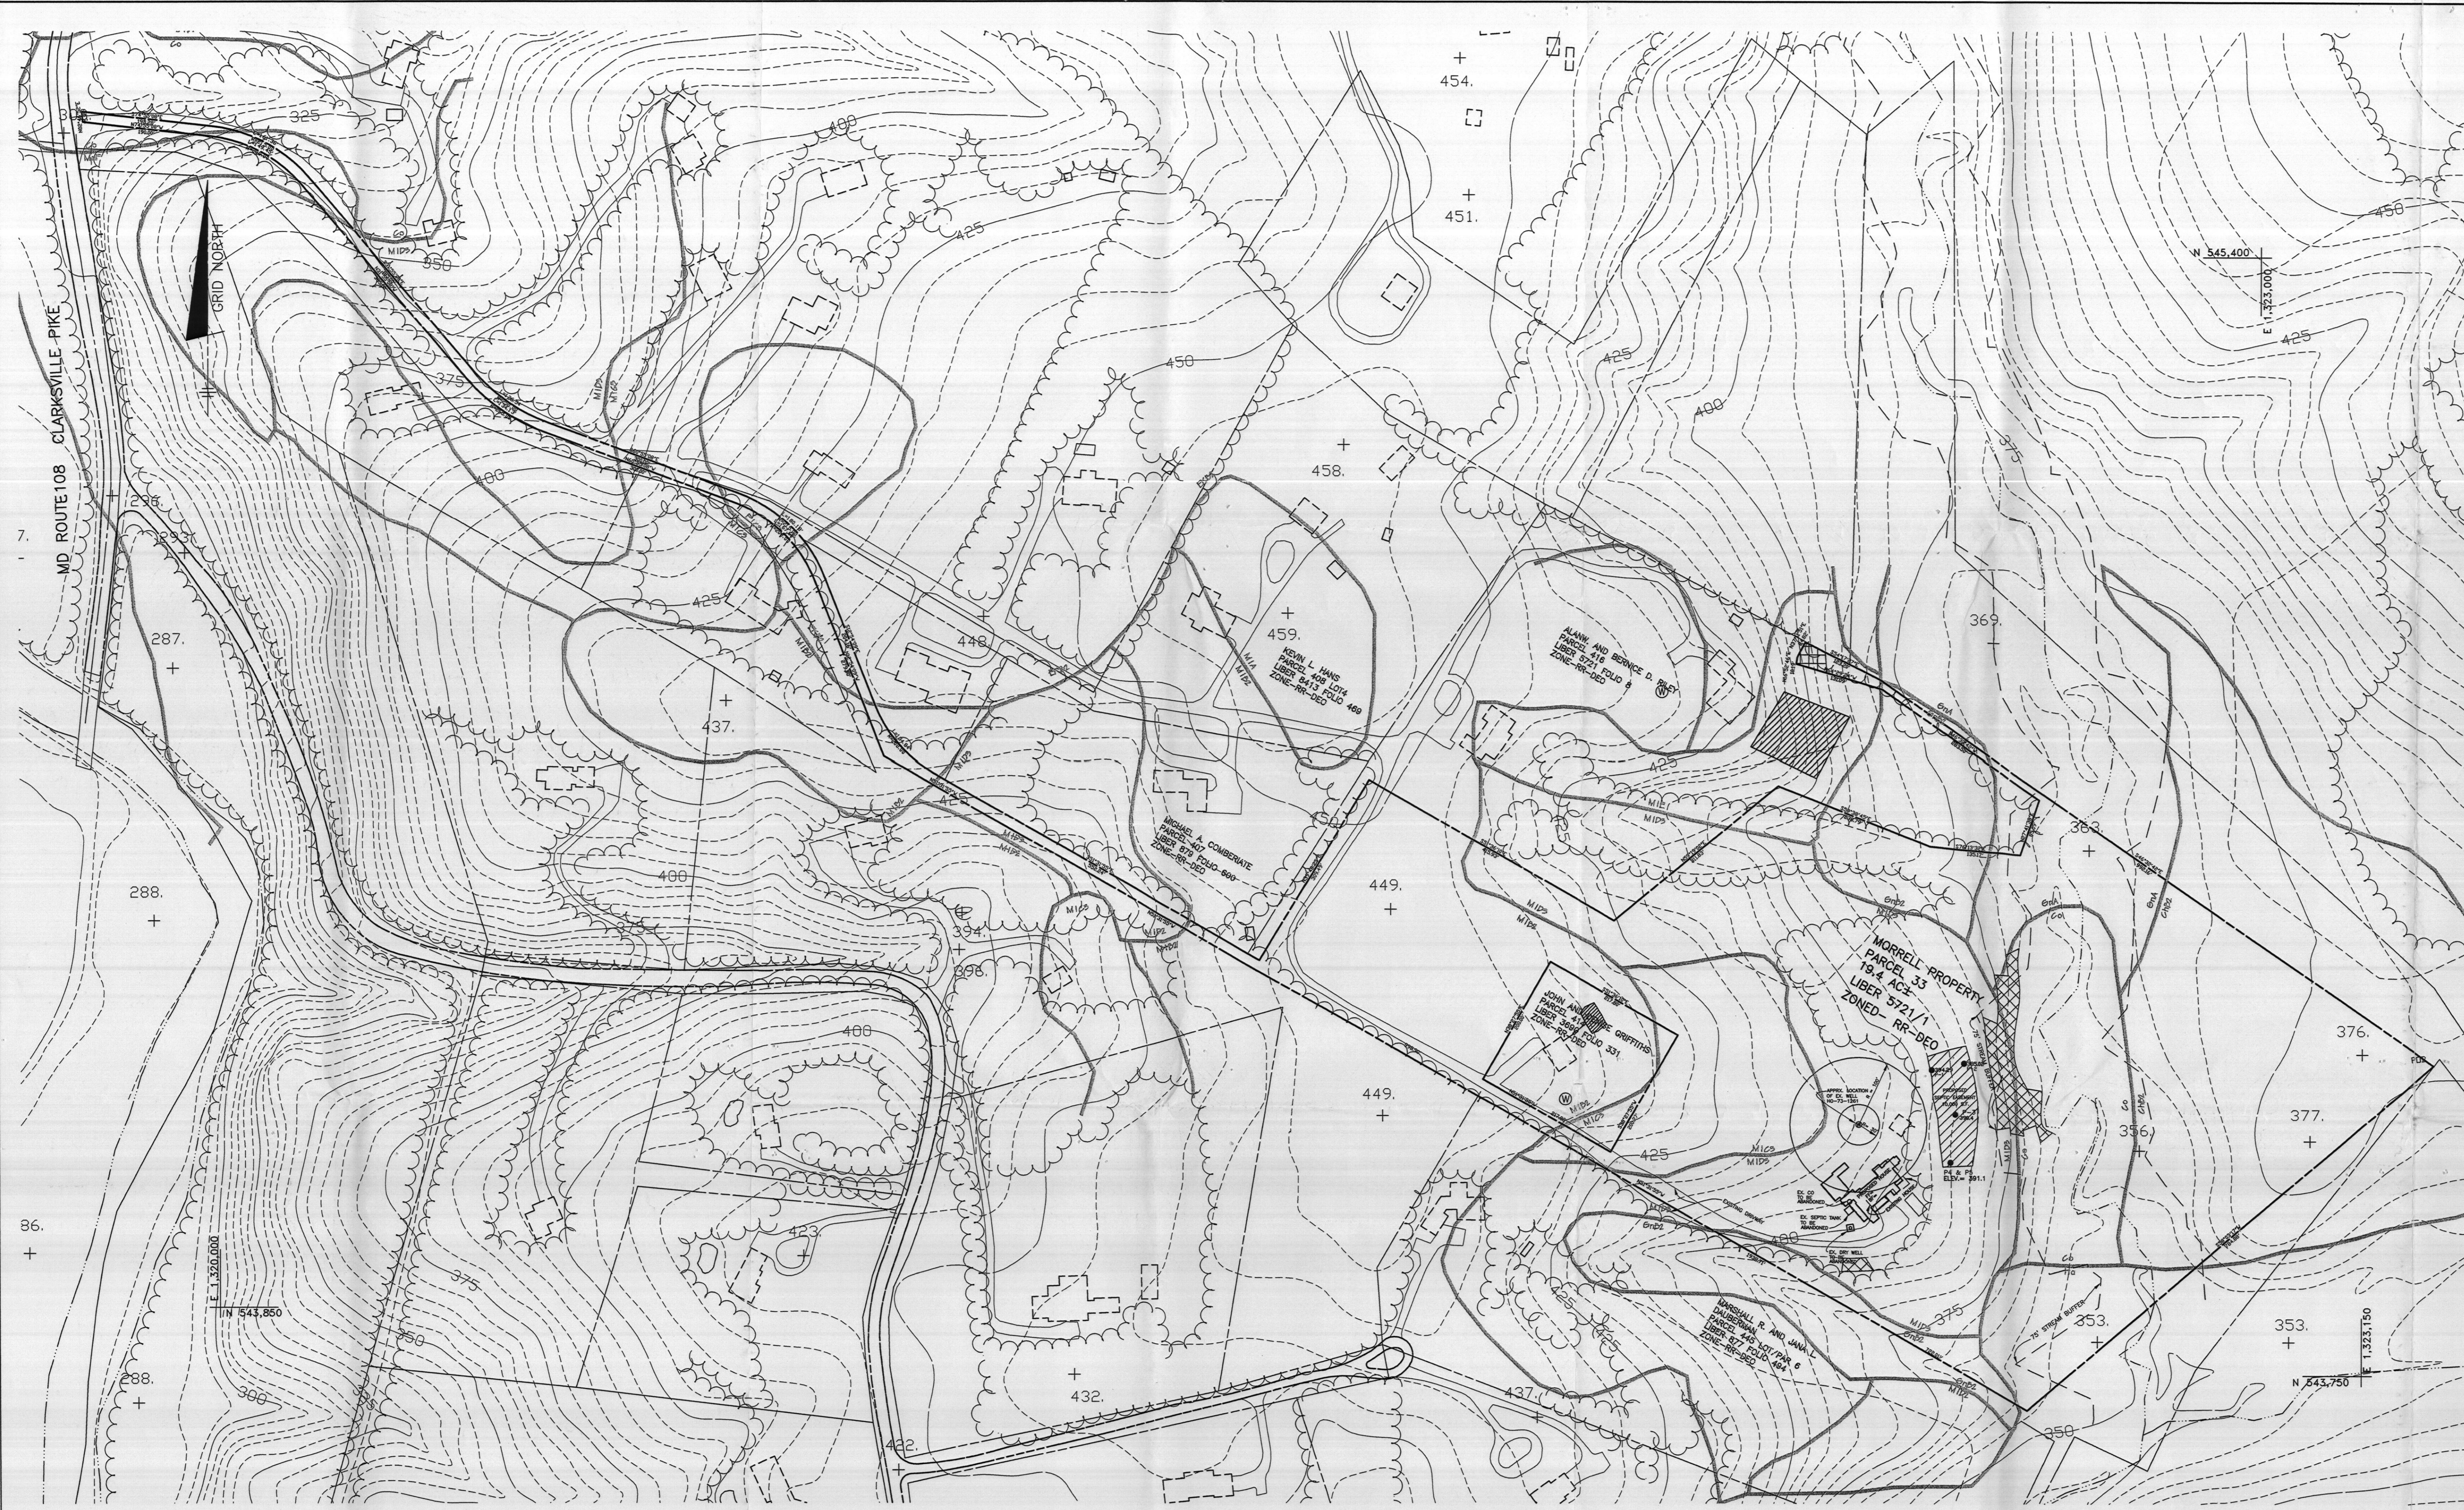

LEGEND

- EXISTING CONTOURS
- SOIL DIVISION LINE AND TYPE
- LIMIT OF SUBMISSION
- PROPOSED WELL
- EXISTING WELL
- PROPOSED SEPTIC AREA
- TEST PERC HOLE
- STEEP SLOPES 25% OR GREATER

VICINITY MAP
SCALE: 1"=2000'

SOILS LEGEND

MAP SYMBOL	SOIL GROUP	SOIL TYPE
CHB2	B	CHESTER SILT LOAM, 3 TO 8 PERCENT, MODERATELY ERODED
* Co	C	CODORUS SILT LOAM
EH2	C	ELIOLAK SILT LOAM, 3 TO 8 PERCENT SLOPES, MODERATELY ERODED
EI2	C	ELIOLAK SILKY CLAY LOAM, 8 TO 15 PERCENT SLOPES, SEVERELY ERODED
* G1A	C	GLENVILLE SILT LOAM, 0 TO 3 PERCENT SLOPES
* G1B2	C	GLENVILLE SILT LOAM, 3 TO 8 PERCENT SLOPES, MODERATELY ERODED
M1	D	HATBORO SILT LOAM
M12	B	MANOR LOAM, 3 TO 8 PERCENT SLOPES, MODERATELY ERODED
M13	B	MANOR LOAM, 8 TO 15 PERCENT SLOPES, MODERATELY ERODED
M122	B	MANOR LOAM, 15 TO 25 PERCENT SLOPES, MODERATELY ERODED
M132	B	MANOR LOAM, 15 TO 25 PERCENT SLOPES, SEVERELY ERODED
M1E	B	MANOR LOAM, 25 TO 45 PERCENT SLOPES
M1F	B	MANOR VERY STONY LOAM, 25 TO 60 PERCENT SLOPES

* INDICATES HYDRIC SOILS
TAKEN FROM SOIL SURVEY, HOWARD COUNTY, MARYLAND (ISSUED JULY 1988) MAP NO. 22

- GENERAL NOTES**
- THE LOTS SHOWN HEREON COMPLY WITH THE MINIMUM OWNERSHIP WIDTH AND LOT AREA AS REQUIRED BY THE MARYLAND STATE DEPARTMENT OF THE ENVIRONMENT.
 - THIS AREA DESIGNATES A PRIVATE SEWERAGE EASEMENT OF 10,000 S.F. AS REQUIRED BY THE MARYLAND STATE DEPARTMENT OF THE ENVIRONMENT FOR INDIVIDUAL SEWERAGE DISPOSAL. IMPROVEMENTS OF ANY NATURE IN THIS AREA ARE RESTRICTED UNTIL PUBLIC SEWER IS AVAILABLE. THIS EASEMENT SHALL BECOME NULL AND VOID UPON CONNECTION TO A PUBLIC SEWER SYSTEM. THE COUNTY HEALTH OFFICER SHALL HAVE THE AUTHORITY TO GRANT ADJUSTMENTS TO THE PRIVATE SEWERAGE EASEMENT. RECORDATION OF A MODIFIED SEWERAGE EASEMENT PLAT SHALL NOT BE REQUIRED.
 - UNLESS OTHERWISE SHOWN NO WELLS OR SEWERAGE EASEMENTS ARE LOCATED WITHIN 100 FEET OF THE PROPOSED WELL OR SEPTIC LOCATION.
 - TOPOGRAPHY SHOWN HEREON WAS PURCHASED FROM HOWARD COUNTY, GEOGRAPHICAL INFORMATION SYSTEMS BY BENCHMARK ENGINEERING, INC. AND FIELD VERIFIED.
 - THE EXISTING SEPTIC SYSTEM SHALL BE ABANDONED AND A NEW SYSTEM SHALL BE INSTALLED AT THE NEW SEPTIC EASEMENT LOCATION.

APPROVED: FOR PRIVATE WATER AND SEWER SYSTEMS
HOWARD COUNTY HEALTH DEPARTMENT

Richard Kn...
COUNTY HEALTH OFFICER KN 12/15/04 DATE

I CERTIFY THAT THE INFORMATION SHOWN HEREON IS BASED ON FIELD WORK PERFORMED BY ME OR UNDER MY DIRECT SUPERVISION, AND IS CORRECT, TO THE BEST OF KNOWLEDGE AND BELIEF.

Donald Mason 12/17/04
DONALD MASON
PLAN PREPARER

NO.	DATE	REVISION
BENCHMARK ENGINEERS & LAND SURVEYORS & PLANNERS ENGINEERING, INC. 8480 BALTIMORE NATIONAL PIKE & SUITE 418 ELLICOTT CITY, MARYLAND 21043 phone: 410-465-8105 & fax: 410-465-8644 www.bel-civilengineering.com		
DEVELOPER:		PROJECT:
JOHN MORRELL 13989 ROUTE 108 HIGHLAND, MARYLAND 20777 301-670-6144		MORRELL PROPERTY
LOCATION:		TITLE:
TAX MAP: 40, GRID: 15 PARCEL: 33 5th ELECTION DISTRICT HOWARD COUNTY, MARYLAND		PERCOLATION CERTIFICATION PLAN
DATE:	DECEMBER, 2004	PROJECT NO. 1787
DES: DAM	DRAFT: EDD	CHECK: DAM
SCALE: AS SHOWN	SHEET 1 OF 1	

PLAN VIEW
SCALE: 1" = 100'


COORDINATE TABLE		
NO.	NORTH	EAST
1	508670.55	822485.06
2	508993.42	822670.82
3	508398.94	823282.48
6	508222.93	823152.38
7	508276.24	823027.67
8	508215.89	822977.47
9	508243.54	822805.36
10	508450.95	822469.03

P. 347
N/F
GREGORY J. ABATE AND
ADRIANNA M. ABATE
ZONED: RC-DEO


P. 131
N/F
JOSEPH R. SAVARY, ET UX
L.444 F.429
ZONED: RC-DEO

EX. 30' INGRESS & EGRESS TO SERVE THE FOLLOWING DEEDS:

TAX MAP NO.	PAR. NO.	OWNERS NAME- N/F	LIBER	FOLIO
29	47	MICHAEL & DEBORAH SCHRIDER	7603	689
29	35	ELLA RYDZEWSKI & YERA SAVORY	863	306
29	45	JOSE & EILEEN ALMARIO	3866	668
29	43	RUSSELL SMITH	4982	18
29	42	PATRICK L. HINKSON	510	789
29	26	NATIONS BANK TRUST AS TRUSTEE OF HAROLD F. WATSON RESIDUARY TRUST	3663	152

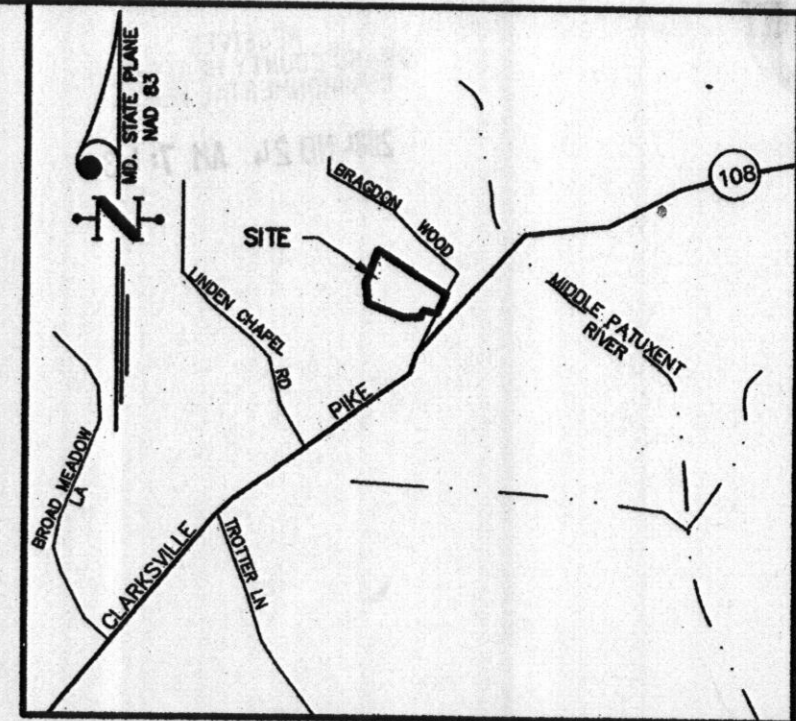

VICINITY MAP
SCALE: 1" = 2,000'

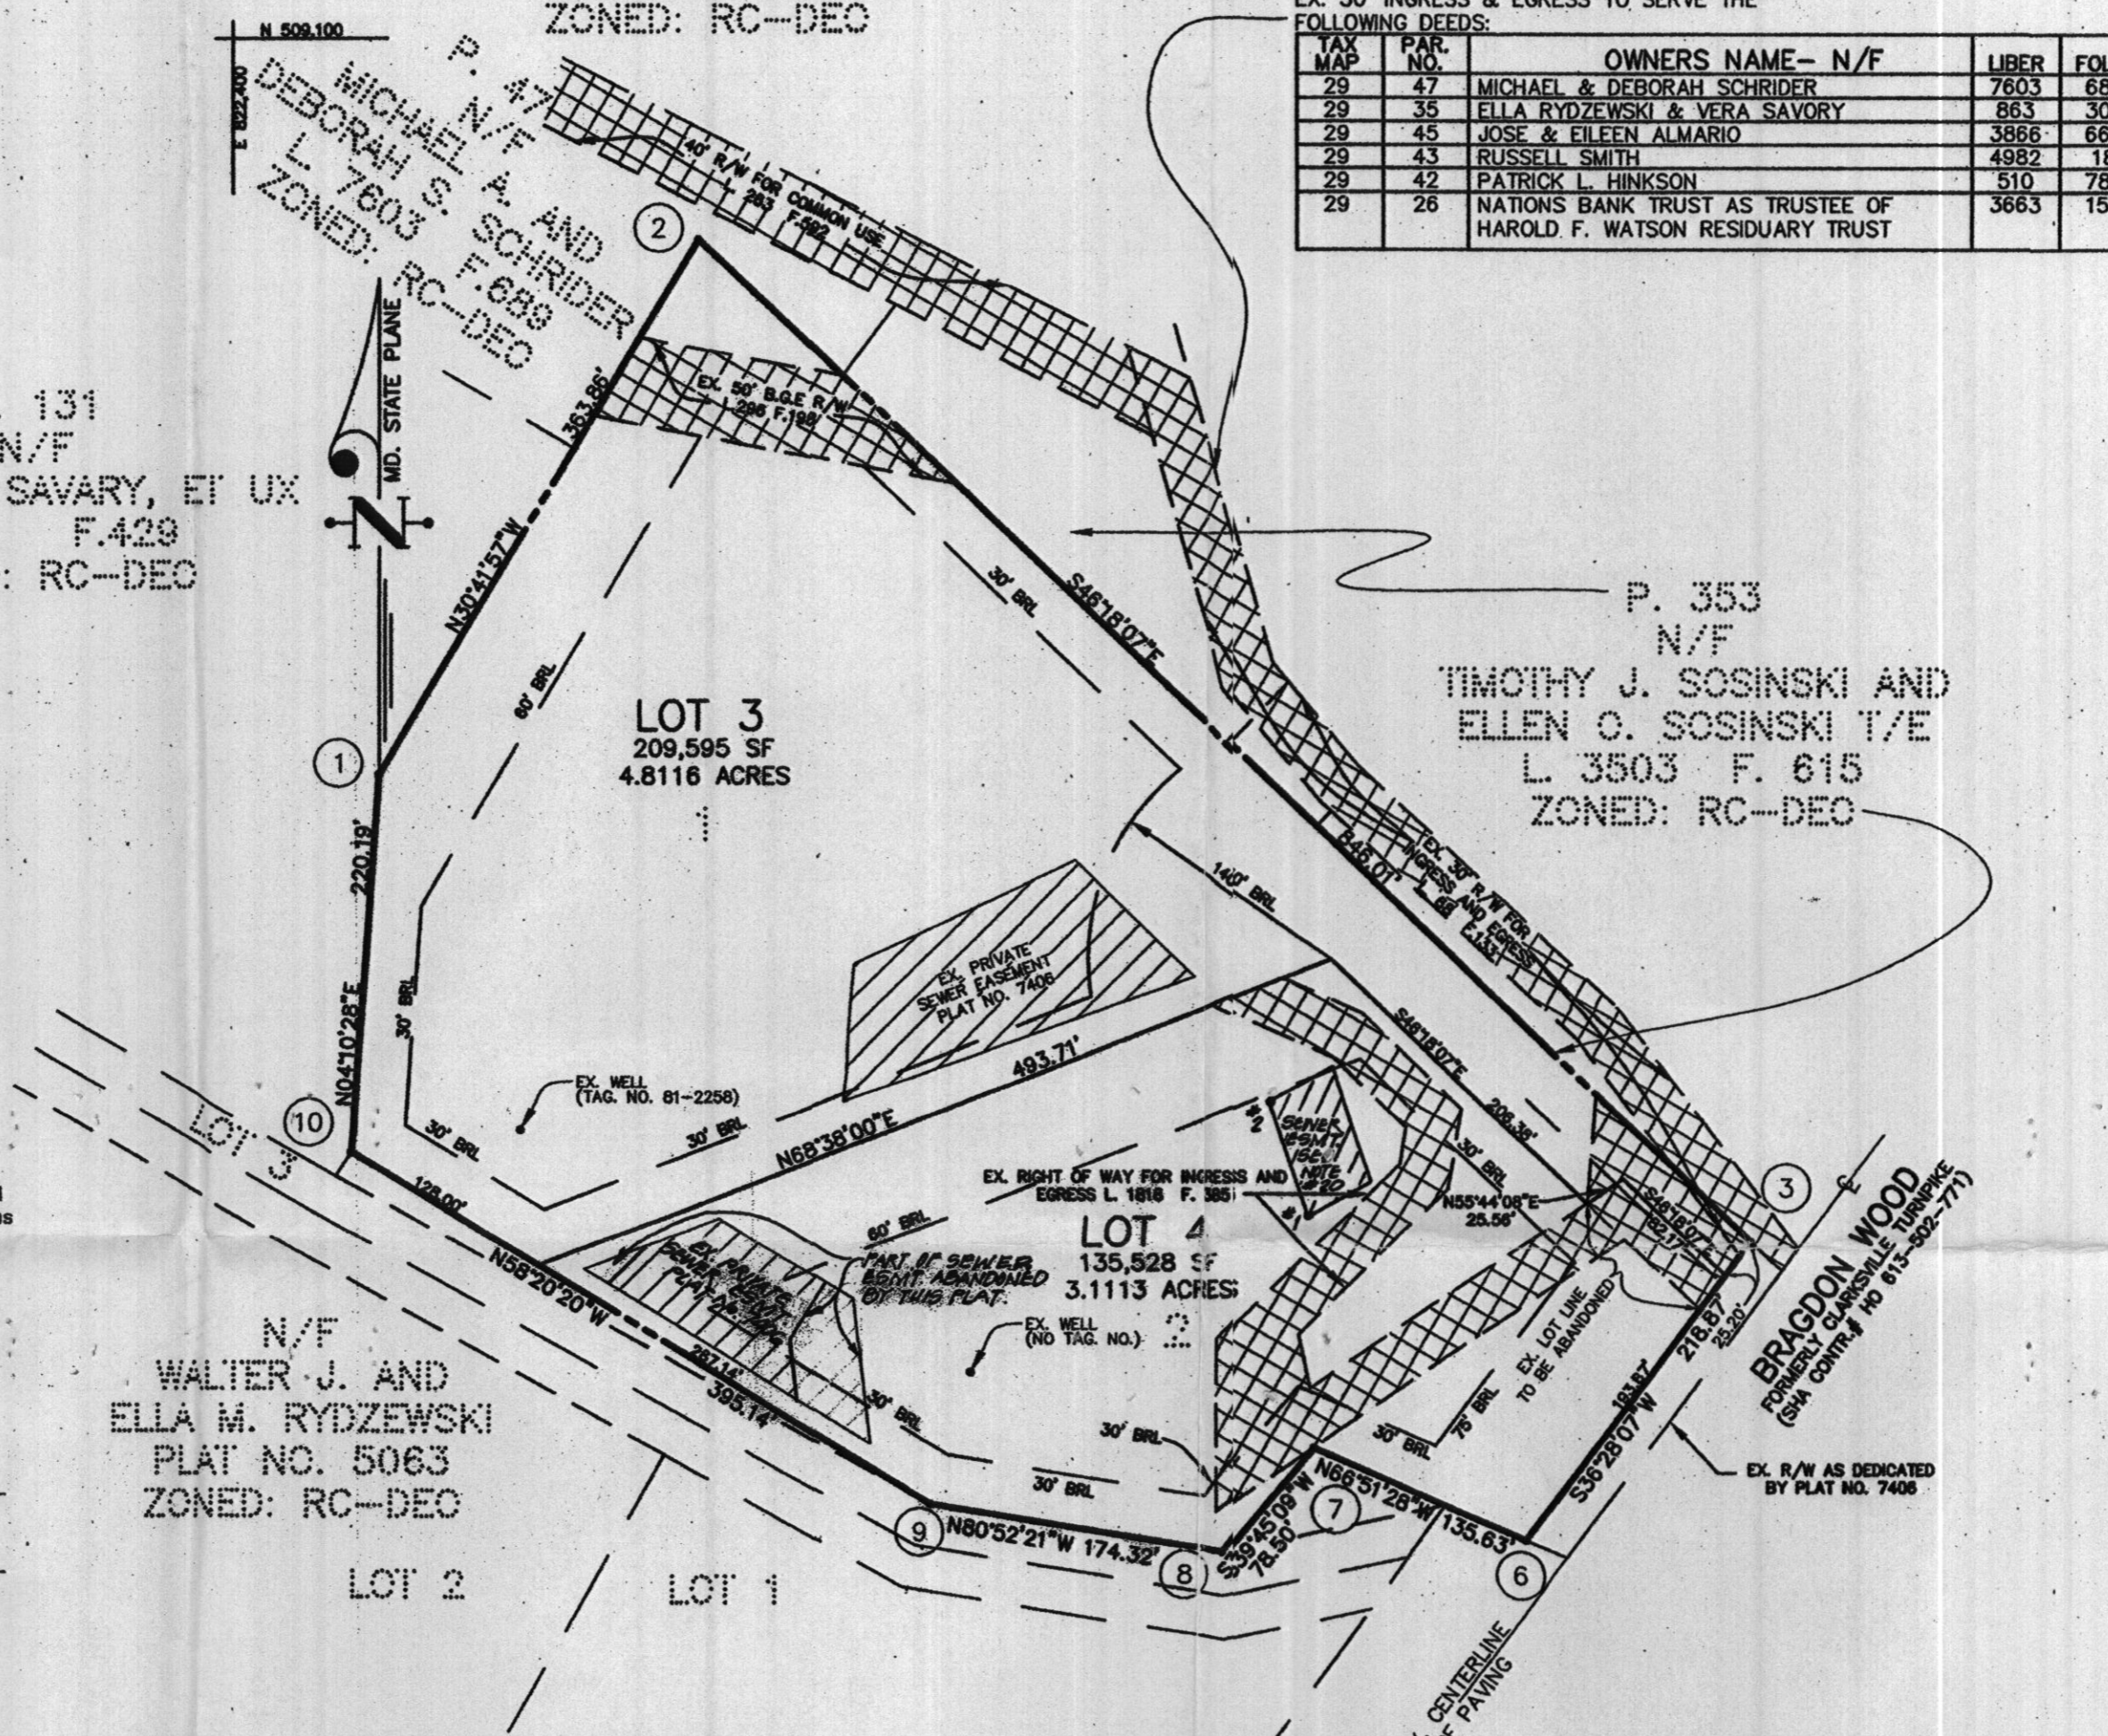

GENERAL NOTES

- SUBJECT PROPERTY IS ZONED RC-DEO PER FEBRUARY 2, 2004 COMPREHENSIVE ZONING PLAN.
- COORDINATES BASED ON MARYLAND STATE PLANE COORDINATE SYSTEM AS PROJECTED BY HOWARD COUNTY GEODETIC CONTROL STATIONS NO. 2638005 AND NO. 2738004
- B.R.L. DENOTES BUILDING RESTRICTION LINE ESTABLISHED BY ZONING.
- THIS PLAT IS BASED ON FIELD RUN MONUMENTED BOUNDARY SURVEY PERFORMED ON OR ABOUT MARCH, 1987 BY CLARK, FINEFROCK AND SACKETT, INC.
- DENOTES IRON PIN SET CAPPED
- DENOTES IRON PIPE OR BOUNDARY OR RIGHTS-OF-WAY
- DENOTES ANGULAR CHANGE IN BEARING OR BOUNDARY OR RIGHTS-OF-WAY
- DENOTES CONCRETE MONUMENT SET WITH ALUMINUM PLATE
- DENOTES STONE OR MONUMENT FOUND.
- FOR FLAG OR PIPE STEM LOTS, REFUSE COLLECTION, SNOW REMOVAL AND ROAD MAINTENANCE TO BE PROVIDED AT THE JUNCTION OF FLAG OR PIPE STEM AND THE ROAD R/W AND NOT ONTO THE FLAG OR PIPE STEM DRIVEWAY.
- DRIVEWAYS SHALL BE PROVIDED PRIOR TO RESIDENTIAL OCCUPANCY TO INSURE SAFE ACCESS FOR FIRE AND EMERGENCY VEHICLES PER THE FOLLOWING (MINIMUM) REQUIREMENTS:
 - WIDTH- 12 FEET (14 FEET SERVING MORE THAN ONE RESIDENCE);
 - SURFACE- SIX (6") INCHES OF COMPACTED CRUSHER RUN BASE WITH TAR AND CHIP COATING; (1 1/2" MINIMUM);
 - GEOMETRY- MAXIMUM 15% GRADE, MAXIMUM 10% GRADE CHANGE AND 45° TURNING RADIUS;
 - MAINTENANCE- SUFFICIENT TO INSURE ALL WEATHER USE.
- ALL LOT AREAS ARE MORE OR LESS ±
- DENOTES A 10,000 SQ. FT. PRIVATE SEWER EASEMENT AS REQUIRED BY THE MD. STATE DEPARTMENT OF HEALTH FOR INDIVIDUAL SEWAGE DISPOSAL; THE ■ DENOTES THE TRUE POSITIONS OF APPROVED PERCOLATION TESTS.
- IMPROVEMENTS IN THIS AREA ARE RESTRICTED UNTIL A PUBLIC SEWAGE SYSTEM IS AVAILABLE. THIS EASEMENT TO BE TERMINATED UPON CONNECTION TO A PUBLIC SEWAGE SYSTEM.
- DISTANCES SHOWN ARE BASED ON SURFACE MEASUREMENT AND NOT REDUCED TO GRID MEASUREMENT.
- THERE IS AN EXISTING DWELLING ON EXISTING LOT 1 AND 2. NO NEW BUILDINGS, EXTENSIONS OR ADDITIONS TO THE EXISTING DWELLING ARE TO BE CONSTRUCTED AT A DISTANCE LESS THAN THE ZONING REGULATIONS REQUIRE.
- THIS SUBDIVISION IS SUBJECT TO SECTION 18.122B OF THE HOWARD COUNTY CODE, PUBLIC WATER AND/OR SEWER SERVICE HAS BEEN GRANTED UNDER THE TERMS AND PROVISIONS, THEREOF, EFFECTIVE MARCH 25, 1996 ON WHICH DATE DEVELOPER AGREEMENT 24-3365-D WAS FILED AND ACCEPTED.
- THIS FINAL PLAT IS EXEMPT FROM THE FOREST CONSERVATION REQUIREMENTS IN ACCORDANCE WITH SECTION 18.102(b)(4)(d) OF THE HOWARD COUNTY CODE FOR A PLAT OF REVISION THAT DOES NOT CREATE ADDITIONAL LOTS.
- THIS PLAT OF REVISION IS EXEMPT FROM LANDSCAPING BECAUSE IT IS A PLAT OF RESUBDIVISION AND NO NEW LOTS ARE BEING CREATED.
- PREVIOUS FILE NUMBER IS F-87-206.
- ADDITIONAL SEWER EASEMENT AS REQUIRED BY HOWARD COUNTY HEALTH DEPARTMENT. *#1 AND *#2 DENOTES APPROVED PERCOLATION TESTS.

The requirements of § 3-108, The Real Property Article, Annotated Code of Maryland, 1988 Replacement Volume, (as supplemented) as far as they relate to the making of this plat and the setting of markers, have been complied with.

William L. Macher
WILLIAM L. MACHER
PROFESSIONAL LAND SURVEYOR

Gregory V. Meehan
GREGORY V. MEEHAN

Sarah Ann Meehan
SARAH ANN MEEHAN

Joseph R. Proulx
JOSEPH R. PROULX

Margaret Meehan
MARGARET MEEHAN

N/F
WALTER J. AND
ELLA M. RYDZEWSKI
PLAT NO. 5063
ZONED: RC-DEO

AREA TABULATION

1. TOTAL NUMBER OF LOTS TO BE RECORDED:	2
2. TOTAL NUMBER OF OPEN SPACE LOTS:	NONE
3. TOTAL AREA OF LOTS TO BE RECORDED:	7.9229 AC.
4. TOTAL AREA OF OPEN SPACE LOTS TO BE RECORDED:	0.00 AC.
5. TOTAL AREA OF ROAD RIGHT-OF-WAY TO BE RECORDED:	0.00 AC.
6. TOTAL AREA OF SUBDIVISION TO BE RECORDED:	7.9229 AC.

OWNERS:
NEW LOT 3
SARAH ANN MEEHAN AND
GREGORY V. MEEHAN
11735 BRAGDON WOOD
CLARKSVILLE, MD 21029

NEW LOT 4
JOSEPH R. PROULX AND
MARGARET MEEHAN
11731 BRAGDON WOOD
CLARKSVILLE, MD 21029



THE PURPOSE OF THIS PLAT IS TO REVISE THE COMMON LOT LINE OF OLD LOTS 1 AND 2 TO CREATE NEW LOTS 3 AND 4.

APPROVED: FOR PRIVATE WATER AND PRIVATE SEWERAGE SYSTEMS IN CONFORMANCE WITH THE MASTER PLAN FOR HOWARD COUNTY

CLARK · FINEFROCK & SACKETT, INC.
ENGINEERS · PLANNERS · SURVEYORS
7135 MINSTREL WAY · COLUMBIA, MD 21048 · (410) 381-7500 BALT. · (301) 621-8100 WASH.

APPROVED: HOWARD COUNTY DEPARTMENT OF PLANNING AND ZONING

Joseph A. B...
HOWARD COUNTY HEALTH OFFICER, JAB
9/27/04
DATE

OWNERS' CERTIFICATE

WE, GREGORY V. MEEHAN AND SARAH ANN MEEHAN, JOINT TENANTS WITH THE RIGHT OF SURVIVORSHIP, AND ALSO JOSEPH R. PROULX AND MARGARET MEEHAN, HIS WIFE, AS TENANTS BY THE ENTIRETIES, OWNERS OF THE PROPERTY SHOWN AND DESCRIBED HEREON HEREBY DO ADOPT THIS PLAN OF RESUBDIVISION AND IN CONSIDERATION OF THE APPROVAL OF THIS FINAL PLAT BY THE DEPARTMENT OF PLANNING AND ZONING, HEREBY ESTABLISH THE MINIMUM BUILDING RESTRICTION LINES AND GRANT UNTO HOWARD COUNTY, MARYLAND ITS SUCCESSORS AND ASSIGNS, (1) THE RIGHT TO LAY, CONSTRUCT AND MAINTAIN SEWERS, DRAINS, WATER PIPES AND OTHER MUNICIPAL UTILITIES AND SERVICES, IN AND UNDER ALL ROAD AND STREET RIGHT OF WAY AND THE SPECIFIC EASEMENT AREAS SHOWN HEREON; (2) THE RIGHT TO REQUIRE DEDICATION FOR PUBLIC USE, THE BEDS OF THE STREETS AND/OR ROADS AND FLOODPLAINS AND OPEN SPACE AREAS WHERE APPLICABLE; (3) AND FOR GOOD AND VALUABLE CONSIDERATION, HEREBY GRANT THE RIGHT AND OPTION TO HOWARD COUNTY TO ACQUIRE THE FEE SIMPLE TITLE TO THE BEDS OF THE STREETS AND/OR ROADS, FLOODPLAINS, STORM DRAINAGE EASEMENTS FOR THE SPECIFIC PURPOSE OF THERE CONSTRUCTION, REPAIR AND MAINTENANCE; AND (4) THAT NO BUILDING OR SIMILAR STRUCTURE OF ANY KIND SHALL BE ERRECTED ON OR OVER THE SAID EASEMENTS AND RIGHTS OF WAY.

Gregory V. Meehan
GREGORY V. MEEHAN

Sarah Ann Meehan
SARAH ANN MEEHAN

Joseph R. Proulx
JOSEPH R. PROULX

Margaret Meehan
MARGARET MEEHAN

WITNESSES:
Chester M. Zikowski
CHESTER M. ZIKOWSKI

Chester M. Zikowski
CHESTER M. ZIKOWSKI

Chester M. Zikowski
CHESTER M. ZIKOWSKI

SURVEYOR'S CERTIFICATE

I HEREBY CERTIFY THAT THE FINAL PLAT SHOWN AND DESCRIBED HEREON IS CORRECT; THAT IT IS A SUBDIVISION OF ALL THE LAND ACQUIRED BY GREGORY V. MEEHAN AND SARAH ANN MEEHAN JOINT TENANTS WITH RIGHTS OF SURVIVORSHIP, (OWNERS OF LOT 1) FROM SARAH ANN MEEHAN, BY DEED DATED SEPTEMBER 3, 2003 AND RECORDED IN LIBER 7734 AT FOLIO 317; AND ALSO THE LAND ACQUIRED BY JOSEPH R. PROULX AND MARGARET MEEHAN, HIS WIFE AS TENANTS BY THE ENTIRETIES, FROM GREGORY V. MEEHAN AND SARAH A. MEEHAN BY DEED DATED JULY 12, 1988 AND RECORDED IN LIBER 1855 AND FOLIO 104; THAT IT IS A RESUBDIVISION OF LOTS 1 AND 2 AS SHOWN ON A PLAT ENTITLED "MEEHAN SUBDIVISION LOTS 1 AND 2" AND RECORDED AS PLAT NO. 7406, ALL RECORDINGS IN THE LAND RECORDS OF HOWARD COUNTY, MARYLAND; AND THAT ALL MONUMENTS ARE IN PLACE OR WILL BE IN PLACE PRIOR TO THE ACCEPTANCE OF THE STREET AS SHOWN IN ACCORDANCE WITH THE ANNOTATED CODE OF MARYLAND, AS AMENDED.

William L. Macher
WILLIAM L. MACHER
PROFESSIONAL LAND SURVEYOR
MARYLAND REG. NO. 9011

12 July 2004
DATE

RECORDED AS PLAT 16967
ON October 6, 2004 AMONG THE LAND RECORDS OF HOWARD COUNTY, MARYLAND.

APPROVED: HOWARD COUNTY DEPARTMENT OF PLANNING AND ZONING

Mark D. Wiggall
CHIEF, DEVELOPMENT ENGINEERING DIVISION
9/7/04
DATE

Mark D. Wiggall
DIRECTOR
10/1/04
DATE

MEEHAN SUBDIVISION
LOTS 3 AND 4

A RESUBDIVISION OF LOTS 1 AND 2
PLAT NO 7406
TAX MAP #29 PARCEL 48
5TH (FIFTH) ELECTION DISTRICT
HOWARD COUNTY, MARYLAND
SCALE: 1" = 100' DATE: JULY, 2004
PREVIOUS SUBMITTALS: F-87-206
SHEET 1 OF 1

J:\SURVEY\2004\04032\DWG\04032RSP.DWG
CHKD: MA DRAWN: JPH JOB NO.: 04032 FILE NO.: 86-081