



APPLICATION

FOR PERCOLATION TESTING AND SITE EVALUATION

TEST DATE(S) _____ TEST TIME _____

AP 520082-A

AGENCY REVIEW: _____

DATE 3/5/14

DO NOT WRITE ABOVE THIS LINE

HEREBY APPLY FOR THE NECESSARY TESTING/EVALUATION PRIOR TO ISSUANCE OF SEWAGE DISPOSAL SYSTEM PERMIT(S) TO:

- CHECK AS NEEDED:
- CONSTRUCT NEW SEPTIC SYSTEM(S)
 - REPAIR/ADD TO AN EXISTING SEPTIC SYSTEM
 - REPLACE AN EXISTING SEPTIC SYSTEM

- CHECK AS NEEDED:
- NEW STRUCTURE(S)
 - ADDITION TO AN EXISTING STRUCTURE
 - REPLACE AN EXISTING STRUCTURE

- CHECK ONE:
- CREATE NEW LOT(S)
 - BUILD ON AN EXISTING LOT IN A SUBDIVISION
 - BUILD ON AN EXISTING PARCEL OF RECORD

- IS THE PROPERTY WITHIN 2500' OF ANY RESERVOIR?
- YES
 - NO

THE TYPE OF STRUCTURE IS:

- RESIDENTIAL WITH UNKNOWN PROPOSED BEDROOMS IN THE COMPLETED STRUCTURE (NOTE UNKNOWN IF APPROPRIATE)
- COMMERCIAL (PROVIDE DETAIL OF NUMBERS AND TYPES OF EMPLOYEES/ CUSTOMERS ON ACCOMPANYING PLAN)
- INSTITUTIONAL/GOVERNMENT (PROVIDE DETAIL OF NUMBERS AND TYPES OF EMPLOYEES/USERS ON ACCOMPANYING PLAN)

PROPERTY OWNER(S) PRINCE FLORENCE UNDINE

DAYTIME PHONE _____ CELL _____ FAX _____

MAILING ADDRESS

STREET	CITY/TOWN	STATE	ZIP
--------	-----------	-------	-----

APPLICANT Hailey Development c/o Rich Thometz

DAYTIME PHONE (301) 476-7715 CELL (301) 346-1037 FAX (301) 476-7717

MAILING ADDRESS 3905 NATIONAL DRIVE, SUITE 105, BURTONSVILLE MD. 20866

STREET	CITY/TOWN	STATE	ZIP
--------	-----------	-------	-----

APPLICANT'S ROLE: DEVELOPER BUILDER BUYER RELATIVE/FRIEND REALTOR CONSULTANT

PROPERTY LOCATION
SUBDIVISION/PROPERTY NAME PRINCE PROPERTY LOT NO. 2

PROPERTY ADDRESS END OF HUNTERBROOKE LANE / HUNTFIELD DRIVE

STREET	TOWN/POST OFFICE
--------	------------------

AX MAP PAGE(S) 46 GRID 137 PARCEL(S) 104 PROPOSED LOT SIZE 4 AC. +

AS APPLICANT, I UNDERSTAND THE FOLLOWING: THE SYSTEM INSTALLED SUBSEQUENT TO THIS APPLICATION IS ACCEPTABLE ONLY UNTIL PUBLIC SEWERAGE IS AVAILABLE. THIS APPLICATION IS COMPLETE WHEN ALL APPLICABLE FEES AND A DETAILED SITE PLAN HAVE BEEN RECEIVED. I ACCEPT THE RESPONSIBILITY FOR COMPLIANCE WITH ALL M.O.S.H.A. AND "MISS UTILITY" REQUIREMENTS. APPROVAL IS BASED UPON SATISFACTORY REVIEW OF A PERC CERTIFICATION PLAN.

TEST RESULTS WILL BE MAILED TO APPLICANT. Zacharia G. Frisch (agent for Developer)
SIGNATURE OF APPLICANT

HOWARD COUNTY HEALTH DEPARTMENT, BUREAU OF ENVIRONMENTAL HEALTH, WELL AND SEPTIC PROGRAM
 3325-H ELLICOTT MILLS DRIVE, ELLICOTT CITY, MARYLAND 21043-4544 (410) 313-1771 FAX (410) 313-2648
 TDD (410) 313-2323 TOLL FREE 1-877-4MD-DHMH

AP

607
 orange
 silty lm

6
 brn gray
 sae m lm

25%
 frags

12 1/2


609
 orange
 hvy lm

5
 H. brn
 tan
 gray
 sae m
 10-15%
 frags

9 HARD BOT

608
 bands
 orange
 hvy lm
 and
 orange
 sae m

11
 13 1/2
 brn
 sae m
 5% Rx

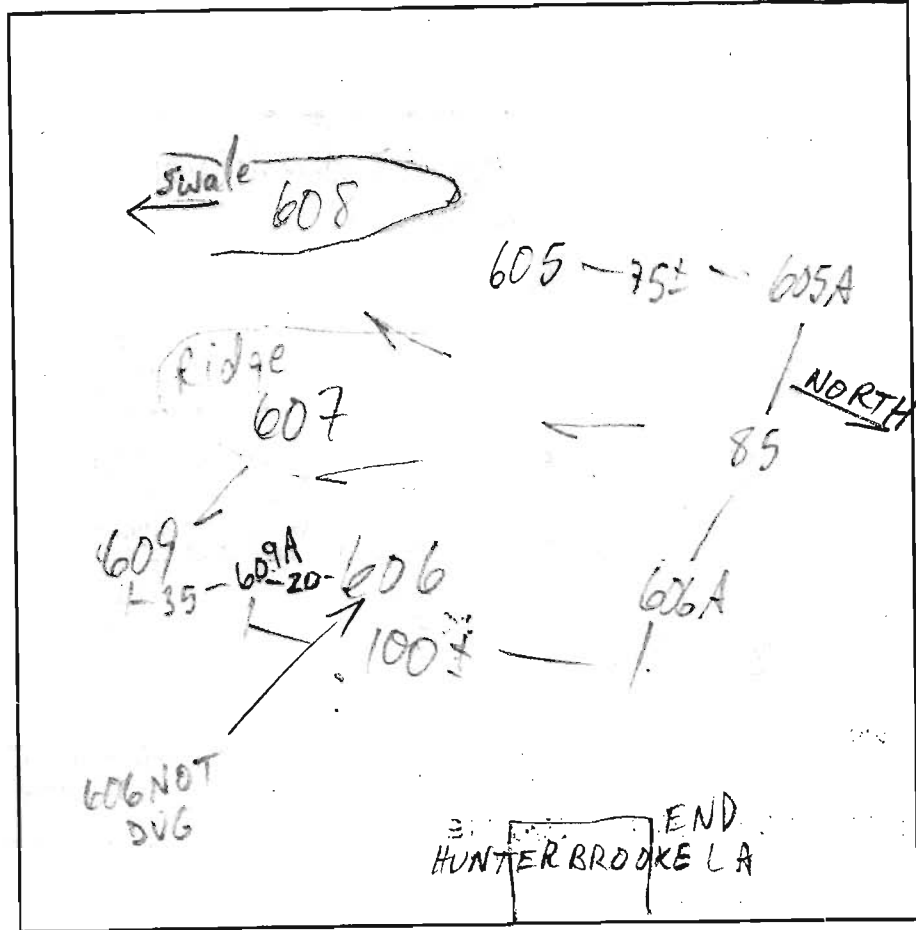

605
 orange
 red
 hvy lm

605A
 tan si
 sae m
 15%
 frags

609A
 orange
 brn
 hvy lm

608A
 H. brn
 tan gray
 sae m
 15%
 frags

606A
 orange
 red
 hvy lm

6
 10
 tan
 sae m
 15-20%
 frags

DATE	TEST #	DEPTH	START	BREAK 1" DROP	STOP 2" DROP	TIME OF 2ND INCH	P/F/H
4/14/04	607 M	8 12 1/2	10:42	10:46	10:53	7 EST	P
	609 S	5 9	10:49	11:01	11:02		F
	608 V	13 1/2					P
	605 V	7 14	11:13	11:22	11:39	17	P
	609A S	13					P
	606A S	6 12	11:32	11:33	11:35	2	P
	605A S	13					P

REMARKS HOLES 605A, 606A, 609A NOT PER PLAN

SANITARIAN M. Riskin BACKHOE K4K OTHERS Hailey Dev

TEST HOLES USED IN SDA 605, 605A, 606A, 609A AVG. PERC TIME 10 SQ. FT/BR 210

TRENCH WIDTH 2 INLET DEPTH 4 MAX. BOT DEPTH 8 EFFECTIVE SW 0-2