



Howard County Health Department

11 A.M. 7/30/03

APPLICATION

FOR PERCOLATION TESTING AND SITE EVALUATION

TEST DATE(S) 7/30/03 TEST TIME _____ A/P A519060

AGENCY REVIEW: perc to support 2BR Add'n to ex. 3 BR HOUSE DATE 7/18/2003

DO NOT WRITE ABOVE THIS LINE

I HEREBY APPLY FOR THE NECESSARY TESTING/EVALUATION PRIOR TO ISSUANCE OF SEWAGE DISPOSAL SYSTEM PERMIT(S) TO:

- CHECK AS NEEDED:
- CONSTRUCT NEW SEPTIC SYSTEM(S)
 - REPAIR/ADD TO AN EXISTING SEPTIC SYSTEM
 - REPLACE AN EXISTING SEPTIC SYSTEM

- CHECK AS NEEDED:
- NEW STRUCTURE(S)
 - ADDITION TO AN EXISTING STRUCTURE
 - REPLACE AN EXISTING STRUCTURE

- CHECK ONE:
- CREATE NEW LOT(S)
 - BUILD ON AN EXISTING LOT IN A SUBDIVISION
 - BUILD ON AN EXISTING PARCEL OF RECORD

- IS THE PROPERTY WITHIN 2500' OF ANY RESERVOIR?
- YES
 - NO

THE TYPE OF STRUCTURE IS:

- RESIDENTIAL WITH 5 PROPOSED BEDROOMS IN THE COMPLETED STRUCTURE (NOTE **UNKNOWN** IF APPROPRIATE)
- COMMERCIAL (PROVIDE DETAIL OF NUMBERS AND TYPES OF EMPLOYEES/ CUSTOMERS ON ACCOMPANYING PLAN)
- INSTITUTIONAL/GOVERNMENT (PROVIDE DETAIL OF NUMBERS AND TYPES OF EMPLOYEES/USERS ON ACCOMPANYING PLAN)

PROPERTY OWNER(S) Louis Charles DiBartolomeo

DAYTIME PHONE 410-549-1216 CELL _____ FAX _____

MAILING ADDRESS 8595 Old Frederick Rd. Ellicott City MD 21043
STREET CITY/TOWN STATE ZIP

APPLICANT Louis Charles DiBartolomeo

DAYTIME PHONE 410-549-1216 CELL _____ FAX _____

MAILING ADDRESS 8595 Old Frederick Rd
STREET CITY/TOWN STATE ZIP

APPLICANT'S ROLE: DEVELOPER BUILDER BUYER RELATIVE/FRIEND REALTOR CONSULTANT

PROPERTY LOCATION SUBDIVISION/PROPERTY NAME _____ LOT NO. _____

PROPERTY ADDRESS 8595 Old Fred Rd 21043
STREET TOWN/POST OFFICE

TAX MAP PAGE(S) 18 GRID 7 PARCEL(S) 298 PROPOSED LOT SIZE _____

AS APPLICANT, I UNDERSTAND THE FOLLOWING: THE SYSTEM INSTALLED SUBSEQUENT TO THIS APPLICATION IS ACCEPTABLE ONLY UNTIL PUBLIC SEWERAGE IS AVAILABLE. THIS APPLICATION IS COMPLETE WHEN ALL APPLICABLE FEES AND A SUITABLE SITE PLAN HAVE BEEN RECEIVED. I ACCEPT THE RESPONSIBILITY FOR COMPLIANCE WITH ALL M.O.S.H.A. AND "MISS UTILITY" REQUIREMENTS. APPROVAL IS BASED UPON SATISFACTORY REVIEW OF A PERC CERTIFICATION PLAN.

TEST RESULTS WILL BE MAILED TO APPLICANT. Louis DiBartolomeo
SIGNATURE OF APPLICANT

HOWARD COUNTY HEALTH DEPARTMENT, BUREAU OF ENVIRONMENTAL HEALTH, WELL AND SEPTIC PROGRAM
3525-H ELLICOTT MILLS DRIVE, ELLICOTT CITY, MARYLAND 21043-4544 (410) 313-1771 FAX (410) 313-2648
TDD (410) 313-2323 TOLL FREE 1-877-4MD-DHMH

A/P ① ③

14. brn
hvy lm
& hvy sa
lm

5

tan
beige
sand
10% frags
pockets
@ 25%

12-
12 1/2


② ④

14. brn
brn hvy
lm &
hvy sa lm

4-
5 1/2


tan beige
sand
20-25%
frags
HARD BOT

9 1/2
10

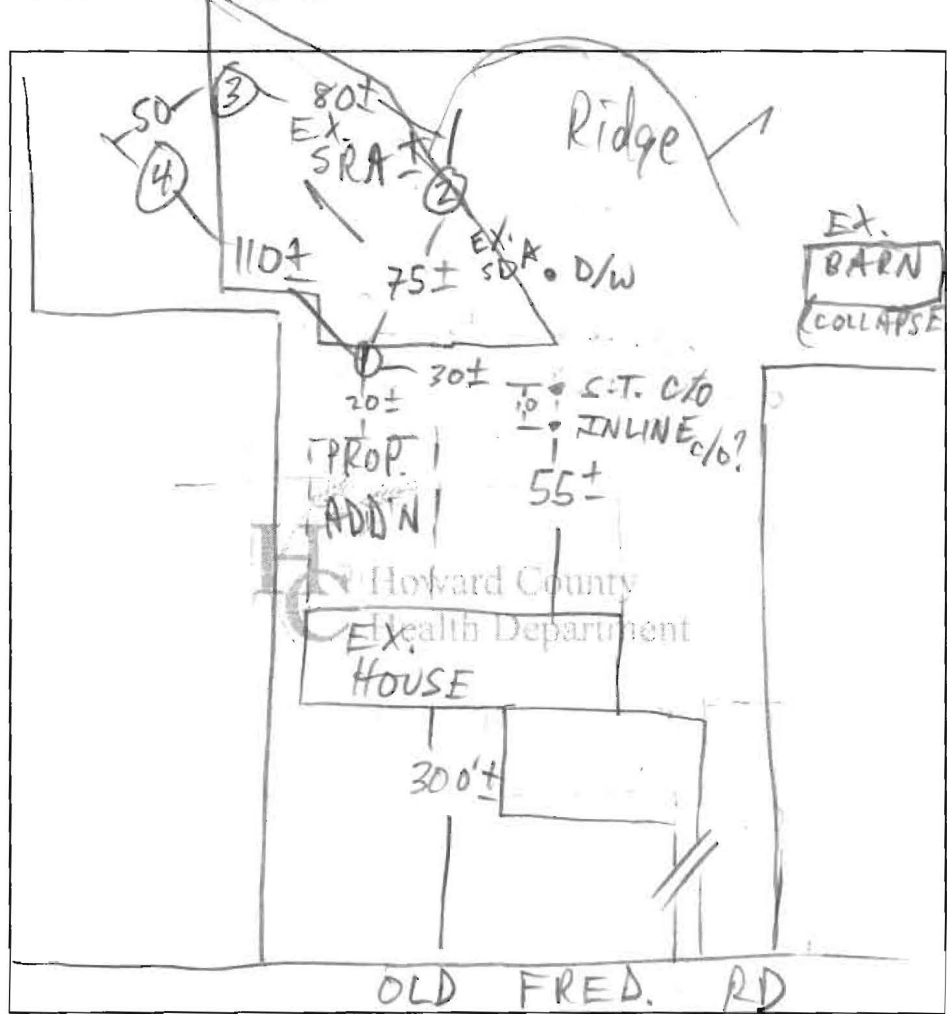

DATE	TEST #	DEPTH	START	BREAK 1" DROP	STOP 2" DROP	TIME OF 2nd INCH	P/F/H
7/30/03	1 V	12 1/2					P
	2 V	10	HARD	BOTTOM			P
	3 V	12					P
	4 V	9 1/2	HARD	BOTTOM			P

REMARKS _____
 SANITARIAN M. Ritkin BACKHOE _____ OTHERS owner
 TEST HOLES USED IN SDA All AVG. PERC TIME < 7 SQ. FT/BR 180
 TRENCH WIDTH 3 INLET DEPTH 3 1/2 MAX. BOT DEPTH 5 1/2 EFFECTIVE SW 0.5' OR LESS

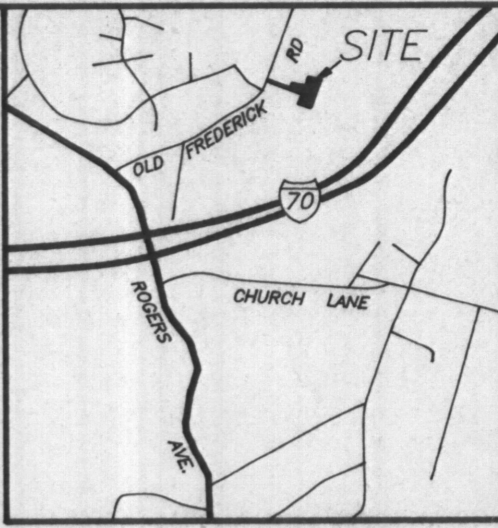

VICINITY MAP
SCALE: 1"=2000'

NOTES:

1. THE TOPOGRAPHY SHOWN HEREON WAS FIELD-RUN BY SHANABERGER & LANE ON OCTOBER 14, 2003.
2. B.R.L. DESIGNATES BUILDING RESTRICTION LINE
 ● DESIGNATES APPROVED PERC TEST
 ○ DESIGNATES FAILED PERC TEST
 ▲ DESIGNATES EX. WELL
3. THIS AREA DESIGNATES A PROPOSED PRIVATE SEWAGE DISPOSAL AREA AS REQUIRED BY THE MARYLAND STATE DEPARTMENT OF THE ENVIRONMENT FOR INDIVIDUAL SEWAGE DISPOSAL IMPROVEMENTS OF ANY NATURE IN THIS AREA ARE RESTRICTED. THIS DISPOSAL AREA SHALL BECOME NULL & VOID UPON CONNECTION TO A PUBLIC SEWAGE SYSTEM. THE COUNTY HEALTH OFFICER SHALL HAVE THE AUTHORITY TO GRANT ADJUSTMENTS TO THE PRIVATE SEWAGE DISPOSAL AREA.
4. PRIVATE SEWAGE DISPOSAL AREA PER PREVIOUS PERC CERT DATED 6/4/78.
5. THE LOTS SHOWN HEREON COMPLY WITH THE MINIMUM OWNERSHIP AND LOT AREA AS REQUIRED BY THE MD STATE DEPARTMENT OF THE ENVIRONMENT.
6. SUBJECT PROPERTY ZONED: R-20
7. TOTAL PROPERTY AREA PER DEED L.7302/F.111: 2.007 AC.±
8. THE EXISTING HOUSE IS SERVED BY PUBLIC WATER IN OLD FREDERICK RD. (CONT. TO W)
9. ALL VISIBLE EXISTING WELLS & SEPTIC AREAS WITHIN 100' OF THE PROPERTY LINES HAVE BEEN SHOWN.
10. SEPTIC SYSTEM UPGRADE TO BE INSTALLED PRIOR TO ISSUANCE OF A BUILDING PERMIT FOR THE PROPOSED ADDITION.

APPROVED: FOR PUBLIC WATER & PRIVATE SEWAGE SYSTEMS.
HOWARD COUNTY HEALTH DEPARTMENT.

Penny Branta 12-3-03
COUNTY HEALTH OFFICER HR DATE

PERC CERTIFICATION

I CERTIFY THAT THE LOCATIONS SHOWN (●) HEREON ARE BASED ON FIELD-LOCATIONS DONE UNDER MY DIRECT SUPERVISION, AND ARE CORRECT TO THE BEST OF MY PROFESSIONAL KNOWLEDGE &


G. Scott Shanaberger
G. SCOTT SHANABERGER DATE 11/19/2003

SHANABERGER & LANE
8726 TOWN & COUNTRY BLVD.
SUITE 201
ELLCOTT CITY, MD. 21043
PHONE: 410-461-9563
FAX: 410-461-9693



Signed FIELD-LOCATED PERC. TEST PLAT
PROPERTY OF
LOUIS & MARY DIBARTOLOMEO
L.7302/F.111

TAX MAP 18 PARCEL 298
2ND ELECTION DIST. HOWARD CO.,MD.
SCALE:1"=30' NOVEMBER 17, 2003
PC 519060

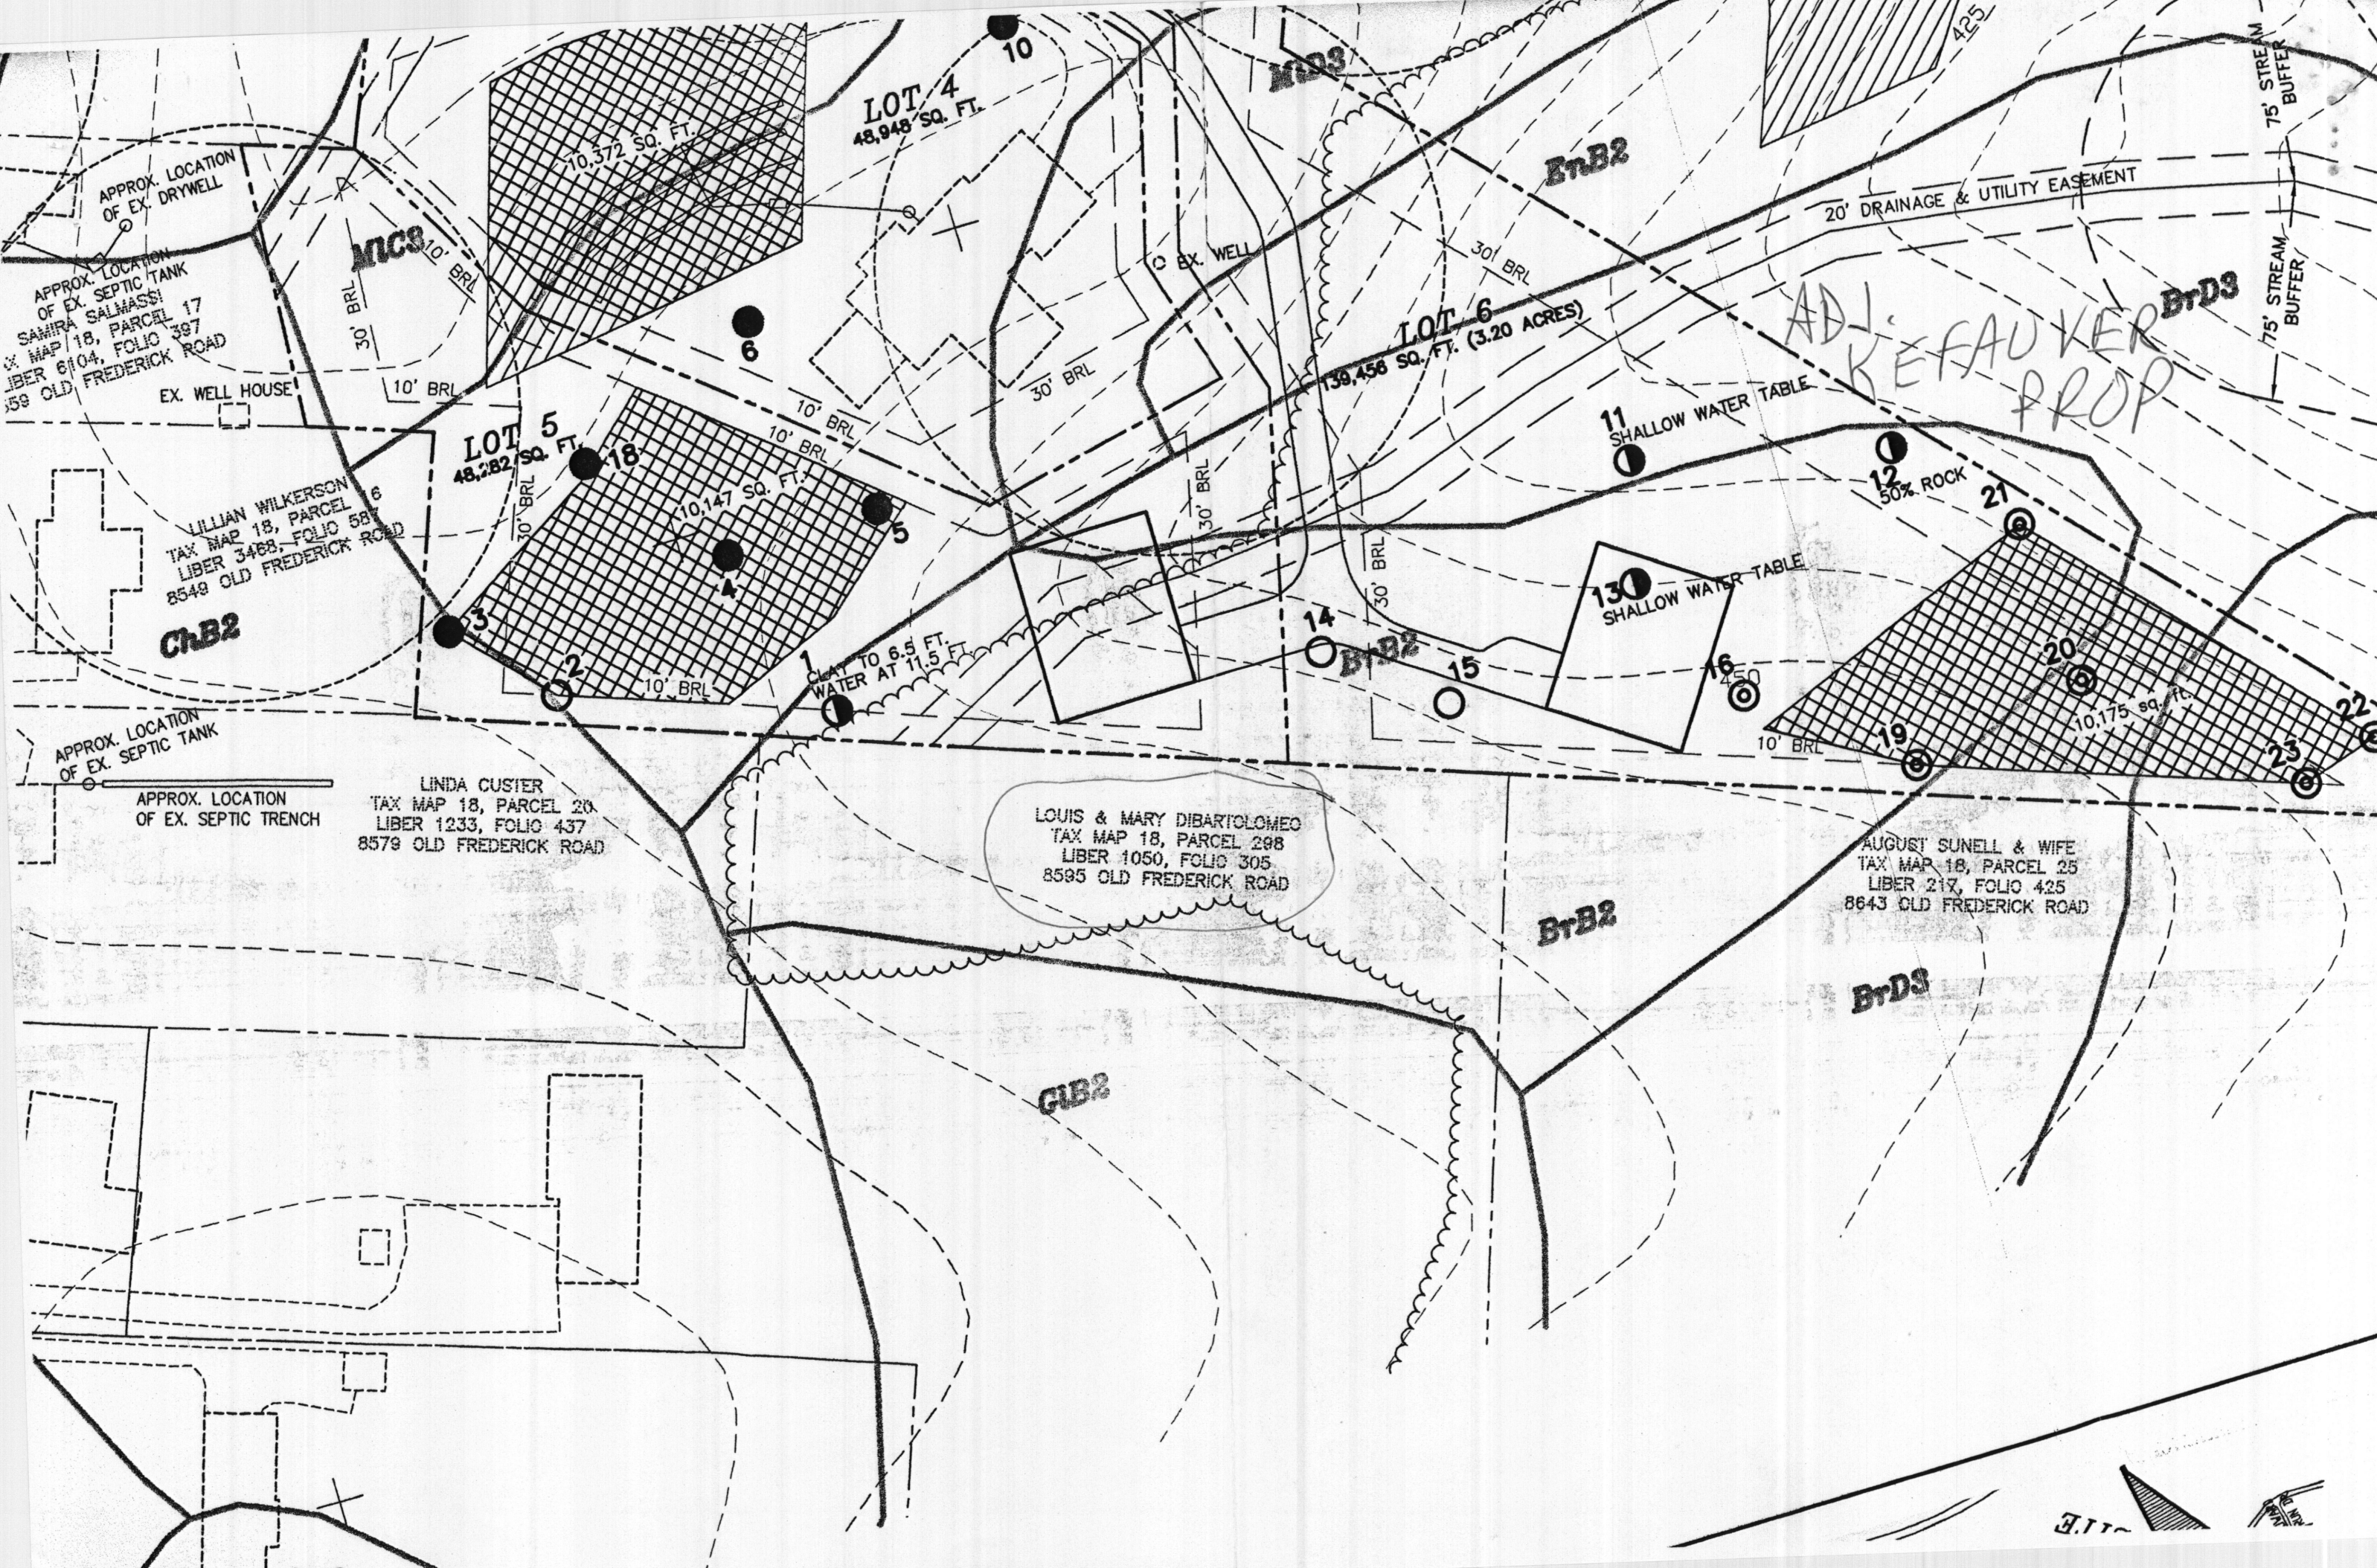

APPROX. LOCATION OF EX. DRYWELL
APPROX. LOCATION OF EX. SEPTIC TANK
SAMIRA SALMASSI
TAX MAP 18, PARCEL 17
LIBER 6104, FOLIO 387
359 OLD FREDERICK ROAD

LILLIAN WILKERSON
TAX MAP 18, PARCEL 6
LIBER 3468, FOLIO 587
8549 OLD FREDERICK ROAD

APPROX. LOCATION OF EX. SEPTIC TANK
APPROX. LOCATION OF EX. SEPTIC TRENCH

LINDA CUSTER
TAX MAP 18, PARCEL 20
LIBER 1233, FOLIO 437
8579 OLD FREDERICK ROAD

LOUIS & MARY DIBARTOLOMEO
TAX MAP 18, PARCEL 298
LIBER 1050, FOLIO 305
8595 OLD FREDERICK ROAD

AUGUST SUNELL & WIFE
TAX MAP 18, PARCEL 25
LIBER 217, FOLIO 425
8643 OLD FREDERICK ROAD

ADJ. KEFAUVER PROP

