

PRELIMINARY

APPLICATION

18868

SEWAGE DISPOSAL TESTING

STATE OF MARYLAND - DEPARTMENT OF HEALTH AND MENTAL HYGIENE

HOWARD COUNTY HEALTH DEPARTMENT
ENVIRONMENTAL HEALTH SERVICES
P. O. BOX 476, ELLICOTT CITY, MARYLAND 21043
TELEPHONE: 588-8800, EXT. 350

DISTRICT 9th
DATE 8/7/73

TO: THE COUNTY HEALTH OFFICER
ELLICOTT CITY, MARYLAND

I, HEREBY, APPLY FOR THE NECESSARY TEST IN ORDER TO CONSTRUCT (OR RECONSTRUCT) A SEWAGE DISPOSAL SYSTEM.

PROPERTY OWNER V. L. Visalla

ADDRESS 12631 Circle Drive, Glen Hills, Rockville, MD. PHONE 762-3007

PROPERTY LOCATION:

SUBDIVISION Green Hill Manor LOT NO. 3, Blk. D, Sec. 3

ROAD AND DESCRIPTION Optima Drive

SIZE OF LOT 40,787 sq. ft. TYPE BLDG. 3 of 4 buildings

IF NOT SINGLE RESIDENCE DESCRIBE _____
NUMBER OF BEDROOMS

THE SYSTEM INSTALLED UNDER THIS APPLICATION IS ACCEPTABLE ONLY UNTIL PUBLIC FACILITIES BECOME AVAILABLE.

SIGNATURE OF APPLICANT /s/ V. L. Visalla

APPROVED BY _____ FOR _____ DATE _____
(KIND OF SYSTEM)

REJECTED BY _____ FOR _____ DATE _____
(KIND OF SYSTEM)


HOLD PENDING FURTHER TESTS _____ DATE _____

REASONS FOR REJECTION OR HOLDING _____

THIS IS NOT A PERMIT

APPLICATION

STATE OF MARYLAND - DEPARTMENT OF HEALTH AND MENTAL HYGIENE
 HOWARD COUNTY HEALTH DEPARTMENT
 DISTRICT _____
 DATE _____

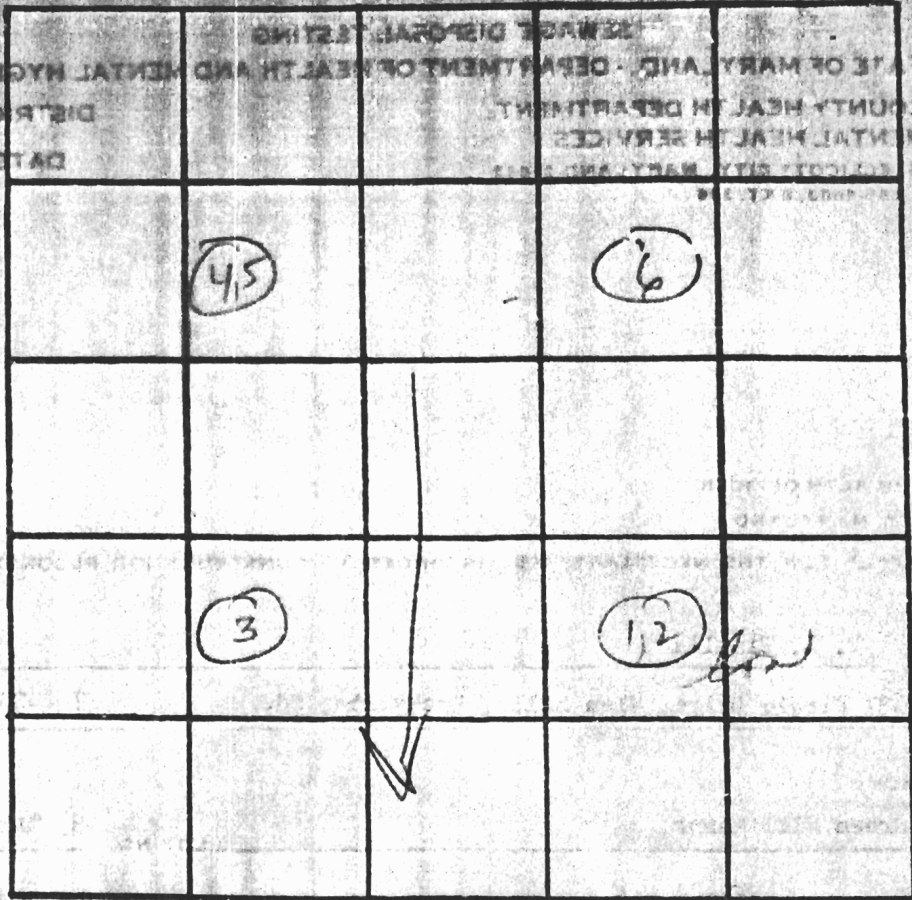

INDICATE NORTH - NAME ADJOINING ROADWAY AS BASE LINE

Cortina Drive

Inlet at
3 feet

Use test
4, 5
as first
system

use # 6
as first
repair,
3 as second
repair

DATE	TEST NO.	DEPTH	PRE-WET		TEST - 1" DROP		TIME	
			START	STOP	START	STOP		
11/7/73	1	4'	11:44	11:48	11:48	11:54	6	
	2	12'	11:44	12:11	12:11	12:41	30	
	3	11'	Visual. seen to 1/2 way					
	4	3'	11:48	12:00	12:00	12:20	20	
	5	11'	11:49	11:53	11:53	12:00	7	
	6	11'	Visual. seen to 1/4 way					
	3	10'	5 gals dumped 10 minutes					

Ave
20'
20'
15'
15'

REMARKS: WNZ & RM
 TYPE OF SOIL: clay - sand

PERMIT

SEWAGE DISPOSAL SYSTEM

MARYLAND STATE DEPARTMENT OF HEALTH

HOWARD COUNTY

ELICOTT CITY

DISTRICT 250

DATE 6/22/78

IS REQUIRED TO INSTALL

PHONE 752-2777

LOTTING DISTRICT

N

INDICATE NORTH. - NAME ADJOINING ROADWAY AS BASE LINE.

Cortina Drive ST DW

PERMIT CARD

SEPTIC TANK, LEVEL

CLEANOUTS

Terra Cotta

DISTRIBUTION BOX, LEVEL

TILE FIELD, DEPTH 10 FT

TRENCH WIDTH 2 FT

TOTAL LENGTH 50 FT

GRAVEL DEPTH 7 FT

TOTAL NUMBER OF TRENCHES 1

TOTAL AREA 350

SEWERAGE PYS, INSIDE DIAMETER DW 51

DEPTH BELOW INLET 7

TOTAL ABSORBENT AREA 50 SQ. FT.

REMARKS

Okay to add gravel to trench - call before backfilling do not backfill septic tank or dunnell, cleanouts covered - GLK

6/9/78 Final inspection - okay to backfill system (GLK)


DATE SYSTEM APPROVED 6/9/78

INSPECTOR

George J. K... ..

60
x3
504

24

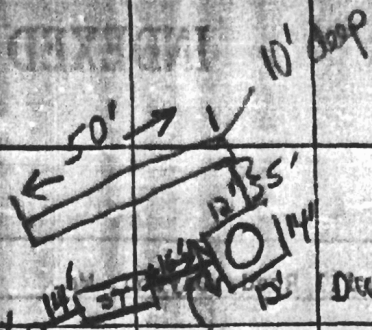

40.787 sq ft.
Lot 3 BKD Sub B
Browns Hill Manor
6708 Cortina Drive
Highland, MD 20777

Shower 400
Toilet 400
Elev. Elev. 400
Drywall 400
Elev. Elev. 400
Elev. Elev. 400
para. 400

