

SEWAGE DISPOSAL TESTING

MARYLAND STATE DEPARTMENT OF HEALTH

HOWARD COUNTY 1500

ELICOTT CITY

DISTRICT 4

Septic Tank - ~~existing~~

Dry Well - use dry wells - dry well pit 18" square 5' deep DATE 7/12/70

Handwritten note: 15' deep

Block - type for 10 ft diameter full in wet of pit with ground. Each dry well to be 6 ft high below water table. Each dry well to be 4 ft below water table. Max depth for dry wells is 10 ft below water table.

Place each Dry Well about 100 ft from right side line into one dry well except from side of storm drainage - second Dry Well about 105 ft from same

TO: THE COUNTY HEALTH OFFICER
ELICOTT CITY, MARYLAND

I, HEREBY, APPLY FOR THE NECESSARY TESTS IN ORDER TO CONSTRUCT OR RECONSTRUCT A SEWAGE DISPOSAL SYSTEM.

Handwritten note: existing in driveway to storm - dry wells to be 4 ft apart edge to edge + connected in series - no dist. between

PROPERTY OWNER Earl Burroughs, Jr

ADDRESS 17000 Langcraft Road, Gaithersburg, Maryland PHONE WA-60121

PROPERTY LOCATION:

SUBDIVISION _____ LOT NO. C

ROAD AND DESCRIPTION Mullins Mill Rd. beginning at the SW corner of former Tom Barnard property on Mullins Mill Rd, 4th Election District, west 920' to Mullins Mill Rd and north 183 feet

OCCUPANT None PHONE _____

PERSON TO CONSTRUCT SYSTEM Hy and Lowe Excavators

ADDRESS Griffith Road, Loudonsville, Maryland PHONE 253-9163

SIZE OF LOT 12.565 acres TYPE BLDG 5 bedroom home

IF NOT SINGLE RESIDENCE DESCRIBE _____

SIGNATURE OF APPLICANT _____

APPROVED BY D.W. Monaghan FOR Dry Wells (2) DATE 7/9/70


REJECTED BY _____ FOR _____ DATE _____

HOLD PENDING FURTHER TESTS _____ DATE _____

REASONS FOR REJECTION OR HOLDING Block & Nancy Green 15915 Greenway for the Greenway, Inc. 598-7701

THIS IS NOT A DEPOSIT

APPLICATION

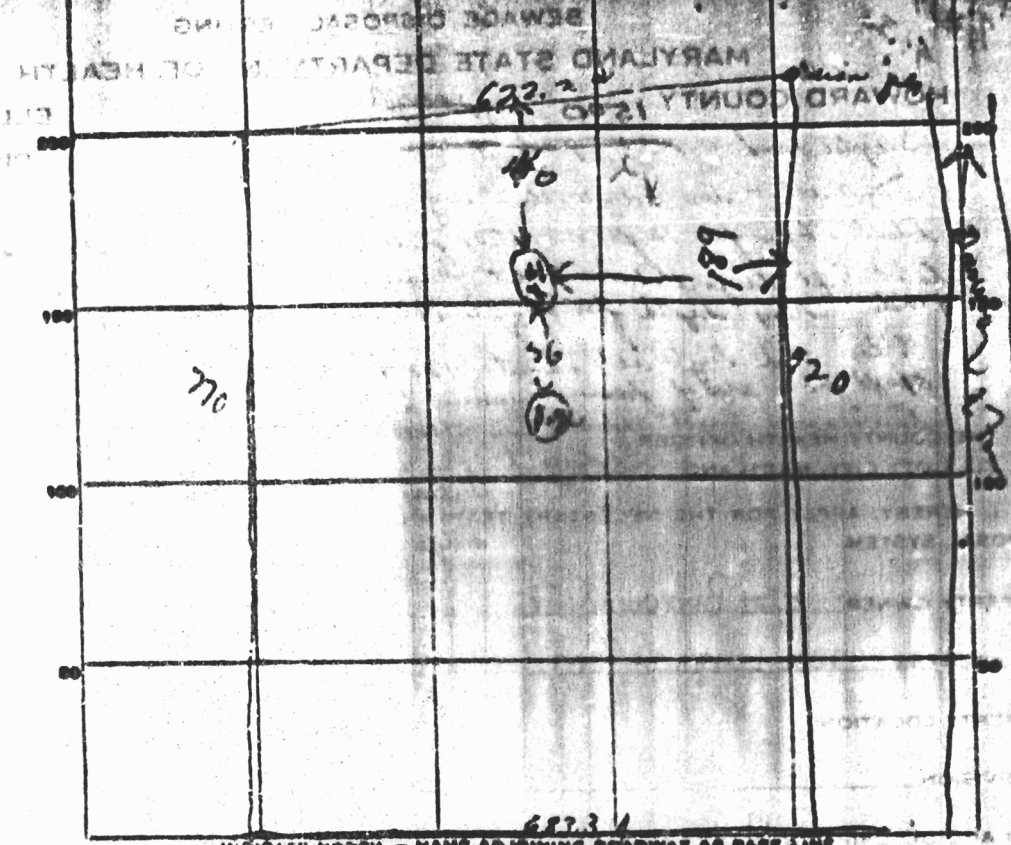

INDICATE NORTH - NAME ADJOINING ROADWAY AS BASE LINE

Muller's Mill Rd

DATE	TEST NO.	DEPTH	PRE-WET		TEST - 1" DROP		TIME
			START	STOP	START	STOP	
7/9/70	1	3 1/2 ft	10 04	10 09	10 09	10 16	7 min
	2	9 ft	10 05	10 10	10 10	10 20	10 min
	3	10 ft	10 09	10 26	10 26	10 49	23 min
	4	4 ft	10 06	10 08	10 09	10 12	4 min

SOIL AUGER FINDING *red - 5 ft*

TESTED BY *Smith*

REMARKS

