

5/23/02
1:00

APPLICATION

1 lot

PERCOLATION TESTING

A 516881

P _____

HOWARD COUNTY HEALTH DEPARTMENT
BUREAU OF ENVIRONMENTAL HEALTH
3525-H ELLICOTT MILLS DRIVE/ELLICOTT CITY, MARYLAND 21043
TELEPHONE: 313-2640

DISTRICT _____

DATE 3/25/2002

TO: THE COUNTY HEALTH OFFICER
ELLICOTT CITY, MARYLAND

I HEREBY APPLY FOR THE NECESSARY TEST PRIOR TO APPLICATION FOR PERMIT TO CONSTRUCT (OR RECONSTRUCT) A SEWAGE DISPOSAL SYSTEM.

PROPERTY OWNER Cody Kittleman

ADDRESS 4910 David Greene Rd Cambridge 21613 PHONE 410-221-0237 (410-463-3585)

AGENT OR PROSPECTIVE BUYER NONE

ADDRESS _____ PHONE _____

PROPERTY LOCATION:

SUBDIVISION _____ LOT NO. _____

ROAD AND DESCRIPTION Rt 32 (Fox Valley)

TAX MAP 15 PARCEL # 117

SIZE OF LOT 1 Acre TYPE BLDG. Singl Family
(SINGLE FAMILY DWELLING OR COMMERCIAL)

THE SYSTEM INSTALLED UNDER THIS APPLICATION IS ACCEPTABLE ONLY UNTIL PUBLIC FACILITIES BECOME AVAILABLE. I FULLY UNDERSTAND THE FEE CONNECTED WITH THE FILING OF THIS PERC TEST APPLICATION IS NON-REFUNDABLE UNDER ANY CIRCUMSTANCES. I ALSO AGREE TO COMPLY WITH ALL M.O.S.H.A. REQUIREMENTS IN TESTING THIS LOT. Cody K
(SIGNATURE OF APPLICANT)

APPROVED BY _____ FOR _____ DATE _____

DISAPPROVED BY _____ FOR _____ DATE _____

HOLD PENDING FURTHER TESTS _____

REASONS FOR REJECTION OR HOLDING _____

PERCOLATION TEST PLAT/PRELIMINARY PLAT - TITLE OR I.D. # _____ DATE _____

SITE DEVELOPMENT PLAN/FINAL PLAT - TITLE OR I.D. # _____ DATE _____

THIS IS NOT A PERMIT

516881

COUNTY #

SOIL PROFILE

0' (A)

brn Loam
Rock 15-20%
HARD B 9'


(B)

hvy Lm - CLm 4'
micaceous Sand + Lm Sand 6'

lt brn brn fine Sand
Rx 5-10%
Bottom 14'

(C)

brn CLLM 2 1/2'
si Lm 9'
H org h m
Rx Fine Loamy Sand
Bottom 14'

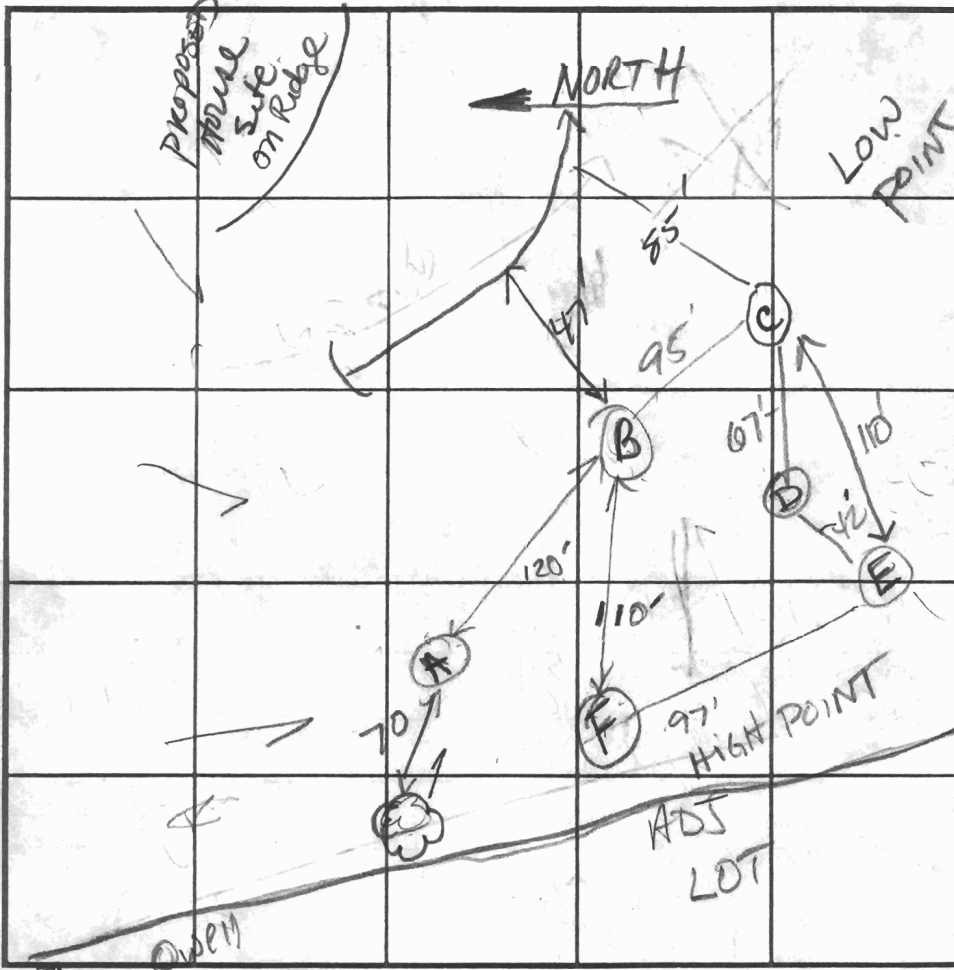

SOIL PROFILE

0' (F)

Rx < 5%
y brn. brn org Lm
H verge H brn
Fine SAND
Rx 10-15%
Bottom 12'

(E)

org brn Loam 4'
white grey Sand
w fr. saporite ~ 15%
Bottom 12'

DATE	TEST NO.	DEPTH	PRE-WET		TEST - 1" DROP		TIME
			START	STOP	START	STOP	
5/23/02	A	5 1/2' / 9'	3:05:53	3:13	3:13	3:20	7 min ok
	B	6'2" / 14'	3:11	3:14		3:18	4 min ok
		3 1/2'	3:20				
	C	6' / 14'	3:29	3:36	3:36	3:43	9 min ok
	D	Visual	See	Soil Profile			
	E	6' / 12'	3:44:25	3:45	3:45	3:47	2 min repair
			3:52:15	3:53:51		3:56:13	2+ min ok
		4'	3:52	3:53	3:53	3:54:30	1 1/2+ min
	(F)	3 1/2' / 6'	3:58:30	4:00:30	4:00:30	4:02:45	2+ min
		6' / 12'	4:02:16	4:03:30	4:03:30	4:05:30	2 min ok

REMARKS

TYPE OF SOIL Loam & Loamy SAND & SAND


TESTED BY Kacie ALSO PRESENT Cody Kittleman

TRENCH DESIGN DATA: AVERAGE PERCOLATION TIME _____ TRENCH WIDTH 3

INLET DEPTH 3 1/2' MAXIMUM BOTTOM DEPTH 7 1/2' SQ. FT./BEDROOM 180

3/24/03
 propane tank location OK
 (KN)

N 591800
 E 1318800

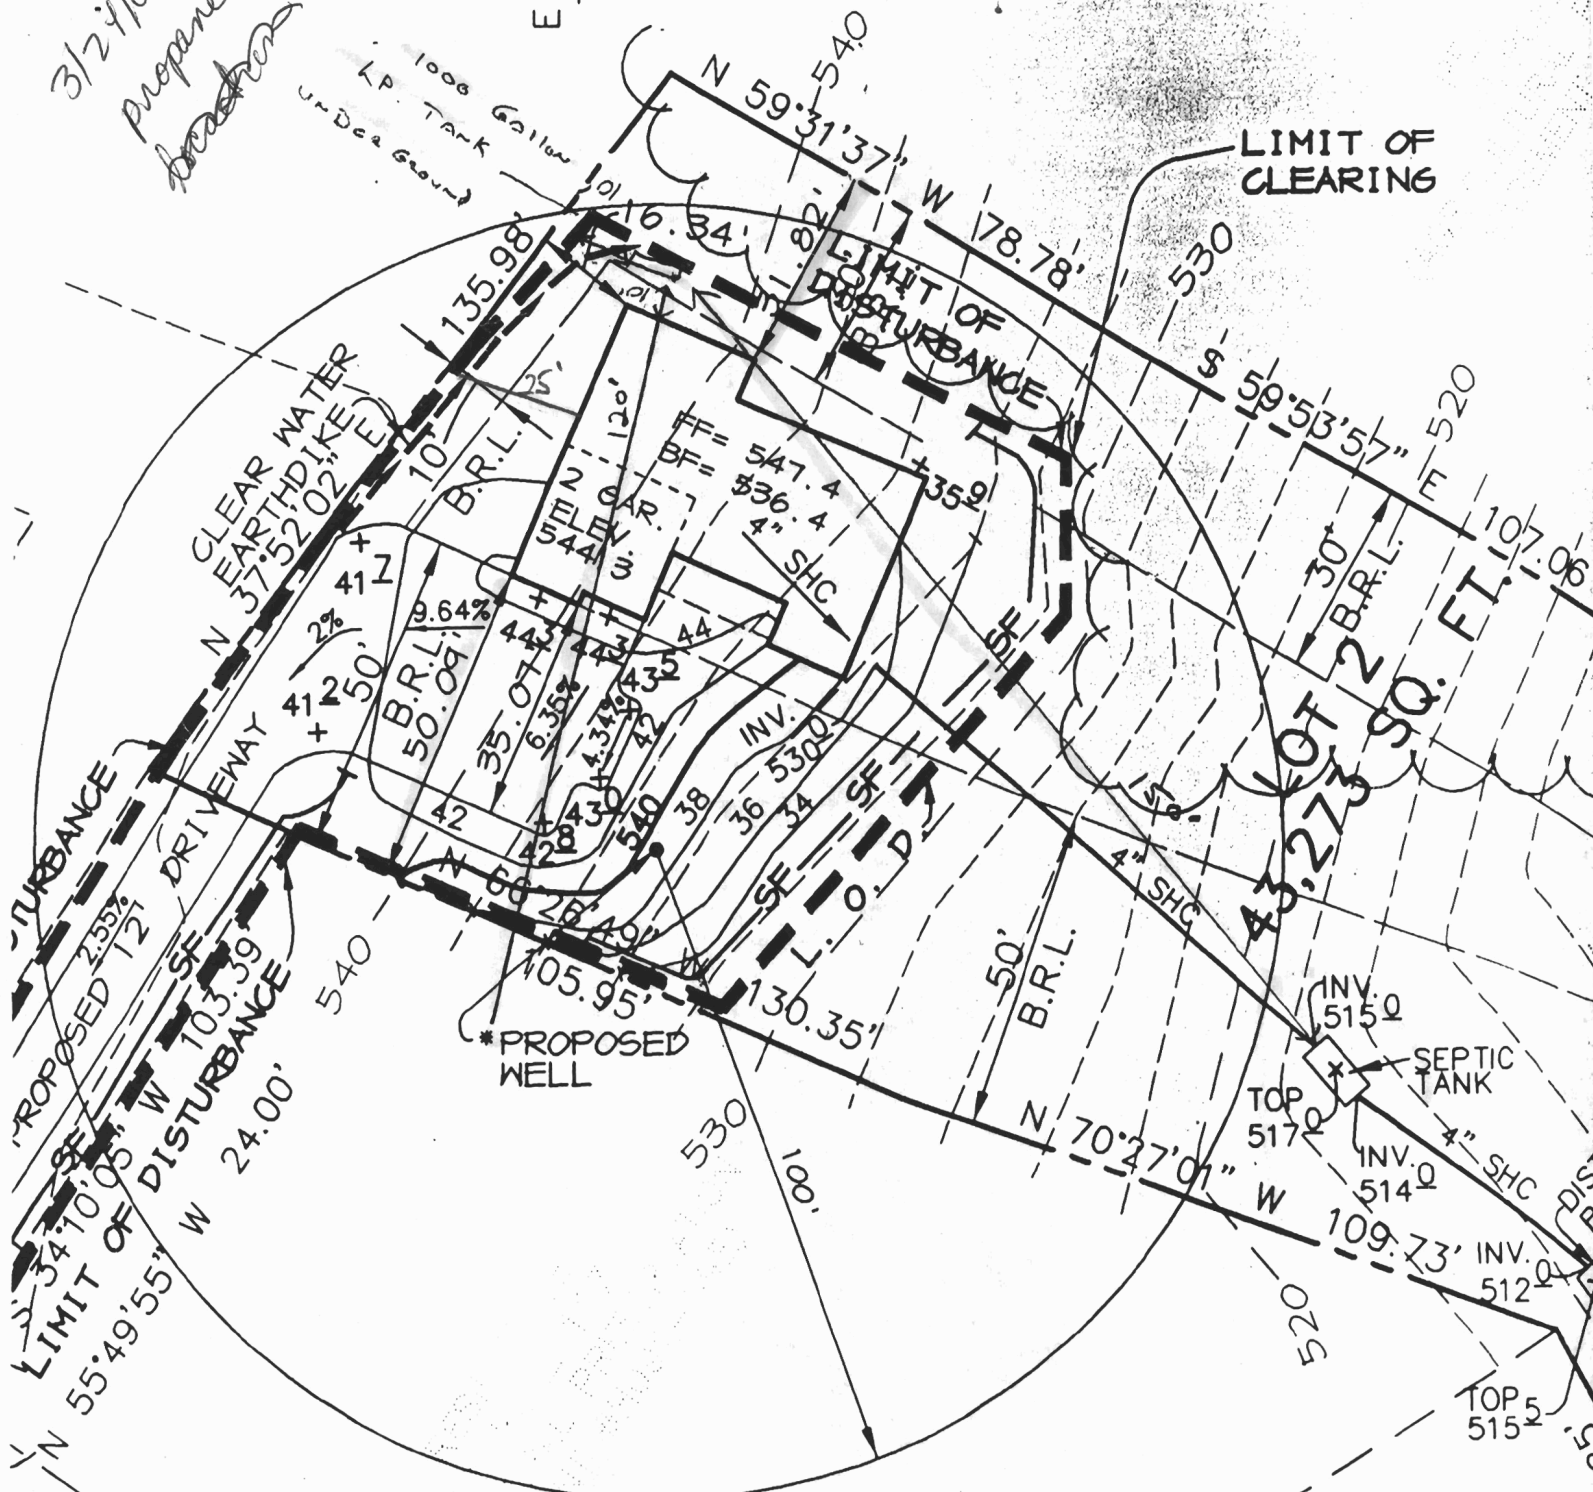





*PROVIDE BARRIER AROUND WELL
 PRIOR TO GRADING, EXTEND
 WELL CASING 5' ABOVE GRADE.

Scale
 1" = 30'

Install (1) 1000 Gallon
 Asma UnderGround LP Tank
 PER NFPA 58

COUNTY #

SOIL-PROFILE

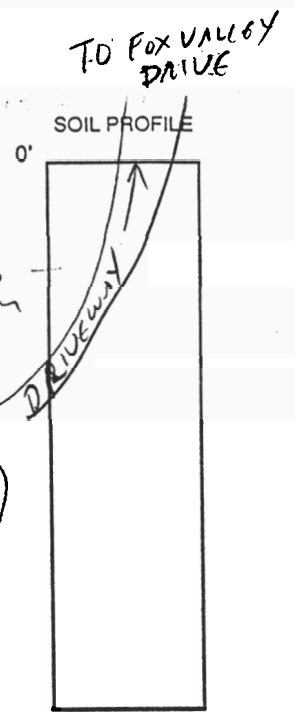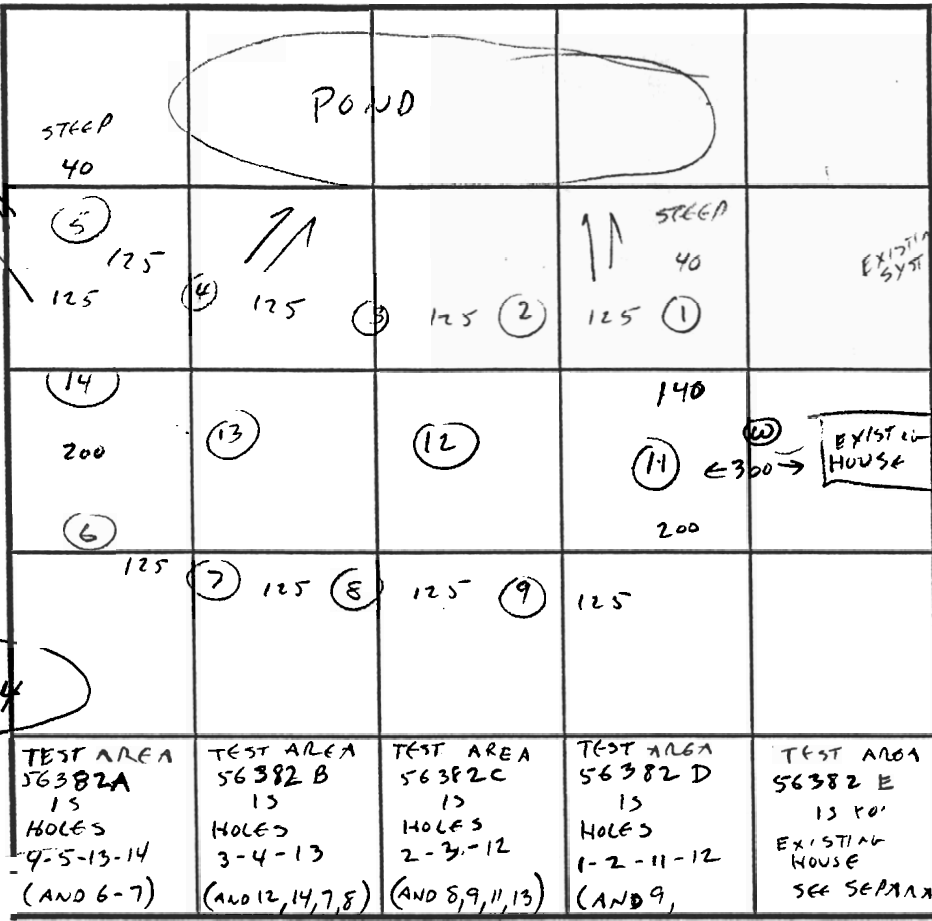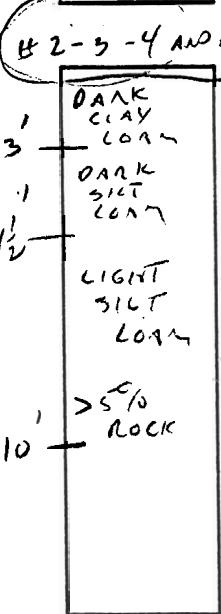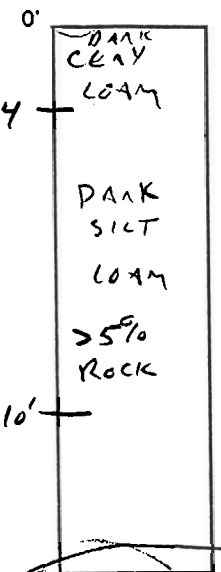

INDICATE NORTH - NAME ADJOINING ROADWAY AS BASE LINE.

DATE	TEST NO.	DEPTH	PRE-WET		TEST - 1" DROP		TIME
			START	STOP	START	STOP	
12/27/95	1	4 1/2	12:33:30	12:41	12:41	12:56	15 MIN
		VIS OK 4-10' DARK SILT LOAM					
	2, 4	SAME AS #3 - VIS OK 3-10' LIGHT SILT LOAM					
	3	4	12:22	12:25	12:25	12:31	6 MIN
		VIS OK 4 1/2-10' LIGHT SILT LOAM					
	5	3 1/2	12:10	12:13:30	12:13:30	12:18:30	5 MIN
		VIS OK 3-10' GRAY SANDY MICA LOAM					
	11-14	VIS OK 4 1/2-7 1/2' SIMILAR TO #3					
	6-10	VIS OK SIMILAR TO #3					
		NOT USED - HIGH ON LOT - POTENTIAL WELL AREA					


REMARKS UNABLE TO MEAS DISTANCE TO POND - STEEP & ICY
 TYPE OF SOIL WATCH TOPOGRAPHY ALONG LOWER LIMITS - NBAN SIGNALS AND STEEP SLOPES
 TESTED BY CW [Signature] ALSO PRESENT KITTCOMAN
 TRENCH DESIGN DATA: AVERAGE PERCOLATION TIME 8 TRENCH WIDTH 3
 INLET DEPTH 3 MAXIMUM BOTTOM DEPTH 5 SQ. FT./BEDROOM 240

SOILS

- Ba BAILE SILT LOAM
- CgB2 CHESTER GRAVELLY SILT LOAM, 3 TO 8 PERCENT SLOPES, MODERATELY ERODED
- G1B2 GLENEL6 LOAM, 3 TO 8 PERCENT SLOPES, MODERATELY ERODED
- GnB2 GLENVILLE SILT LOAM, 3 TO 8 PERCENT SLOPES, MODERATELY ERODED
- MgC3 MANOR GRAVELLY LOAM, 8 TO 15 PERCENT SLOPES, SEVERELY ERODED
- M1D3 MANOR LOAM, 15 TO 25 PERCENT SLOPES, SEVERELY ERODED
- MnD MANOR VERY STONY LOAM, 3 TO 25 PERCENT SLOPES
- MnF MANOR VERY STONY LOAM, 25 TO 60 PERCENT SLOPES

LEGEND

- EXISTING PERC TEST
- PERC TEST PASSED
- ⊙ PERC TEST FAILED
- PROPOSED WELL
- EXISTING TREELINE
- NONTIDAL WETLANDS & 25' BUFFER
- EXISTING FENCELINE
- ▭ PROPOSED SEPTIC FIELD
- BUILDING RESTRICTION LINE
- ▨ 25% SLOPE OR GREATER

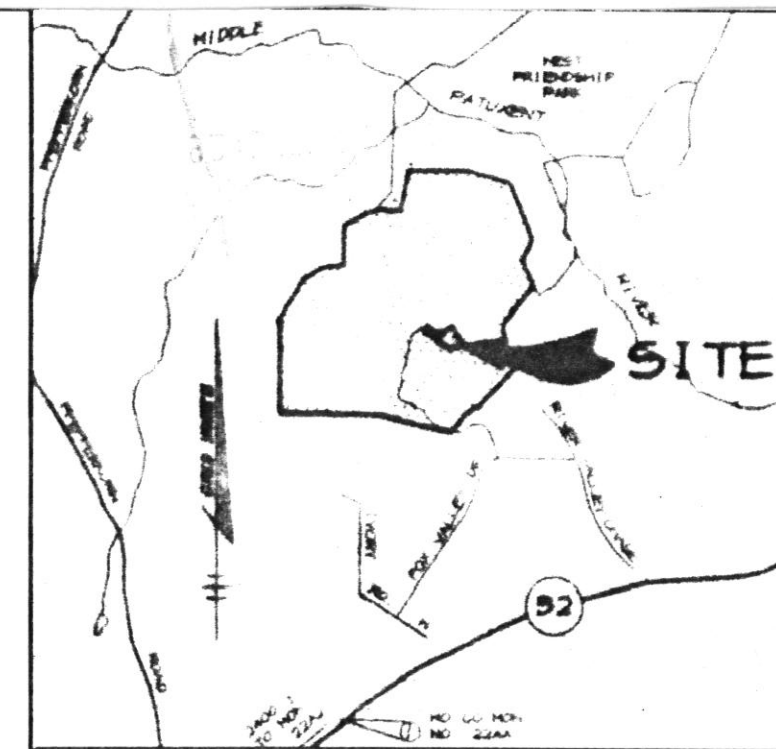

VICINITY MAP
SCALE: 1" = 2000'



OVERALL SITE MAP
1" = 400'

GENERAL NOTES

1. THIS AREA DESIGNATES A MINIMUM 10,000 SQ. FT. PRIVATE SEWAGE DISPOSAL EASEMENT AS REQUIRED BY THE MARYLAND DEPARTMENT OF THE ENVIRONMENT FOR INDIVIDUAL SEWAGE DISPOSAL. IMPROVEMENTS OF ANY NATURE IN THIS AREA ARE RESTRICTED UNTIL PUBLIC SEWER IS AVAILABLE. THESE EASEMENTS SHALL BECOME NULL AND VOID UPON CONNECTION TO A PUBLIC SEWER SYSTEM. THE COUNTY HEALTH OFFICER SHALL HAVE THE AUTHORITY TO GRANT VARIANCES FOR ENCROACHMENTS INTO THE PRIVATE SEWAGE EASEMENT. RECORDATION OF A MODIFIED SEWAGE EASEMENT PLAT SHALL NOT BE NECESSARY.
2. PERC HOLES SHOWN HEREON HAVE BEEN FIELD LOCATED BY PATTON HARRIS RUST AND ASSOCIATES, P.C. JUNE 2002.
3. SUBJECT PROPERTY IS ZONED 'RC'.
4. WELLS AND SEPTIC SYSTEMS WITHIN 100 FEET OF THE PROPERTY BOUNDARY HAVE BEEN SHOWN TO THE BEST OF OUR KNOWLEDGE AND INFORMATION.
5. THE LOTS SHOWN HEREON COMPLY WITH THE MINIMUM OWNERSHIP WIDTH AND LOT AREA AS REQUIRED BY THE MARYLAND DEPARTMENT OF THE ENVIRONMENT.
6. TOPOGRAPHY SHOWN HEREON HAS BEEN FIELD SURVEYED BY PATTON HARRIS RUST AND ASSOCIATES, P.C. DATE OF SURVEY, JUNE 1996.
7. NONTIDAL WETLAND FIELD DELINEATED BY PATTON HARRIS RUST AND ASSOCIATES, P.C.
8. TOPOGRAPHY, WETLANDS AND EXISTING SITE INFO. FIELD LOCATED IN PROPOSED AREA OF DEVELOPMENT ONLY.
9. ALL WELLS TO BE DRILLED PRIOR TO FINAL PLAT RECORDATION.

PERC CERTIFICATION

I CERTIFY THAT THE LOCATIONS SHOWN HEREON ARE BASED ON FIELD LOCATIONS DONE UNDER MY DIRECT SUPERVISION, AND ARE CORRECT, TO THE BEST OF MY PROFESSIONAL KNOWLEDGE AND BELIEF.

Thomas L. Frazier, Jr. 7/15/02
THOMAS L. FRAZIER, JR. DATE
PROFESSIONAL LAND SURVEYOR
MD REG NO. 21097

APPROVED: FOR PRIVATE WATER AND PRIVATE SEWERAGE SYSTEMS BY THE HOWARD COUNTY HEALTH DEPARTMENT

Howard County Health Officer 7/15/02
HOWARD COUNTY HEALTH OFFICER DATE


DATE	NO.	REVISION
OWNER / DEVELOPER		
MR. & MRS. ROBERT H. KITTLEMAN 3104 FOX VALLEY DRIVE WEST FRIENDSHIP, MARYLAND 21794		
PROJECT KITTLEMAN PROPERTY LOT 5		
AREA TAX MAP NO. 15 PARCEL 117 3RD ELECTION DISTRICT HOWARD COUNTY, MARYLAND		
TITLE PERCOLATION CERTIFICATION PLAN		

Patton Harris Rust & Associates, pc
Engineers, Surveyors, Planners, Landscape Architects.

P.H.R.+A	8818 Centre Park Drive Columbia, MD 21045 T 410.997.8900 F 410.997.9282
	DESIGNED BY: KS
	DRAWN BY: KS
	PROJECT NO: 11469
	DATE: JULY 3, 2002
	SCALE: 1" = 50'
	DRAWING NO. 1 OF 1

POINT	NORTH	EAST
4	591567.8705	1318953.9896
7	591656.6766	1318731.0954
8	591764.0229	1318814.5634
9	591724.0734	1318882.4571
10	591670.3827	1318975.0758
11	591597.5639	1319098.0292
12	591522.0429	1319108.4239
13	591485.5916	1319001.9814
14	591604.5892	1318850.5850

EX. 24' PRIVATE USE-IN-COMMON ACCESS EASEMENT FOR THE PROPERTY OF ROBERT H. KITTLEMAN, LOT 1 AND FUTURE LOTS 2, 3 AND 4 HAS BEEN RECORDED IN THE LAND RECORDS OF HOWARD COUNTY L. 4475, F. 496, WHICH ULTIMATELY CONNECTS TO FOX VALLEY DRIVE THROUGH TWO (2) PRIVATE ACCESS EASEMENTS. SEE GENERAL NOTE 20 AND 800 FOOT PLAN BELOW.

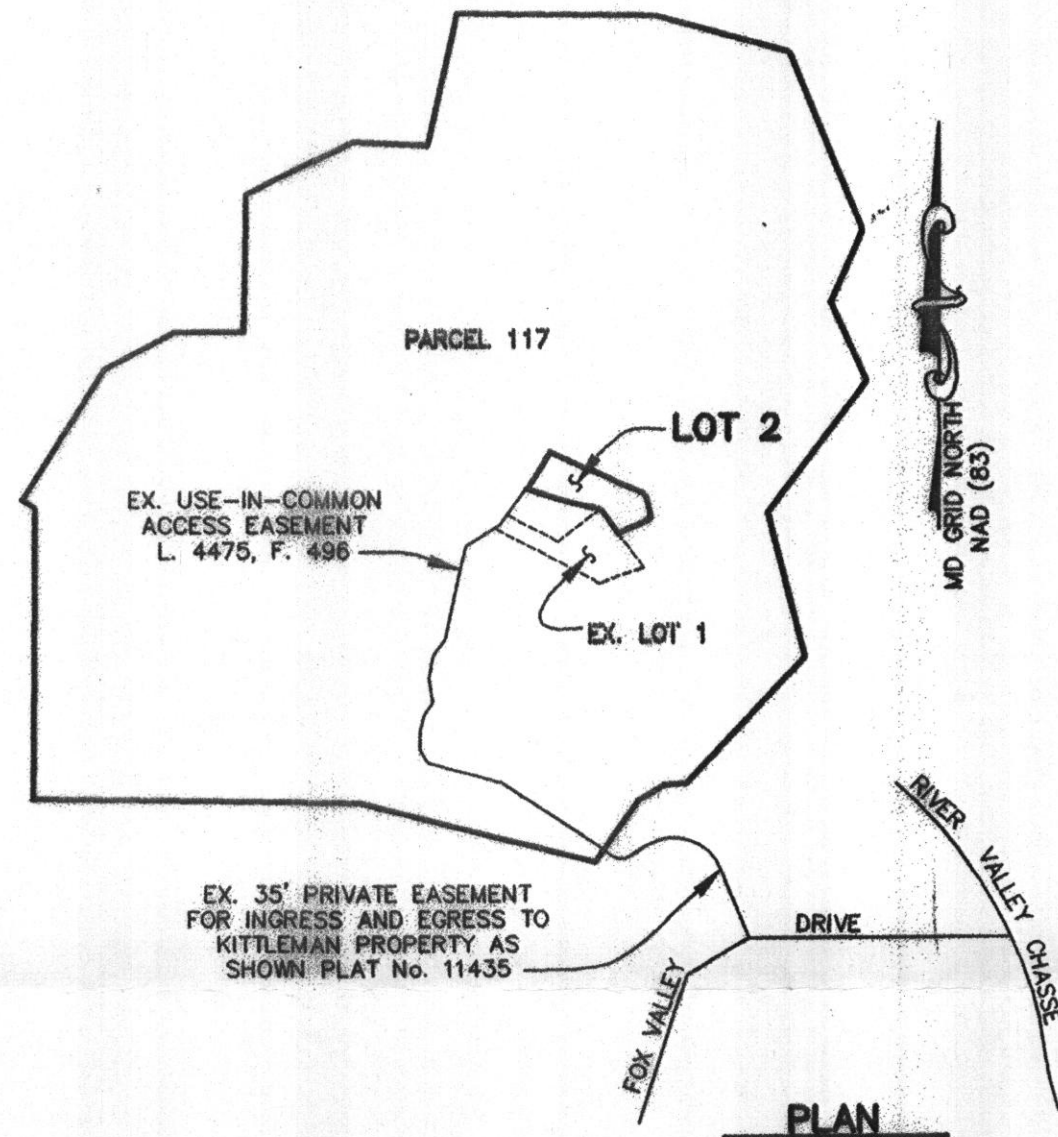


TOTAL TABULATION THIS SUBMISSION	TOTALS
TOTAL NUMBER OF LOTS TO BE RECORDED:	
BUILDABLE LOTS	1
NON-BUILDABLE LOTS	0
OPEN SPACE	0
PRESERVATION PARCELS	0
TOTAL AREA OF LOTS TO BE RECORDED:	
BUILDABLE LOTS	0.99341 AC. ±
NON-BUILDABLE LOTS	0
OPEN SPACE	0
PRESERVATION PARCELS	0
TOTAL AREA OF ROAD RIGHT-OF-WAY TO BE RECORDED INCLUDING WIDENING STRIPS:	0 AC. ±
TOTAL GROSS AREA OF SUBDIVISION TO BE RECORDED	0.99341 AC. ±

Patton Harris Rust & Associates, pc
 Engineers. Surveyors. Planners. Landscape Architects.

PHRA

8818 Centre Park Drive
 Columbia, MD 21045
 T 410.997.8900
 F 410.997.9282

- LEGEND**
- DENOTES PROPERTY LINE
 - - - DENOTES ADJOINER LINE
 - B.R.L. DENOTES BUILDING RESTRICTION LINE
 - DENOTES THE LOCATION OF THE PERC HOLES AS LOCATED BY PATTON HARRIS RUST & ASSOCIATES, PC
 - REBAR AND CAP FOUND

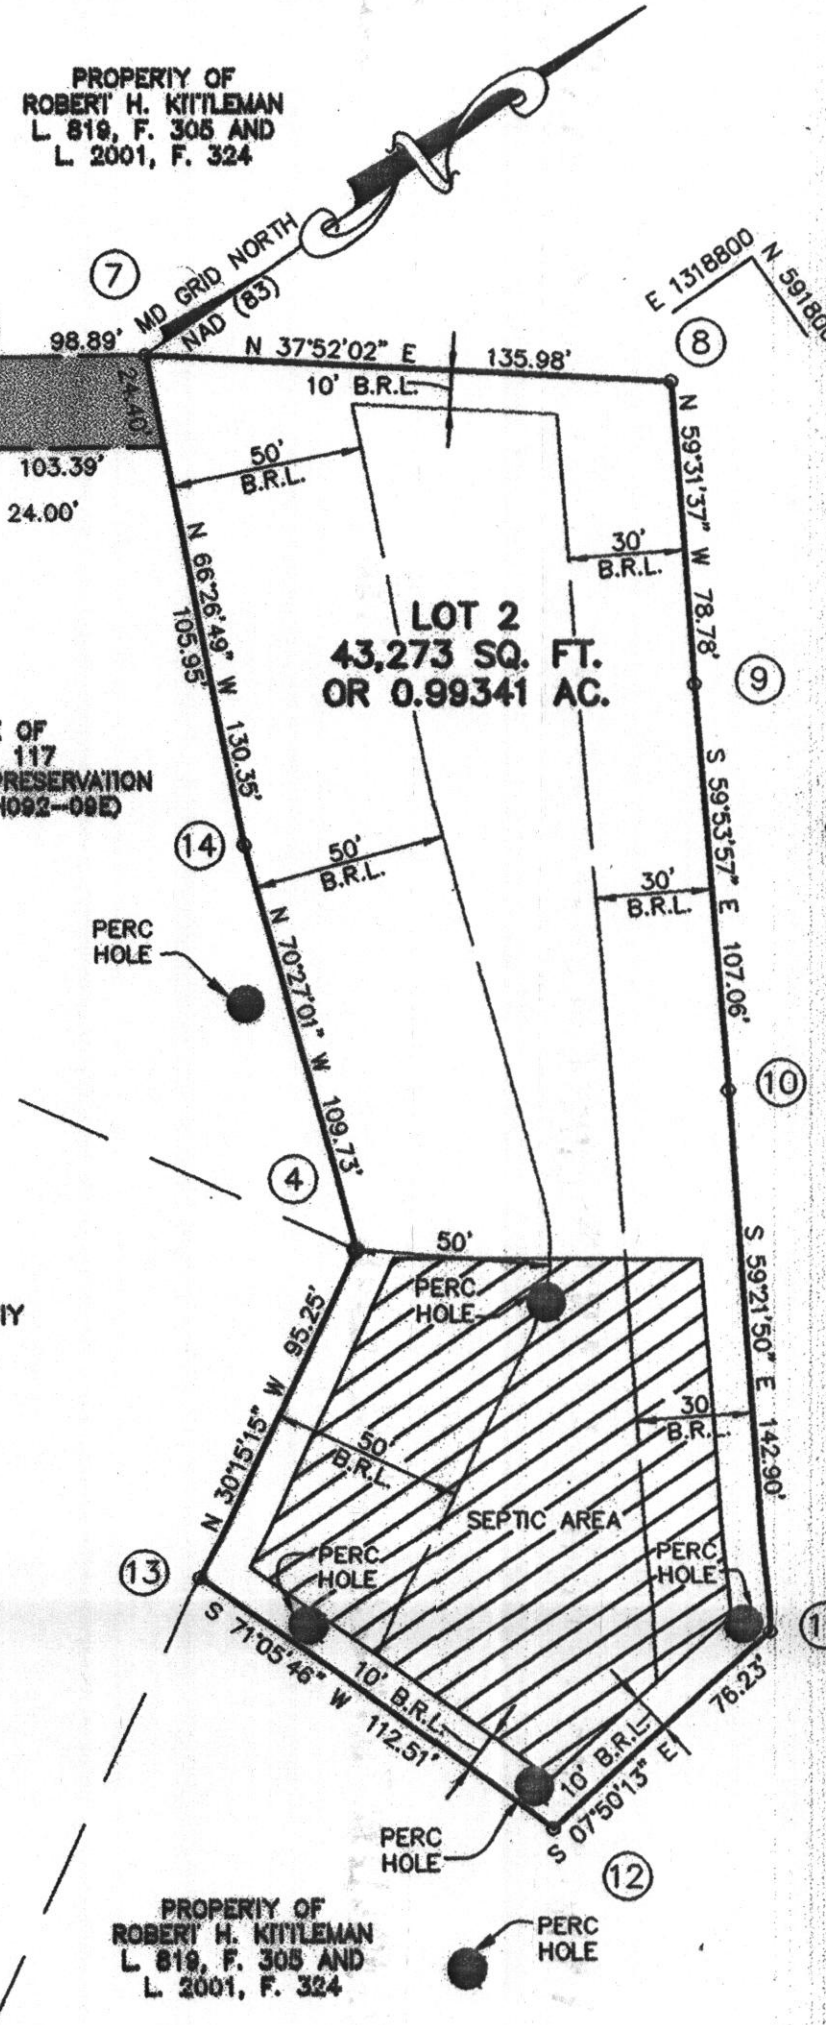


OWNER

ROBERT H. KITTLEMAN
 3104 FOX VALLEY DRIVE
 WEST FRIENDSHIP, MARYLAND 21794
 (410) 841- 3671

I FURTHER CERTIFY THAT THE REQUIREMENTS OF SECTION 3-108 THE REAL PROPERTY ARTICLE, ANNOTATED CODE OF MARYLAND, 1988 REPLACEMENT VOLUME, (AS SUPPLEMENTED) AS FAR AS THEY RELATE TO THE MAKING OF THIS PLAT AND THE SETTING OF MARKERS HAVE BEEN COMPLIED WITH.

R.H. Kittleman 12/11/02
 ROBERT H. KITTLEMAN DATE

Thomas L. Frazier, Jr. 12/12/02
 THOMAS L. FRAZIER, JR. NO. 21097 DATE

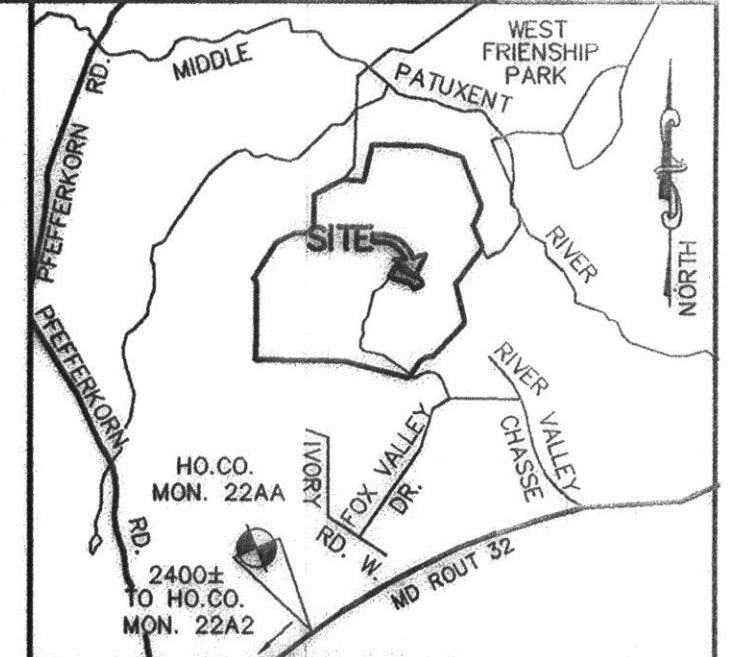

VICINITY MAP
 SCALE: 1" = 2000'

GENERAL NOTES

- COORDINATES BASED ON NAD 83, MARYLAND COORDINATE SYSTEM AS PROJECTED BY HOWARD GEODETIC CONTROL STATIONS Nos. 22AA AND 22A2.
- ALL AREAS SHOWN ON THIS PLAT ARE MORE OR LEES.
- THIS PLAT IS BASED ON A FIELD RUN MONUMENTED BOUNDARY SURVEY PERFORMED ON OR ABOUT JULY 1, 1996 BY RIEMER MUEGGE AND ASSOCIATES, INC. NOW PATTON HARRIS RUST AND ASSOCIATES, P.C.
- THE SUBJECT PROPERTY IS ZONED RC-DEO AS PER THE 10-18-93 COMPREHENSIVE ZONING PLAN.
- THERE ARE NO VISIBLE SIGNS OF CEMETERIES WITHIN THE SUBJECT PROPERTY.
- THIS PROJECT IS EXEMPT FROM STORMWATER MANAGEMENT UNDER THE HOWARD COUNTY DESIGN MANUAL, VOL. 1, PARAGRAPH 5.1.2.B.4. THIS EXEMPTION IS BASED ON AVERAGE LOT SIZE OF 3.8 ACRES AND NO PROPOSED PUBLIC ROADS.
- THIS SUBDIVISION IS EXEMPT FROM THE REQUIREMENTS OF THE FOREST CONSERVATION PROGRAM PER SECTION 16.1202(b) (1) (vi) OF THE SUBDIVISION AND LAND DEVELOPMENT REGULATIONS BECAUSE THE PROPERTY IS IN THE AGRICULTURAL PRESERVATION PROGRAM.
- NO WETLANDS WERE PRESENT ON SITE AS FIELD VERIFIED BY RIEMER MUEGGE AND ASSOCIATES, INC. OCTOBER 1998. NOW PATTON HARRIS RUST AND ASSOCIATES, P.C.
- THERE ARE NO FLOODPLAIN LIMITS WITHIN THE LIMITS OF THE SUBJECT PROPERTY.
- THERE ARE NO EXISTING STRUCTURES LOCATED ON LOT 2.
- THE DRIVEWAY SHALL BE PROVIDED PRIOR TO ISSUANCE OF A USE AND OCCUPANCY PERMIT FOR ANY NEW DWELLING TO INSURE SAFE ACCESS FOR FIRE AND EMERGENCY VEHICLES PER THE FOLLOWING MINIMUM REQUIREMENTS:
 - WIDTH - 12 FEET (14 FEET IF SERVING MORE THAN ONE RESIDENCE).
 - SURFACE - 6 INCHES OF COMPACTED "CRUSHER RUN" BASE WITH "TAR AND CHIP" COATING. (GRAVEL IS ACCEPTABLE IF SERVING ONLY ONE HOUSE).
 - GEOMETRY - MAXIMUM 15% GRADE. MAXIMUM 10% GRADE CHANGE AND MINIMUM OF 30 FOOT TURNING RADIUS.
 - STRUCTURES - (CULVERTS AND BRIDGES) CAPABLE OF SUPPORTING TWENTY-FIVE (25) GROSS TONS (H-25 LOADING).
 - DRAINAGE ELEMENTS - CAPABLE OF SAFELY PASSING 100 YEAR FLOOD WITH NO MORE THAN 1 FOOT DEPTH OVER DRIVEWAY SURFACE.
 - STRUCTURE CLEARANCE - MINIMUM 12 FEET.
 - MAINTENANCE - SUFFICIENT TO INSURE ALL WEATHER USE.
 - HOUSE NUMBERING - WHERE ONE (1) DRIVEWAY SERVES MORE THAN ONE (1) LOT (COMMON DRIVEWAYS), A HOUSE NUMBERING SIGN MUST BE PLACED AT EACH LOT ENTRANCE AND A RANGE OF STREET ADDRESS HOUSE NUMBERS SIGN WHERE THE COMMON DRIVEWAY INTERSECTS WITH THE MAIN ROAD.
 - FOR FLAG OR PIPESTEM LOTS, REFUSE COLLECTION, SNOW REMOVAL AND ROAD MAINTENANCE ARE PROVIDED TO THE JUNCTION OF THE FLAG OR PIPESTEM AND ROAD RIGHT-OF-WAY LINE AND NOT TO THE PIPESTEM LOT DRIVEWAY.
 - THIS AREA DESIGNATES A PRIVATE SEWAGE EASEMENT OF AT LEAST 10,000 SQUARE FEET (OR 10,000 SQUARE FEET PER LOT FOR SHARED DRAIN FIELDS ASSOCIATED WITH A SHARED SEWAGE DISPOSAL FACILITY) AS REQUIRED BY THE MARYLAND STATE DEPARTMENT OF THE ENVIRONMENT FOR INDIVIDUAL SEWAGE DISPOSAL (COMAR 26.04.03) IMPROVEMENTS OF ANY NATURE IN THIS AREA ARE RESTRICTED UNTIL PUBLIC SEWAGE SYSTEM. THE COUNTY HEALTH OFFICER SHALL HAVE THE AUTHORITY TO GRANT VARIANCES FOR ENCROACHMENTS INTO THE PRIVATE SEWAGE EASEMENT. RECORDATION OF A MODIFIED SEWAGE EASEMENT SHALL NOT BE NECESSARY.

- LOT 2 SHOWN ON THIS PLAT SHALL COMPLY WITH THE MINIMUM OWNERSHIP WIDTH AND LOT AREAS AS REQUIRED BY THE MARYLAND STATE DEPARTMENT OF THE ENVIRONMENT.
- LANDSCAPING REQUIREMENTS FOR THIS LOT ARE IN ACCORDANCE WITH THE ALTERNATIVE COMPLIANCE PROVISIONS OF SECTION 16.124 OF THE HOWARD COUNTY CODE AND THE LANDSCAPE MANUAL AS A RESULT OF THE LOT'S SITE LOCATION WITHIN THE FARM'S INTERIOR.
- A DECLARATION OF MAINTENANCE OBLIGATION AGREEMENT FOR A PRIVATE USE-IN-COMMON DRIVEWAY HAS BEEN RECORDED IN THE LAND RECORDS OF HOWARD COUNTY, MARYLAND.
- THIS PROPERTY IS SUBJECT TO A DEED OF AGRICULTURAL LAND PRESERVATION EASEMENT RECORDED IN LIBER 2651 AT FOLIO 0482 AMONG THE LAND RECORDS OF HOWARD COUNTY.
- LOT 2 IS BEING CREATED IN ACCORDANCE WITH THE DEED OF AGRICULTURAL LAND PRESERVATION EASEMENT AND SECTION 15.509 OF THE PRE-1993 AGRICULTURAL LAND PRESERVATION ACT OF HOWARD COUNTY.
- PERC TEST HOLES SHOWN HEREON HAVE BEEN FIELD LOCATED BY PATTON HARRIS RUST AND ASSOCIATES, P.C.
- THE EXISTING 24 FEET PRIVATE USE-IN-COMMON ACCESS EASEMENT, WHICH IS RECORDED AMONG THE LAND RECORDS OF HOWARD COUNTY IN LIBER 4475 AT FOLIO 496 RUN THROUGH THE KITTLEMAN PROPERTY AND CONNECTS TO ANOTHER EXISTING 35 FEET PRIVATE EASEMENTS FOR INGRESS AND EGRESS THROUGH OPEN SPACE PARCEL 'A' OF AN EXISTING SUBDIVISION ENTITLED "WEST FRIENDSHIP ESTATES, SECTION 1, LOTS 1-56, PARCELS A, B, C & D" AND RECORDED AMONG THE LAND RECORDS OF HOWARD COUNTY, MARYLAND AS PLAT Nos. 11432-11443, WHICH ULTIMATELY CONNECTS TO FOX VALLEY DRIVE.

APPROVED: FOR PRIVATE WATER AND PRIVATE SEWERAGE SYSTEMS
 HOWARD COUNTY HEALTH DEPARTMENT

Paula Brantner 12-20-02
 HOWARD COUNTY HEALTH OFFICER DATE

APPROVED: HOWARD COUNTY DEPARTMENT OF PLANNING AND ZONING.

Frank Kora 12/22/02
 CHIEF, DEVELOPMENT ENGINEERING DIVISION DATE

Thomas L. Frazier, Jr. 1/10/03
 DIRECTOR DATE

SURVEYOR'S CERTIFICATE

I, HEREBY CERTIFY THAT THE FINAL PLAT SHOWN HEREON IS CORRECT; THAT IT IS PART THE LANDS CONVEYED BY ROBERT H. KITTLEMAN AND PATRICIA LEE KITTLEMAN TO ROBERT H. KITTLEMAN BY DEED DATED APRIL 20, 1977 AND RECORDED AMONG THE LAND RECORDS OF HOWARD COUNTY, MARYLAND IN LIBER 819 AT FOLIO 305 AND THAT ALL MONUMENTS ARE IN PLACE OR WILL BE IN PLACE PRIOR TO THE ACCEPTANCE OF THE STREETS IN THE SUBDIVISION BY HOWARD COUNTY AS SHOWN IN ACCORDANCE WITH THE ANNOTATED CODE OF MARYLAND, AS AMENDED.

Thomas L. Frazier, Jr. 12/12/02
 THOMAS L. FRAZIER, JR.
 PROFESSIONAL LAND SURVEYOR
 MD REGISTRATION NO. 21097

OWNER'S CERTIFICATE

I, ROBERT H. KITTLEMAN, OWNER OF THE PROPERTY SHOWN AND DESCRIBED HEREON, HEREBY ADOPT THIS PLAN OF SUBDIVISION; AND IN CONSIDERATION OF THE APPROVAL OF THIS PLAT BY THE DEPARTMENT OF PLANNING AND ZONING ESTABLISH THE MINIMUM RESTRICTION LINES. ALL EASEMENTS OF (OR) RIGHTS-OF-WAY AFFECTING THE PROPERTY ARE INCLUDED IN THIS PLAN OF SUBDIVISION.

WITNESS MY HAND, THIS DAY 11 OF DECEMBER 2002.

R.H. Kittleman 12/11/02
 ROBERT H. KITTLEMAN DATE

RECORDED AS PLAT No. 15769
 ON Jan. 14, 2003
 AMONG THE LAND RECORDS OF HOWARD COUNTY, MARYLAND.

KITTLEMAN PROPERTY
 LOT 2

F-99-24

3RD ELECTION DISTRICT HOWARD COUNTY, MARYLAND
 BLOCK NO. 14, 15, 20 & 21 TAX MAP NO. 15
 PARCEL 117 ZONED: RC-DEO
 SCALE: AS SHOWN DATE: 12-10-02 SHEET: 1 OF 1
 PROJECT/11469-1-0/SURVEY/WORK AREA/001PLAT.DWG

