

APPLICATION

PERCOLATION TESTING

A _____

P _____

HOWARD COUNTY HEALTH DEPARTMENT
BUREAU OF ENVIRONMENTAL HEALTH
3525-H ELLICOTT MILLS DRIVE/ELLICOTT CITY, MARYLAND 21043
TELEPHONE: 410-313-2640

DISTRICT _____

DATE _____

TO: THE COUNTY HEALTH OFFICER
ELLICOTT CITY, MARYLAND

I HEREBY APPLY FOR THE NECESSARY TEST PRIOR TO APPLICATION FOR PERMIT TO CONSTRUCT (OR RECONSTRUCT) A SEWAGE DISPOSAL SYSTEM.

PROPERTY OWNER Robert T. Matthews Revocable Trust
ADDRESS c/o Cloverfield/Pfefferkorn, LLC, 10705 Charter Drive, Suite 320, Columbia, MD 21044 PHONE 410-997-7400

AGENT OR PROSPECTIVE BUYER Heritage Land Development
ADDRESS 3060 Washington Rd., Suite 220, Glenwood, MD 21738 PHONE 410-489-7900

PROPERTY LOCATION:

SUBDIVISION Matthews Property LOT NO. _____

ROAD AND DESCRIPTION _____
2400 Pfefferkorn Road, West Friendship, MD 21794

TAX MAP NO. 15 PARCEL # 4

SIZE OF LOT 1 acre TYPE OF BLDG. SFD
(SINGLE FAMILY DWELLING OR COMMERCIAL)

THE SYSTEM INSTALLED UNDER THIS APPLICATION IS ACCEPTABLE ONLY UNTIL PUBLIC FACILITIES BECOME AVAILABLE. I FULLY UNDERSTAND THE FEE CONNECTED WITH THE FILING OF THIS PERC TEST APPLICATION IS NON-REFUNDABLE UNDER ANY CIRCUMSTANCES. I ALSO AGREE TO COMPLY WITH ALL M.O.S.H.A. REQUIREMENTS IN TESTING THIS LOT.

(SIGNATURE OF APPLICANT)

APPROVED BY _____ FOR _____ DATE _____

DISAPPROVED BY _____ FOR _____ DATE _____

HOLD PENDING FURTHER TESTS _____

REASONS FOR REJECTION OR HOLDING _____

PERCOLATION TEST PLAT/PRELIMINARY PLAT - TITLE OR I.D. # _____ DATE _____

SITE DEVELOPMENT PLAN/FINAL PLAT - TITLE OR I.D. # _____ DATE _____

THIS IS NOT A PERMIT

COUNTY #

SOIL PROFILE

0' 8054

red
brn
clm

1 1/2'

dark
orange
sil
20%
Rx

2 1/2'

30-40%
Rx

3'

8055

orange
brn
sil

4'

orange
brn
Salm
5%
rock


4'

SOIL PROFILE

0' 8056

like
8054
but

10 1/2' 40% Rx
11' refusal

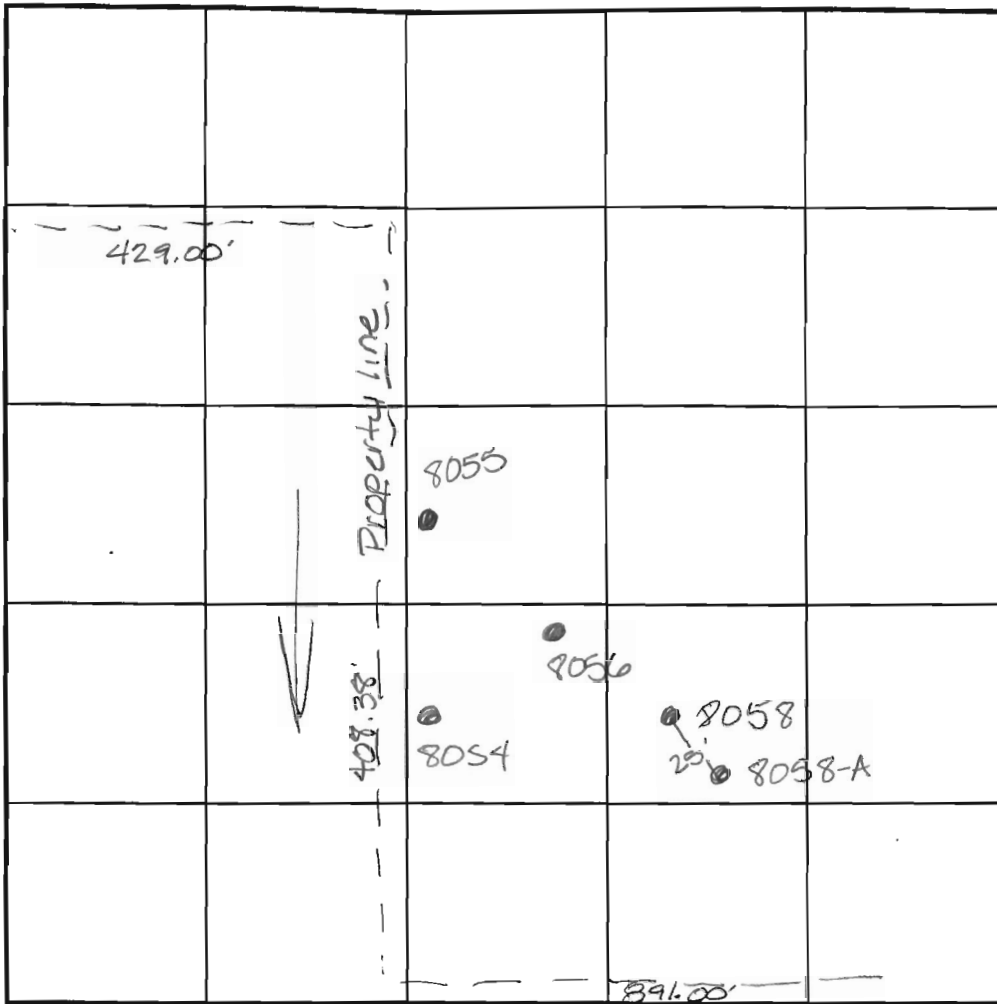

INDICATE NORTH - NAME ADJOINING ROADWAY AS BASE LINE.

DATE	TEST NO.	DEPTH	PRE-WET		TEST - 1" DROP		TIME	
			START	STOP	START	STOP		
5-10-03	8058 A	Refusal @ 3 1/2'	Insufficient depth to bedrock					F
	8058	Refusal @ 4'	Insufficient depth to bedrock					F
	8054	5 1/2'	5:23	5:30	5:30	5:38	8min	P
	8055	4 1/2'	5:34	No test in 30 min			slow	P
	8056	3'	5:40	5:45	5:45	5:54	9min	P
	8056	7'	5:40	5:42	5:42	5:45	3min	P
	8055	5 1/2'	5:50	6:00	6:00	6:22	22min	P

REMARKS

TYPE OF SOIL

TESTED BY

TRENCH DESIGN DATA: AVG. PERCOLATION TIME

INLET DEPTH

ALSO PRESENT

TRENCH WIDTH

SQ. FT./BEDROOM

MAXIMUM BOTTOM DEPTH

APPLICATION

PERCOLATION TESTING

A _____

P _____

HOWARD COUNTY HEALTH DEPARTMENT
BUREAU OF ENVIRONMENTAL HEALTH
3525-H ELLICOTT MILLS DRIVE/ELLICOTT CITY, MARYLAND 21043
TELEPHONE: 410-313-2640

DISTRICT _____
DATE _____

TO: THE COUNTY HEALTH OFFICER
ELLICOTT CITY, MARYLAND

I HEREBY APPLY FOR THE NECESSARY TEST PRIOR TO APPLICATION FOR PERMIT TO CONSTRUCT (OR RECONSTRUCT) A SEWAGE DISPOSAL SYSTEM.

PROPERTY OWNER Robert T. Matthews Revocable Trust
c/o Cloverfield/Pfefferkorn, LLC, 10705 Charter Drive,
ADDRESS Suite 320, Columbia, MD 21044 PHONE 410-997-7400

AGENT OR PROSPECTIVE BUYER Heritage Land Development
ADDRESS 3060 Washington Rd., Suite 220, Glenwood, MD 21738 PHONE 410-489-7900

PROPERTY LOCATION:

SUBDIVISION Matthews Property LOT NO. 11

ROAD AND DESCRIPTION _____
2400 Pfefferkorn Road, West Friendship, MD 21794

TAX MAP NO. 15 PARCEL # 4

SIZE OF LOT 1 acre TYPE OF BLDG. SFD
(SINGLE FAMILY DWELLING OR COMMERCIAL)

THE SYSTEM INSTALLED UNDER THIS APPLICATION IS ACCEPTABLE ONLY UNTIL PUBLIC FACILITIES BECOME AVAILABLE. I FULLY UNDERSTAND THE FEE CONNECTED WITH THE FILING OF THIS PERC TEST APPLICATION IS NON-REFUNDABLE UNDER ANY CIRCUMSTANCES. I ALSO AGREE TO COMPLY WITH ALL M.O.S.H.A. REQUIREMENTS IN TESTING THIS LOT.

(SIGNATURE OF APPLICANT)

APPROVED BY _____ FOR _____ DATE _____

DISAPPROVED BY _____ FOR _____ DATE _____

HOLD PENDING FURTHER TESTS _____

REASONS FOR REJECTION OR HOLDING _____

PERCOLATION TEST PLAT/PRELIMINARY PLAT - TITLE OR I.D. # _____ DATE _____

SITE DEVELOPMENT PLAN/FINAL PLAT - TITLE OR I.D. # _____ DATE _____

THIS IS NOT A PERMIT

COUNTY #

SOIL PROFILE


0' 9000
 1' topsoil
 1' org red cl Lm
 3.5' 4' org tan to pale grey sil Lm
 10-15% rock

12' 0' 8062
 1' topsoil
 1' red brn cl Lm
 15' 5' org tan sil Lm
 5-10% rock

0' 8061 A
 1' topsoil
 1' org cl Lm
 5.5' pale org tan sil Lm
 5%+ rock

SOIL PROFILE

0'

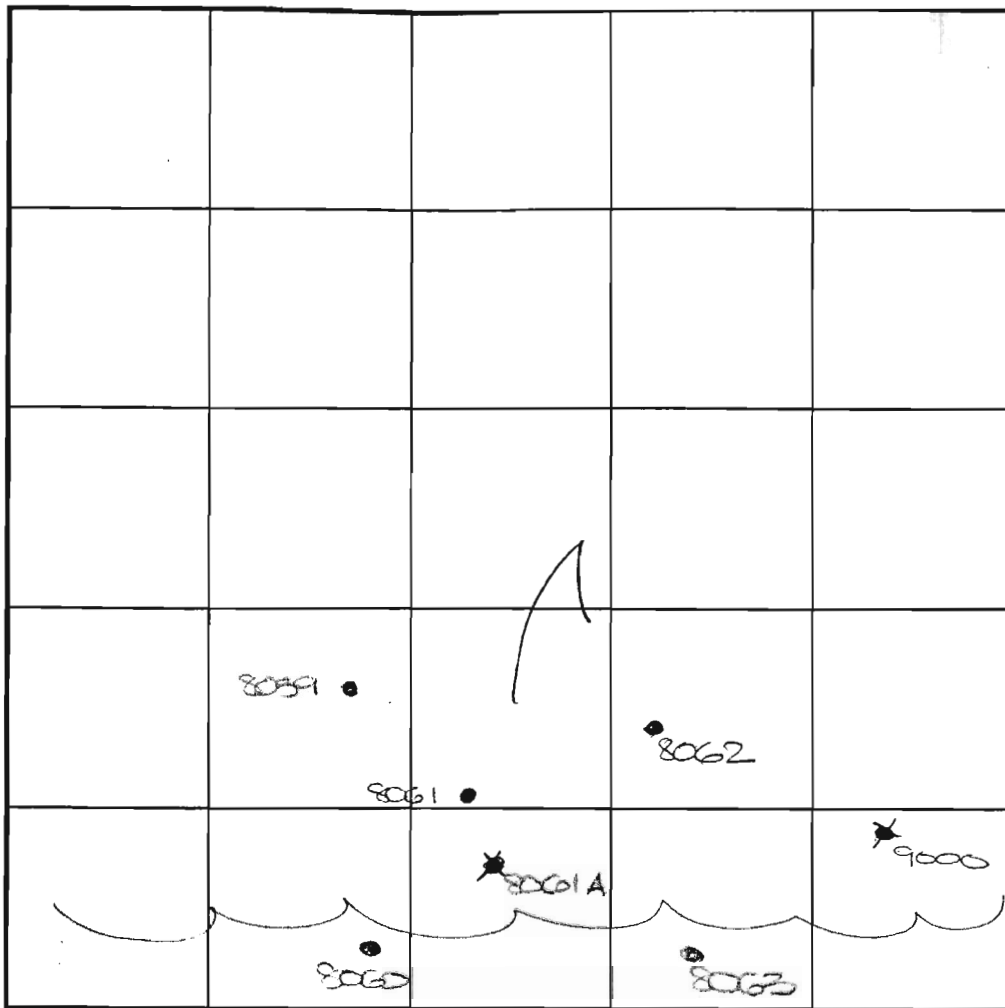

INDICATE NORTH - NAME ADJOINING ROADWAY AS BASE LINE.

DATE	TEST NO.	DEPTH	PRE-WET		TEST - 1" DROP		TIME
			START	STOP	START	STOP	
5-12-03	9000	4' 3" S	5:00	5:09	5:09	5:17	8
		12.0' D	Visual	-see profile			P
	8062	4' 8" S	5:05	slow - stopped			OK
		14' 0" D	Visual	-see profile			P
	8061	6.5' D	Refusal	-60% rock 4'+			F
	8061 A	4.5' S	5:08	5:13	5:13	5:18	5
		13.5' D	Visual	-see profile			P
	8062	5' 8" M	5:35	5:37	5:37	5:41	4
	8059	8.0' D	Refusal	-70% rock 4'+			F

REMARKS

TYPE OF SOIL

TESTED BY

K. CLARK

TRENCH DESIGN DATA: AVG. PERCOLATION TIME

INLET DEPTH

MAXIMUM BOTTOM DEPTH


ALSO PRESENT

TRENCH WIDTH

SQ. FT./BEDROOM

PROPERTY TABULATION

- 1) PROPERTY OWNER: Mr. ROBERT T. MATTHEWS
- 2) DEED RECORDING REFERENCE: LIBER 204, FOLIO 398
- 3) DEED ACREAGE: 45 Aca
- 4) ELECTION DISTRICT: THIRD
- 5) SITE ADDRESS: 2400 PFEFFERKORN ROAD
- 6) PROPERTY LOCATED OUTSIDE METROPOLITAN DISTRICT
- 7) SITE DENSITY:
 - a) TOTAL SITE BY FIELD SURVEY = 48,509 Aca
 - b) PERMITTED CLUSTER LOT DEVELOPMENT = 24 LOTS (48,509Ac x 1.1 LOT/2.0Ac)
 - c) PROPOSED CLUSTER LOTS = 22 LOTS
 - d) PROPOSED BUILDABLE PRESERVATION PARCEL = 1 LOT

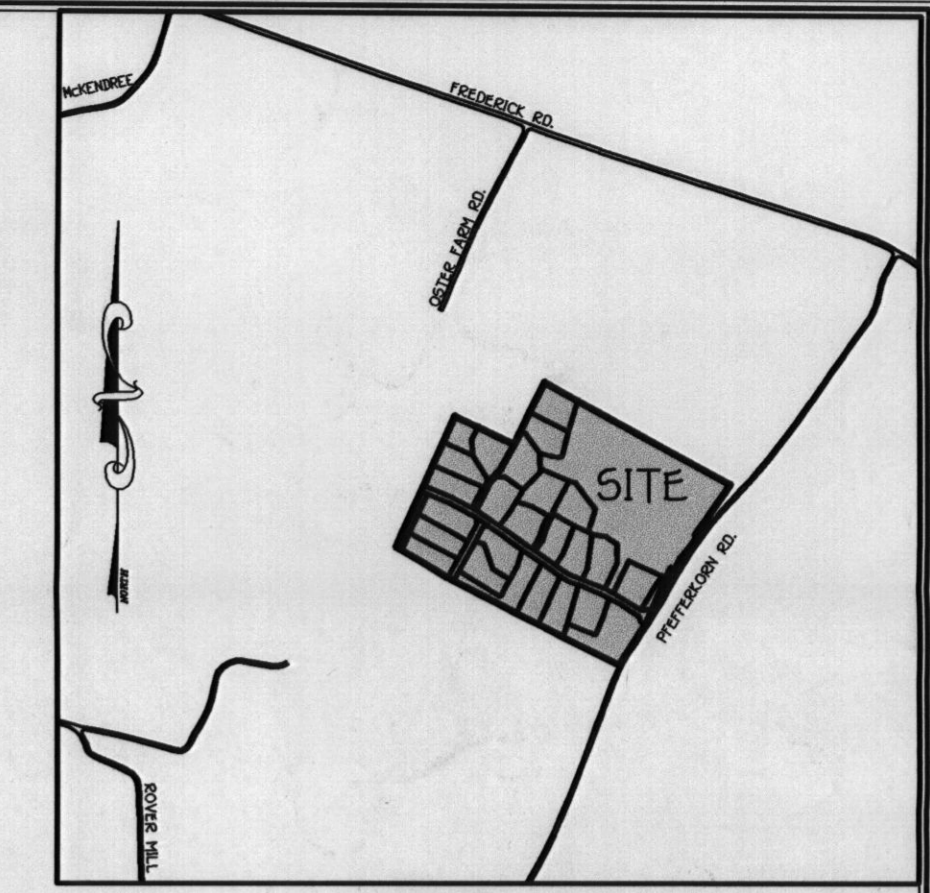

GENERAL NOTES:

1. THIS AREA DESIGNATES A PRIVATE SEWERAGE EASEMENT OF 10,000 SQUARE FEET AS REQUIRED BY THE MARYLAND STATE DEPARTMENT OF THE ENVIRONMENT FOR INDIVIDUAL SEWERAGE DISPOSAL IMPROVEMENTS OF ANY NATURE IN THIS AREA ARE RESTRICTED UNTIL PUBLIC SEWERAGE IS AVAILABLE. THESE EASEMENTS SHALL BECOME NULL AND VOID UPON CONNECTION TO A PUBLIC SEWERAGE SYSTEM. THE COUNTY HEALTH OFFICER SHALL HAVE THE AUTHORITY TO GRANT ADJUSTMENTS TO THE PRIVATE SEWERAGE EASEMENT. RECORDATION OF A MODIFIED SEWERAGE EASEMENT SHALL NOT BE NECESSARY.
2. THE LOT SHOWN HEREON COMPLIES WITH THE MINIMUM OWNERSHIP WIDTH AND LOT AREA AS REQUIRED BY THE MARYLAND STATE DEPARTMENT OF THE ENVIRONMENT.
3. EXISTING WELLS AND/OR SEWERAGE EASEMENTS WITHIN 100 FEET OF THE PROPERTY HAVE BEEN SHOWN FROM THE BEST AVAILABLE INFORMATION.
4. ALL HOUSE SITES SHOWN COMPLY WITH MINIMUM BUILDING RESTRICTION REGULATIONS.
5. ALL WELLS SHALL BE DRILLED PRIOR TO FINAL PLAT RECORDATION. IT IS THE DEVELOPER'S RESPONSIBILITY TO SCHEDULE THE WELL DRILLING PRIOR TO FINAL PLAT SUBMISSION. IT WILL NOT BE CONSIDERED "GOVERNMENT DELAY" IF THE WELL DRILLING HOLDS-UP THE HEALTH DEPARTMENT SIGNATURE OF THE RECORD PLAT.
6. IF THE WELL SUCCESS RATE IS ACCOMPLISHED AT VARIOUS LOCATIONS WITHIN THE SITE, THE DEVELOPER SHALL HAVE THE OPTION TO REQUEST RELIEF FROM DRILLING THE REMAINING WELLS PRIOR TO PLAT RECORDATION.
7. TOPOGRAPHY SHOWN IS FROM HOWARD COUNTY GIS TOPOGRAPHY AT 5' CONTOUR INTERVAL INTERPOLATED FOR 2' CONTOUR INTERVAL.
8. BOUNDARY OUTLINE BASED ON AVAILABLE DEED OF RECORD WITHOUT THE BENEFIT OF A FIELD SURVEY AT THIS TIME.
9. GROUND WATER APPROPRIATION PERMIT SHALL BE OBTAINED PRIOR TO PLAT RECORDATION.
10. NO SLOPES 25% AND GREATER EXIST ON-SITE.

FOR LOTS 1 (SAVE 8002), 2, 3, 4, 5, 6, 7, 8 (SAVE 8026), 9 (SAVE 8007 and 8009), 10 (SAVE 8254 and 8253), 11, 12 (SAVE 8056, 8054 and 8055), 13 (SAVE 8050, 8056A and 8051C) and ADDITIONAL HOLE NUMBERS 9007, 9008, 9009 and 9013 as shown hereon.

I PERSONALLY WITNESSED SOIL PERCOLATION TESTS SHOWN AS "CLOVERFIELD". ALL SEWERAGE DISPOSAL AREAS SHOWN ON THE ABOVE REFERENCED LOTS AND ADDITIONAL HOLES MEET ALL APPLICABLE COMAR REGULATIONS REGARDING ONSITE SEWERAGE DISPOSAL. I RECOMMEND APPROVAL FOR ONSITE SEWERAGE DISPOSAL AND PRIVATE WATER SUPPLIES ON THESE LOTS.

Signature _____ License # _____ Date _____

FOR LOTS 15, 16, 17, 18, 19, 20, 21 and 22, as well as ADDITIONAL HOLE NUMBERS 9007, 9008, 9013, 9009, 8051C, 8056A, 8050, 8052, 8058A, 8051A, 9001A, 8033, 8052A, 8052, 8054, 8056, 8065, 8067, 8069, 8254, 8253, 8257A, 8259, 8262 and 8002 as shown hereon.

I PERSONALLY WITNESSED SOIL PERCOLATION TESTS SHOWN AS "CLOVERFIELD". ALL SEWERAGE DISPOSAL AREAS SHOWN ON THE ABOVE REFERENCED LOTS AND ADDITIONAL HOLES MEET ALL APPLICABLE COMAR REGULATIONS REGARDING ONSITE SEWERAGE DISPOSAL. I RECOMMEND APPROVAL FOR ONSITE SEWERAGE DISPOSAL AND PRIVATE WATER SUPPLIES ON THESE LOTS.

Signature _____ License # _____ Date _____

PERC CERTIFICATION

I certify that the locations shown hereon are based on field locations done under my direct supervision and are based on the best of my professional knowledge and belief.

Signature of Professional Land Surveyor: Terrell A. Fisher, Professional Land Surveyor No. 10692
Date: 4/21/04

APPROVED FOR PRIVATE WATER AND PRIVATE SEWERAGE SYSTEMS, HOWARD COUNTY HEALTH DEPARTMENT.

Signature of County Health Officer: JAD
Date: 5/14/04

FISHER, COLLINS & CARTER, INC.
CIVIL ENGINEERING CONSULTANTS & LAND SURVEYORS
CENTRAL SQUARE OFFICE PARK - 1872 BALTIMORE NATIONAL PIKE
ELLSWORTH CITY, MARYLAND 21042
410.461.2995




SOILS LEGEND		
SOIL	NAME	CLASS
** Ba	Baile silt loam	D
ChA	Chester silt loam, 0 to 3 percent slopes	B
ChB2	Chester silt loam, 3 to 8 percent slopes, moderately eroded	B
ChC2	Chester silt loam, 8 to 15 percent slopes, moderately eroded	B
ChC2	Chester gravelly silt loam, 8 to 15 percent slopes, moderately eroded	B
GIB2	Glenelg loam, 3 to 8 percent slopes, moderately eroded	B
GIC2	Glenelg loam, 8 to 15 percent slopes, moderately eroded	B
GID2	Glenelg loam, 15 to 25 percent slopes, moderately eroded	B
* GrB2	Glenville silt loam, 3 to 8 percent slopes, moderately eroded	C
EID3	Eloak silty clay loam, 15 to 25 percent slopes, severely eroded	B
EkC2	Eloak silt loam, 8 to 15 percent slopes, moderately eroded	B
EkB2	Eloak silt loam, 3 to 8 percent slopes, moderately eroded	B
** Hb	Hatboro silt loam	D
MIC2	Minor loam, 8 to 15 percent slopes, moderately eroded	B
EkC2	Eloak silt loam, 8 to 15 percent slopes, moderately eroded	B
MID3	Minor loam, 15 to 25 percent slopes, severely eroded	B

- LEGEND**
- - - EXISTING 2' CONTOURS
 - - - EXISTING 10' CONTOURS
 - - - EXISTING TREE LINE
 - GLB2, MLC2 SOIL LINES AND TYPES
 - DENOTES PROPOSED WELL
 - DENOTES FAILED PERC
 - DENOTES PASSED PERC
 - DENOTES PROPOSED HOUSE
 - DENOTES 15%-24.9% SLOPES (Not On Site)
 - DENOTES 25% AND GREATER SLOPE (Not On Site)
 - DENOTES 1500 Sq.Ft. ALTERNATE WELL SITE

PERC CERTIFICATION PLAT
LOTS 1-22 AND PRESERVATION PARCELS A,B,C,E, AND E
CLOVERFIELD
(PROPERTY OF ROBERT T. MATTHEWS)

(2400 PFEFFERKORN ROAD) PC 518641
TAX MAP 15 ZONED: RC-DEO PARCEL: 4 GRID: 8
THIRD ELECTION DISTRICT HOWARD COUNTY, MARYLAND
SCALE: 1"= 100' DATE: MARCH 23, 2004
REVISED DATE: APRIL 21, 2004

Signed 5/14/04

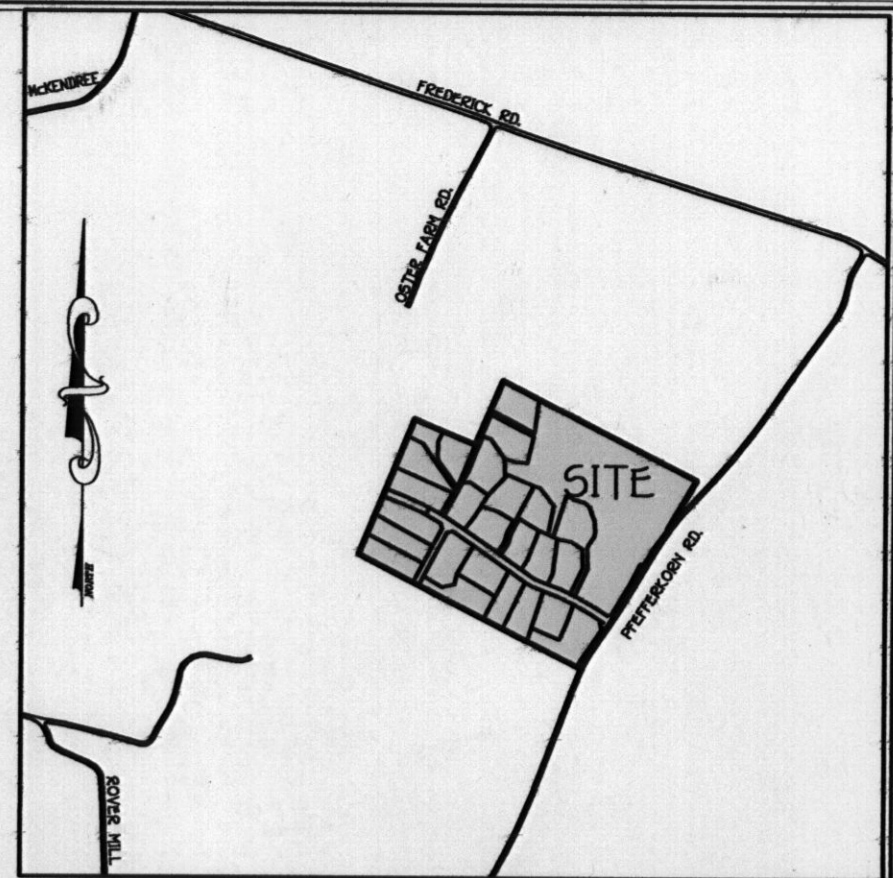

VICINITY MAP
SCALE: 1" = 1200'

GENERAL NOTES:

- THIS AREA DESIGNATES A PRIVATE SEWERAGE EASEMENT OF 10,000 SQUARE FEET AS REQUIRED BY THE MARYLAND STATE DEPARTMENT OF THE ENVIRONMENT FOR INDIVIDUAL SEWERAGE DISPOSAL IMPROVEMENTS OF ANY NATURE IN THIS AREA. THESE EASEMENTS SHALL BECOME NULL AND VOID UPON CONNECTION TO A PUBLIC SEWERAGE SYSTEM. THE COUNTY HEALTH OFFICER SHALL HAVE THE AUTHORITY TO GRANT ADJUSTMENTS TO THE PRIVATE SEWERAGE EASEMENT. RECORDATION OF A MODIFIED SEWERAGE EASEMENT SHALL NOT BE NECESSARY.
- THE LOT SHOWN HEREON COMPLIES WITH THE MINIMUM OWNERSHIP WIDTH AND LOT AREA AS REQUIRED BY THE MARYLAND STATE DEPARTMENT OF THE ENVIRONMENT.
- EXISTING WELLS AND/OR SEWERAGE EASEMENTS WITHIN 100 FEET OF THE PROPERTY HAVE BEEN SHOWN FROM THE BEST AVAILABLE INFORMATION.
- ALL HOUSE SITES SHOWN COMPLY WITH MINIMUM BUILDING RESTRICTION REGULATIONS.
- TOPOGRAPHIC INFORMATION ESTABLISHED AT TWO FOOT INTERVALS BASED ON AERIAL TOPOGRAPHY PREPARED BY SDI, L.L.C. DATED APRIL 14, 2001 AND SUPPLEMENTED BY FIELD RUN TOPOGRAPHY PREPARED BY FISHER, COLLINS & CARTER, INC. DATED APRIL 2002.
- BOUNDARY OUTLINE BASED ON FIELD RUN SURVEY PERFORMED BY FISHER COLLINS & CARTER, INC. DATED APRIL, 2002.
- GROUND WATER APPROPRIATION PERMIT SHALL BE OBTAINED PRIOR TO PLAT RECORDATION.
- NO SLOPES 25% AND GREATER EXIST ON-SITE.



10-2111

SOILS LEGEND

SOIL	NAME	CLASS
** Ba	Baile silt loam	D
ChA	Chester silt loam, 0 to 3 percent slopes	B
ChB2	Chester silt loam, 3 to 8 percent slopes, moderately eroded	B
ChC2	Chester silt loam, 8 to 15 percent slopes, moderately eroded	B
CgC2	Chester gravelly silt loam, 8 to 15 percent slopes, moderately eroded	B
GIB2	Glenelg loam, 3 to 8 percent slopes, moderately eroded	B
GIC2	Glenelg loam, 8 to 15 percent slopes, moderately eroded	B
GID2	Glenelg loam, 15 to 25 percent slopes, moderately eroded	B
GnB2	Glenville silt loam, 3 to 8 percent slopes, moderately eroded	C
ED3	Eloak silty clay loam, 15 to 25 percent slopes, severely eroded	B
EkC2	Eloak silt loam, 8 to 15 percent slopes, moderately eroded	B
EkB2	Eloak silt loam, 3 to 8 percent slopes, moderately eroded	B
** Ha	Hatboro silt loam	D
MnC2	Minor loam, 8 to 15 percent slopes, moderately eroded	B
EkC2	Eloak silt loam, 8 to 15 percent slopes, moderately eroded	B
MID3	Minor loam, 15 to 25 percent slopes, severely eroded	B

- NOTES:
 * Hydric soils and/or contains hydric inclusions
 ** May contain hydric inclusions
 † Generally only within 100-year floodplain areas


THE PURPOSE OF THIS REVISED PERC PLAN IS TO REMOVE THE EXISTING WELL BOX'S TO A WELL SITE AND 2 ALTERNATE WELL SITES.

AMENDED PERC CERTIFICATION PLAT
CLOVERFIELD

Lots 3 - 8, 11, 13, 16 18, And 20
 TAX MAP 15 ZONED: RC-DEO PARCEL: 4 GRID 8
 THIRD ELECTION DISTRICT HOWARD COUNTY, MARYLAND
 SCALE: 1" = 100' DATE: April 29, 2010

LEGEND

- EXISTING 2' CONTOURS
- EXISTING 10' CONTOURS
- EXISTING TREE LINE
- SOIL LINES AND TYPES
- DENOTES PROPOSED WELL
- DENOTES FAILED PERC
- DENOTES PASSED PERC
- DENOTES PROPOSED HOUSE
- DENOTES 15%-24.9% SLOPES (Not on Site)
- DENOTES 25% AND GREATER SLOPE (Not on Site)
- DENOTES 1500 Sq.Ft. ALTERNATE WELL SITE

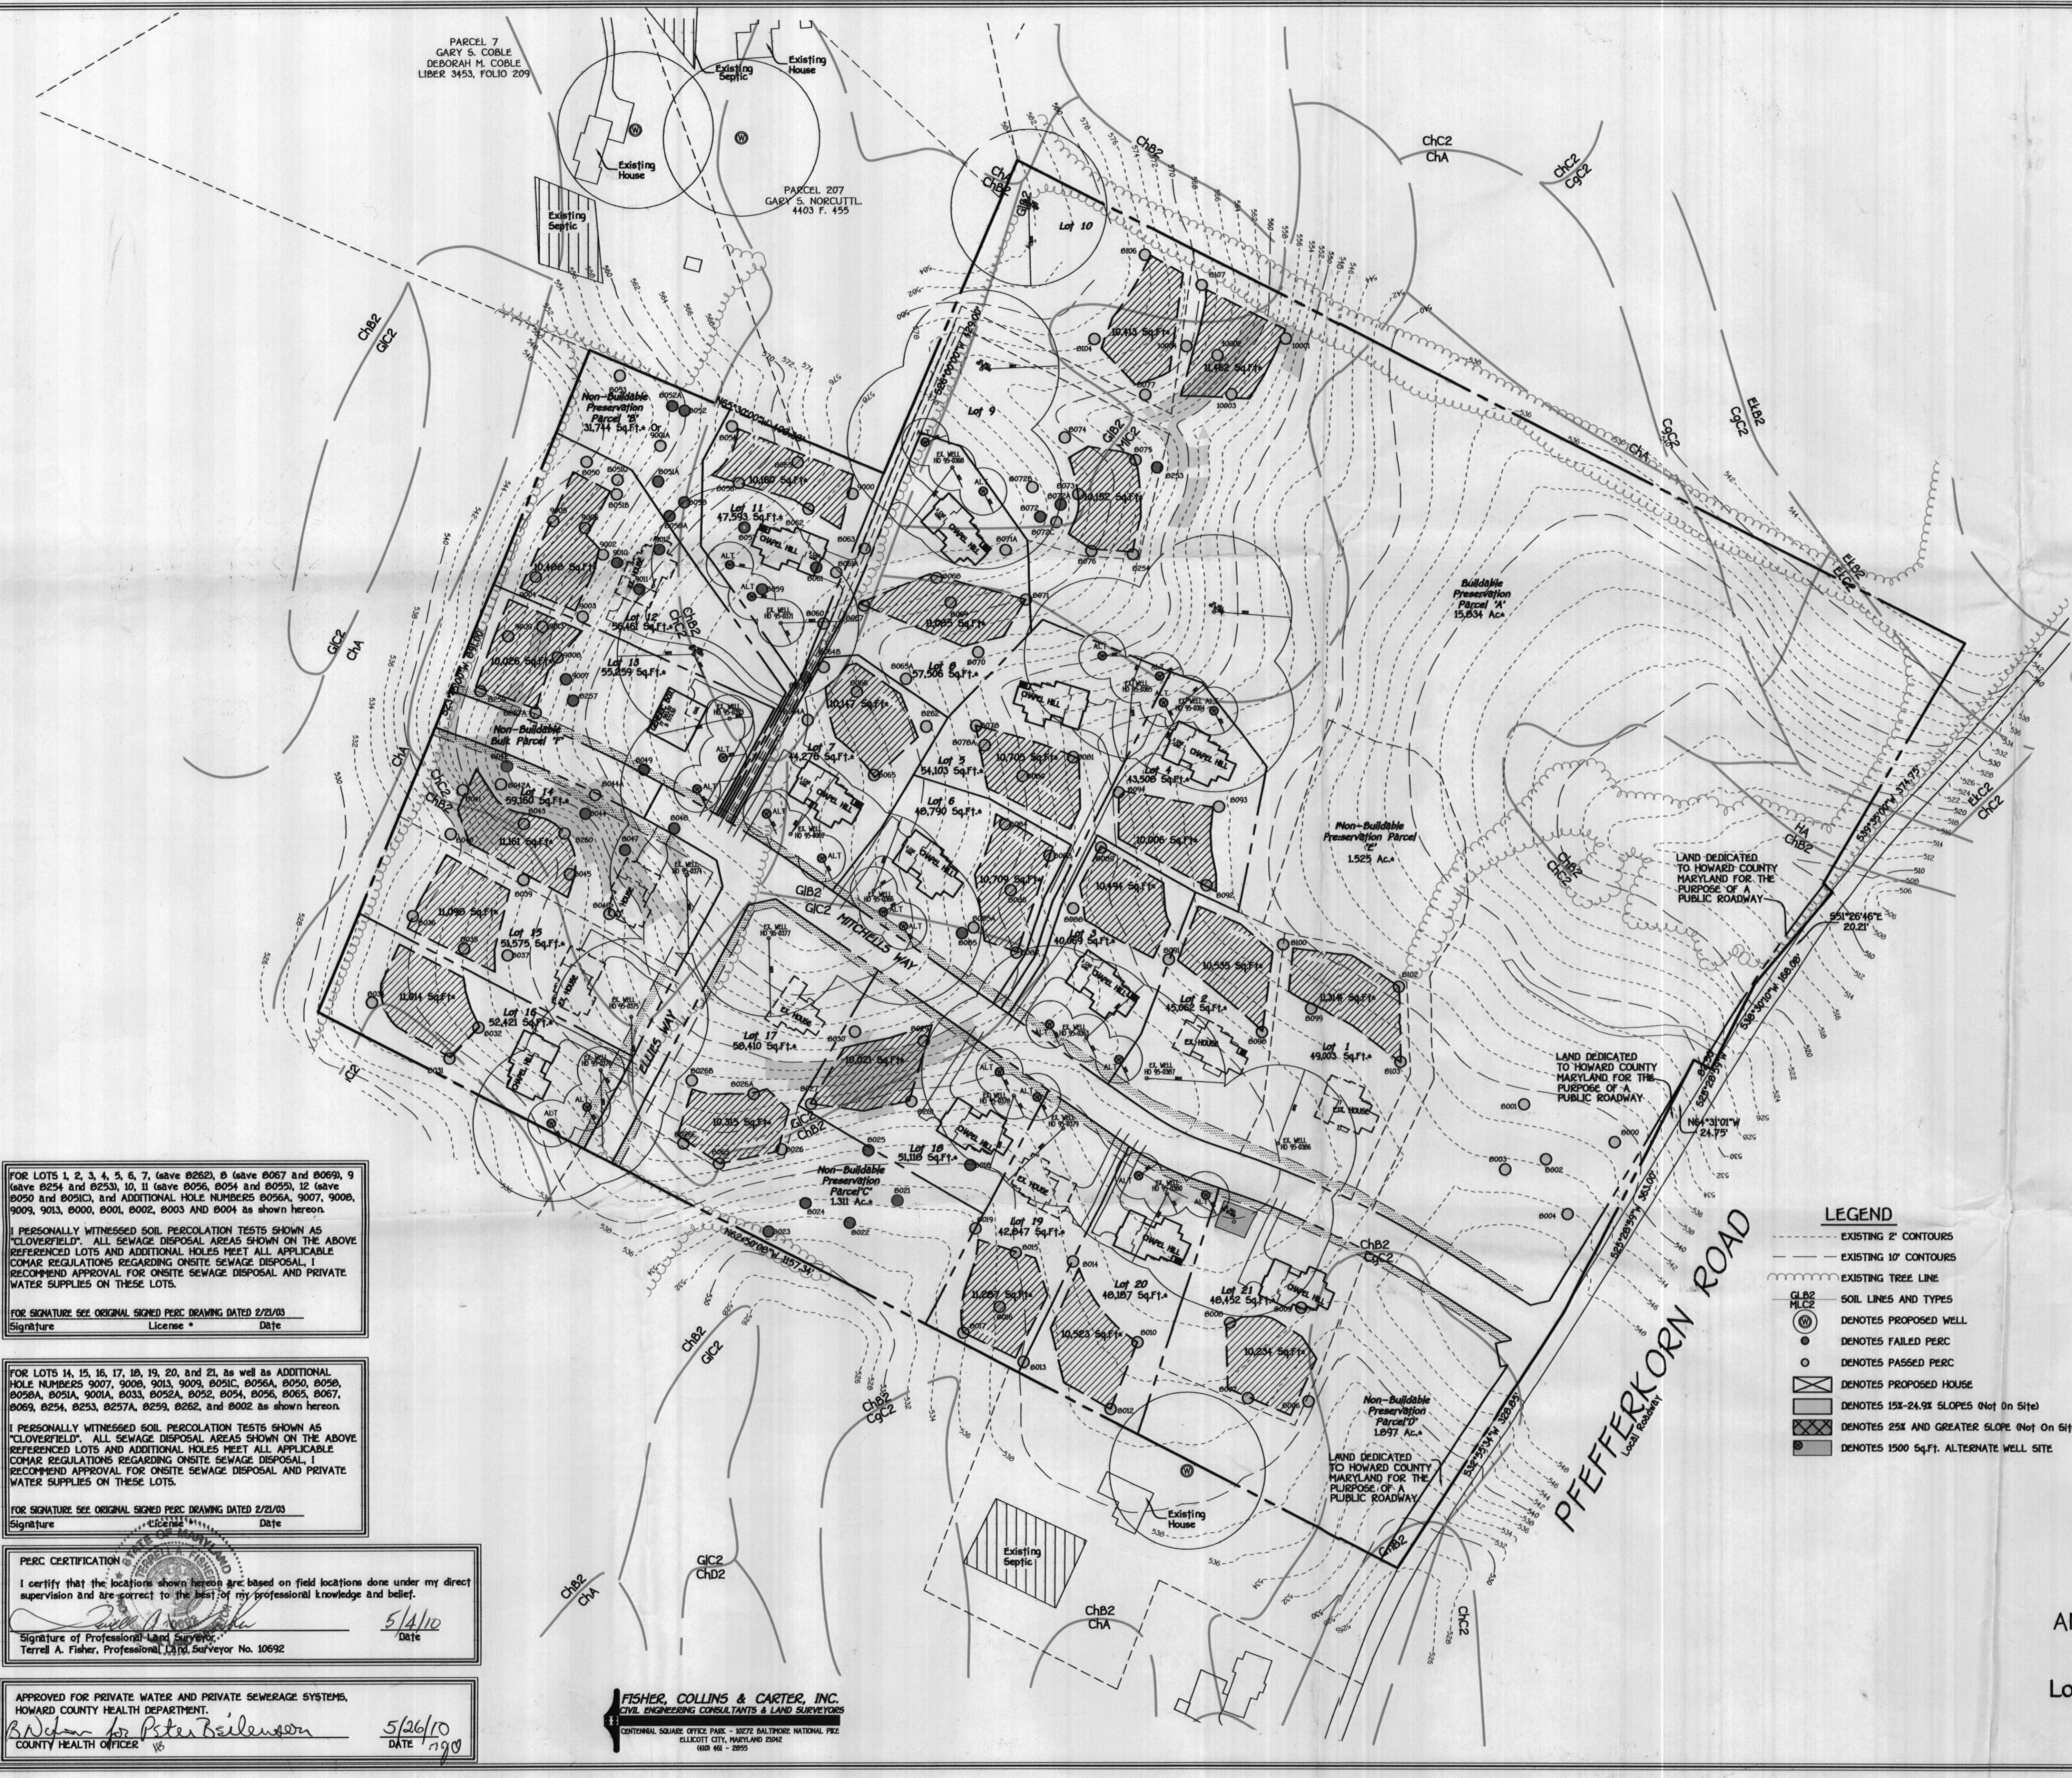

FOR LOTS 1, 2, 3, 4, 5, 6, 7, (leave 8262), 8 (leave 8067 and 8069), 9 (leave 8254 and 8253), 10, 11 (leave 8056, 8054 and 8055), 12 (leave 8050 and 8053), and ADDITIONAL HOLE NUMBERS 8056A, 9007, 9008, 9009, 9013, 8000, 8001, 8002, 8003 AND 8004 as shown hereon.
 I PERSONALLY WITNESSED SOIL PERCOLATION TESTS SHOWN AS "CLOVERFIELD". ALL SEWAGE DISPOSAL AREAS SHOWN ON THE ABOVE REFERENCED LOTS AND ADDITIONAL HOLES MEET ALL APPLICABLE COMAR REGULATIONS REGARDING ONSITE SEWAGE DISPOSAL. I RECOMMEND APPROVAL FOR ONSITE SEWAGE DISPOSAL AND PRIVATE WATER SUPPLIES ON THESE LOTS.
 FOR SIGNATURE SEE ORIGINAL SIGNED PERC DRAWING DATED 2/2/03
 Signature _____ License # _____ Date _____

FOR LOTS 14, 15, 16, 17, 18, 19, 20, and 21, as well as ADDITIONAL HOLE NUMBERS 9007, 9008, 9013, 9009, 8054, 8056A, 8050, 8058, 8058A, 8051A, 9001A, 8033, 8052A, 8052, 8054, 8056, 8065, 8067, 8069, 8254, 8253, 8257A, 8259, 8262, and 8002 as shown hereon.
 I PERSONALLY WITNESSED SOIL PERCOLATION TESTS SHOWN AS "CLOVERFIELD". ALL SEWAGE DISPOSAL AREAS SHOWN ON THE ABOVE REFERENCED LOTS AND ADDITIONAL HOLES MEET ALL APPLICABLE COMAR REGULATIONS REGARDING ONSITE SEWAGE DISPOSAL. I RECOMMEND APPROVAL FOR ONSITE SEWAGE DISPOSAL AND PRIVATE WATER SUPPLIES ON THESE LOTS.
 FOR SIGNATURE SEE ORIGINAL SIGNED PERC DRAWING DATED 2/2/03
 Signature _____ License # _____ Date _____

PERC CERTIFICATION
 I certify that the locations shown hereon are based on field locations done under my direct supervision and are correct to the best of my professional knowledge and belief.
 Signature of Professional Land Surveyor: *Terril A. Fisher* Date: 5/11/10
 Terril A. Fisher, Professional Land Surveyor No. 10692

APPROVED FOR PRIVATE WATER AND PRIVATE SEWERAGE SYSTEMS,
 HOWARD COUNTY HEALTH DEPARTMENT.
 Signature of Professional Health Officer: *B. Nelson* Date: 5/26/10
 COUNTY HEALTH OFFICER DATE 7/9/10

FISHER, COLLINS & CARTER, INC.
 CIVIL ENGINEERING CONSULTANTS & LAND SURVEYORS
 CENTRAL SQUARE OFFICE PARK - 18772 BALTIMORE NATIONAL PIKE
 ELICOTT CITY, MARYLAND 21038
 410 481 - 2855