

PUB. SEWER STATUS VERIFIED BY NA

ISSUE DATE: 3/21/02

APPROVAL DATE: _____

P 516878-BC

A Repair

PERMIT INDEXED

RPS# 352238
04-

ON-SITE SEWAGE DISPOSAL SYSTEM HOWARD COUNTY HEALTH DEPARTMENT BUREAU OF ENVIRONMENTAL HEALTH

Hatfield's Equipment IS PERMITTED TO INSTALL ALTER

ADDRESS: 13785 Burntwoods Road, Glenelg PHONE NUMBER: 301-854-6172

SUBDIVISION: Congedo Property LOT NUMBER: _____

ADDRESS: 885 Route 97 PROPERTY OWNER: John Congedo

SEPTIC TANK CAPACITY (GALLONS): ex 4? **NO TRENCH WORK**

PUMP CHAMBER CAPACITY (GALLONS): _____ **DONE**

NUMBER OF BEDROOMS: _____ **LINE (PIPE) REPLACED**

SQUARE FEET PER BEDROOM: _____ **4/29/02 - (SRU)**

LINEAR FEET OF TRENCH REQUIRED: _____ **T/C w/ Hatfields**

TRENCHES:	Trench to be _____ feet wide. Inlet _____ feet below original grade. Bottom maximum depth _____ feet below original grade. Effective area begins at _____ feet of stone below distribution pipe.
LOCATION:	_____
PURPOSE:	Existing septic system is failing. Call for inspection when ground is opened so sanitarian can recommend repair.

PLANS APPROVED: _____ DATE: _____

- NOTE: PERMIT VOID AFTER 2 YEARS
- NOTE: CONTRACTOR RESPONSIBLE FOR SCHEDULING A PRE-CONSTRUCTION INSPECTION FOR ALL INSTALLATIONS
- NOTE: WATERTIGHT SEPTIC TANKS REQUIRED
- NOTE: ALL PARTS OF SEPTIC SYSTEM SHALL BE 100 FEET FROM ANY WATER WELL
- NOTE: MANHOLE RISERS REQUIRED ON ALL SEPTIC TANKS AND PUMP CHAMBERS

NEITHER THE HOWARD COUNTY COUNCIL NOR THE HEALTH DEPARTMENT IS RESPONSIBLE FOR THE SUCCESSFUL OPERATION OF ANY SYSTEM PERMITTEE RESPONSIBLE FOR OBTAINING FINAL APPROVAL ON THIS PERMIT CALL 410-313-2640 FOR INSPECTION OF SEPTIC SYSTEM

B00117789
Bedroom / Bath / Kitchen
remodel addition
per ALM

J. Thompson

INSPECTOR

DATE SYSTEM APPROVED

12-1-01

Working for 25' x 32' = 784 sq ft OK. 11/2/01

ABSORBENT AREA

SEEPAGE PITS, INSIDE DIAMETER

NUMBER OF TRENCHES

GRAVEL DEPTH

TILE FIELD, DEPTH

DISTRIBUTION BOX, LEVEL

IK


SEPTIC TANK, LEVEL

OK 25'

clean type


PERMIT CARD

INDICATE NORTH - MARK ADJOINING ROADWAY AS BASE LINE

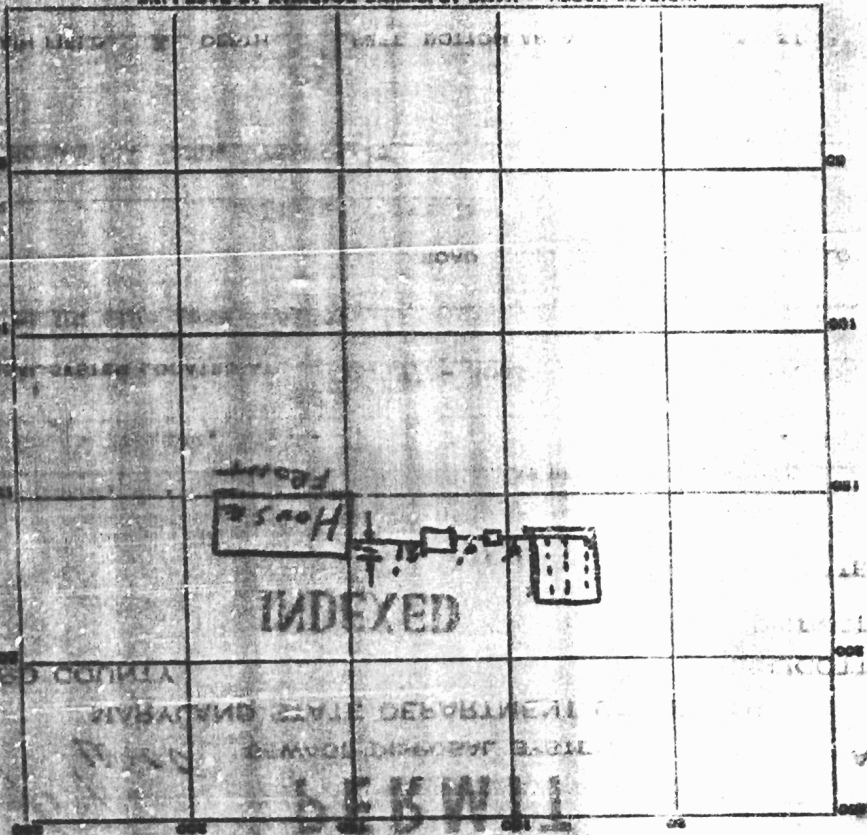

INDEXED

DEBWI

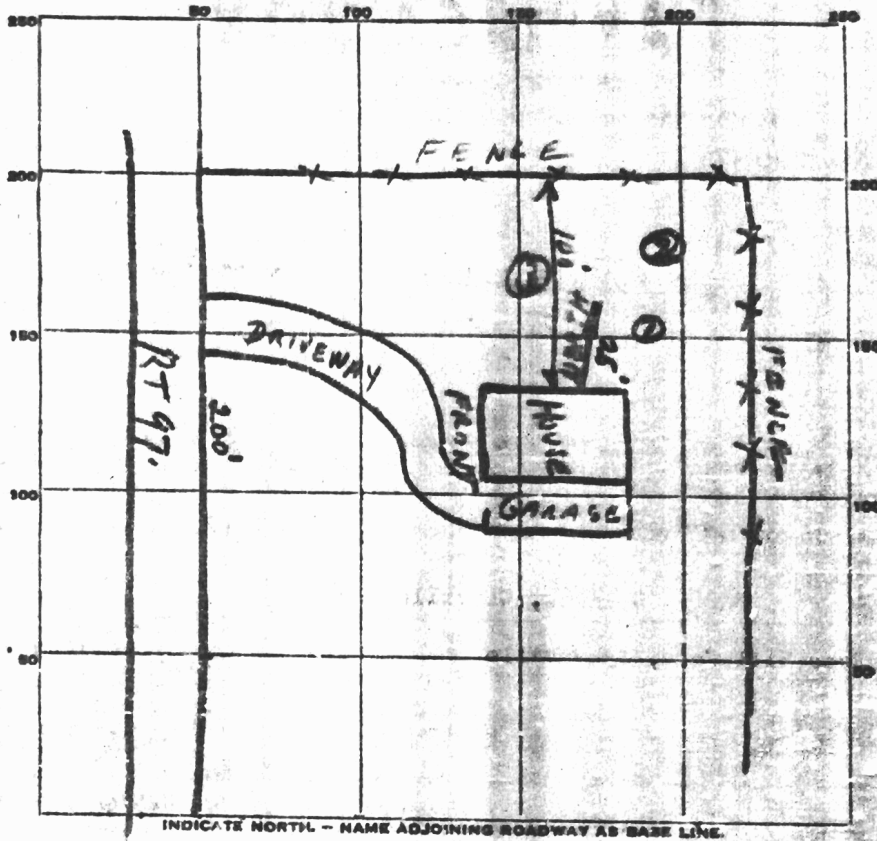

DATE	TEST NO.	DEPTH	PRE-WET		TEST - 1" DROP		TIME
			START	STOP	START	STOP	
11-1-60	1	3 FT	10:02	10:12	10:12	10:31	19 2/3 minutes
	2		10:07	10:55	48 min.		
	3		10:17	10:31	10:31	10:55	24 minutes
11-22-10	4	4 FT	10:51	11:08	11:08	11:35	27 minutes

5 stone in hole

SOIL AUGER FINDING _____
 TESTED BY J. H. ...
 REMARKS Grills 25 ft start / very weathered house wall.
11-1-60
 ALSO PRESENT ... LOT NO. _____

4/22/60
10:00
PERMIT
SEWAGE DISPOSAL SYSTEM

MARYLAND STATE DEPARTMENT OF HEALTH
HOWARD COUNTY
ELLICOTT CITY
DISTRICT 4
DATE 11/15/60

INDEXED

John Burgoon, Jr.
IS PERMITTED TO INSTALL ALTER
ADDRESS 1243 Leeds Terrace, Balto. 27 PHONE 31. 2-4375

A SEWAGE DISPOSAL SYSTEM LOCATED AT Rt. 97 - Needs Mill Rd. 1/4 mi. So. Rt. 40 on
right side road E side.

SUBDIVISION _____ ROAD _____ LOT _____

PROPERTY OWNER Collins, Carville

ADDRESS Rose Hill Farm, Sykesville

SPECIFICATIONS
DRAIN FIELD R DEPTH 3 FEET, BOTTOM AREA 704 SQ. FT.
SEEPAGE PITS _____ ABSORBENT SIDE-WALL AREA _____ SQ. FT.
SEPTIC TANK CAPACITY 1000 GALLONS

FOR GARBAGE GRINDER, INCREASE DISPOSAL AREA 25% & TANK CAPACITY 50%
OTHER locate - starting 25 ft. from the north side house wall and 10 ft. off
off left side property line. Left side property line determined when facing lot
from Rt. 97.


or 750 sq ft leaching bed
11/14/60 Leaching bed already in Permitted
PLANS APPROVED BY James E. Hennigan DATE 11/15/60

FILL SEPTIC TANK AND DISTRIBUTION BOX WITH WATER BEFORE CALLING FOR AN INSPECTION. COVER NO WORK UNTIL INSPECTED AND APPROVED.
NEITHER THE HOWARD COUNTY COMMISSIONERS NOR THE HEALTH DEPARTMENT IS RESPONSIBLE FOR THE SUCCESSFUL OPERATION OF ANY SYSTEM.

11/15/60

INDEX OF SHEETS

- S ARCHITECTURAL SITE PLAN
- E EXISTING CONDITIONS
- 1 EXTERIOR ELEVATIONS
- 2 EXTERIOR ELEVATIONS
- 3 BASEMENT- FOUNDATION PLAN
- 4 FIRST FLOOR PLAN - WINDOW+DOOR SCHED.
- 5 SECOND FLOOR PLAN
- 6 WALL SECTION - CONST NOTES - FINISH SCHED.
- 7 BUILDING SECTIONS - FLOOR FRAMING PLANS
- 8 BUILDING SECTIONS - ROOF FRAMING PLAN
- 9 DETAILS
- 10 DETAILS
- 11 DETAILS

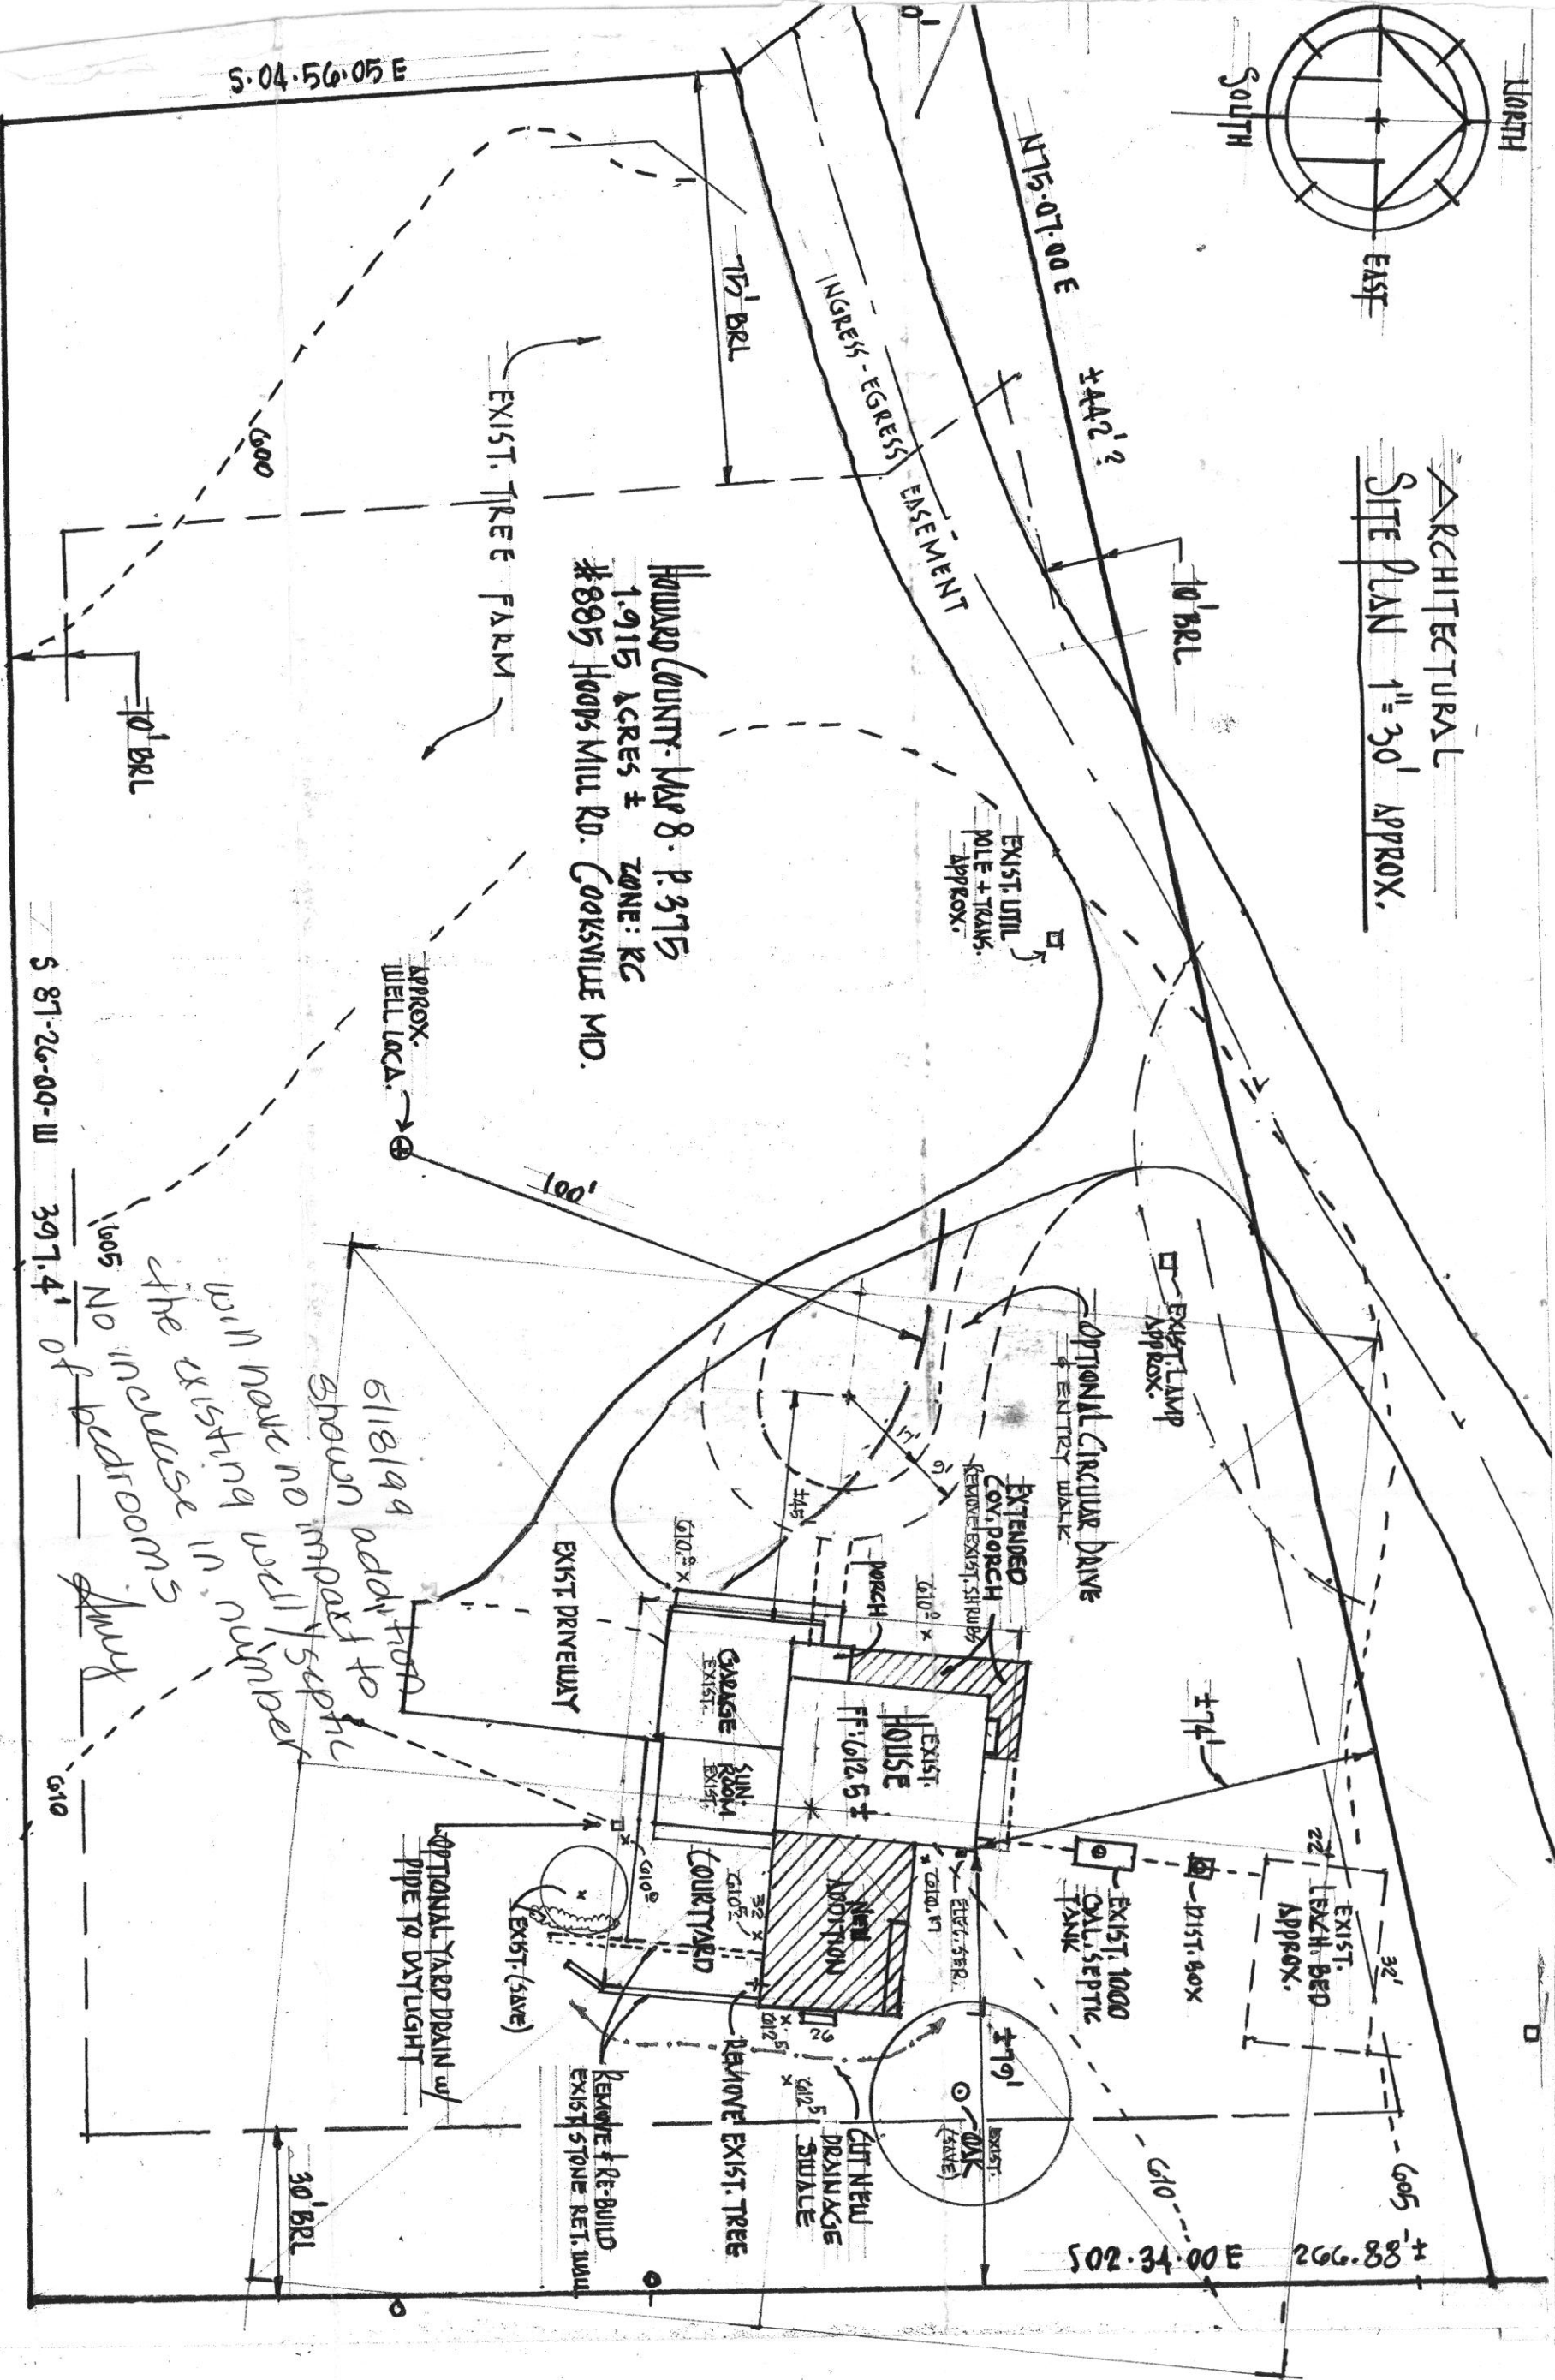

NOTES

- 1. EXISTING SITE CONDITIONS BASED ON INFORMATION PROVIDED BY THE OWNER & THEIR AGENTS
- 2. FINISH FLOOR & SPOT ELEVATIONS ARE ESTIMATED
- 3. EXISTING HOWARD COUNTY SEPTIC PERMIT A03122
- 4. EXISTING WELL # HO-92-0109

FARM HOUSE ADDITION

885 HOODS MILL ROAD COOKSVILLE MD
 OWNER: JOHN & LINDA CONGEDO

KMA - Kevin McKenna Architects

PO Box 722 Columbia MD 21045
 Tel: 410-381-5817 Fax: 410-381-0929

DATE
 05 MAY 99

BY

DRAWN

CHECKED

SCALE
 As NOTED

JOB NO.

SHEET

5

OF SHEETS