

# APPLICATION

FOR PERCOLATION TESTING AND SITE EVALUATION

EST DATE(S) \_\_\_\_\_ TEST TIME \_\_\_\_\_

AP 520106

AGENCY REVIEW: \_\_\_\_\_

DATE 3/19/04

DO NOT WRITE ABOVE THIS LINE

HEREBY APPLY FOR THE NECESSARY TESTING/EVALUATION PRIOR TO ISSUANCE OF SEWAGE DISPOSAL SYSTEM PERMIT(S) TO:

CHECK AS NEEDED:

- CONSTRUCT NEW SEPTIC SYSTEM(S)
- REPAIR/ADD TO AN EXISTING SEPTIC SYSTEM
- REPLACE AN EXISTING SEPTIC SYSTEM

CHECK AS NEEDED:

- NEW STRUCTURE(S)
- ADDITION TO AN EXISTING STRUCTURE
- REPLACE AN EXISTING STRUCTURE

CHECK ONE:

- CREATE NEW LOT(S)
- BUILD ON AN EXISTING LOT IN A SUBDIVISION
- BUILD ON AN EXISTING PARCEL OF RECORD

IS THE PROPERTY WITHIN 2500' OF ANY RESERVOIR?

- YES
- NO

THE TYPE OF STRUCTURE IS:

- RESIDENTIAL WITH UNKNOWN PROPOSED BEDROOMS IN THE COMPLETED STRUCTURE (NOTE UNKNOWN IF APPROPRIATE)
- COMMERCIAL (PROVIDE DETAIL OF NUMBERS AND TYPES OF EMPLOYEES/ CUSTOMERS ON ACCOMPANYING PLAN)
- INSTITUTIONAL/GOVERNMENT (PROVIDE DETAIL OF NUMBERS AND TYPES OF EMPLOYEES/USERS ON ACCOMPANYING PLAN)

PROPERTY OWNER(S) PRINCE FLORENCE UNDINE

ANYTIME PHONE \_\_\_\_\_ CELL \_\_\_\_\_ FAX \_\_\_\_\_

MAILING ADDRESS \_\_\_\_\_ STREET CITY/TOWN STATE ZIP

APPLICANT Hailey Development c/o RICH THOMETZ

ANYTIME PHONE (301) 476-7715 CELL (301) 346-1037 FAX (301) 476-7717

MAILING ADDRESS 3905 NATIONAL DRIVE, SUITE 105, BURTONSVILLE MD. 20866  
STREET CITY/TOWN STATE ZIP

APPLICANT'S ROLE: DEVELOPER BUILDER BUYER RELATIVE/FRIEND REALTOR CONSULTANT

PROPERTY LOCATION  
SUBDIVISION/PROPERTY NAME PRINCE PROPERTY LOT NO. 7

PROPERTY ADDRESS END OF HUNTERBROOKE LANE / HUNTFIELD DRIVE  
STREET TOWN/POST OFFICE

AX MAP PAGE(S) 46 GRID 137 PARCEL(S) 104 PROPOSED LOT SIZE \_\_\_\_\_


I, AS APPLICANT, I UNDERSTAND THE FOLLOWING: THE SYSTEM INSTALLED SUBSEQUENT TO THIS APPLICATION IS ACCEPTABLE ONLY UNTIL PUBLIC SEWERAGE IS AVAILABLE. THIS APPLICATION IS COMPLETE WHEN ALL APPLICABLE FEES AND A DETAILED SITE PLAN HAVE BEEN RECEIVED. I ACCEPT THE RESPONSIBILITY FOR COMPLIANCE WITH ALL M.O.S.H.A. AND "MINIMUM UTILITY" REQUIREMENTS. APPROVAL IS BASED UPON SATISFACTORY REVIEW OF A PERC CERTIFICATION PLAN.

BEST RESULTS WILL BE MAILED TO APPLICANT.

Eschmaria G. Frisch (agent for Developer)  
SIGNATURE OF APPLICANT

HOWARD COUNTY HEALTH DEPARTMENT, BUREAU OF ENVIRONMENTAL HEALTH, WELL AND SEPTIC PROGRAM  
3525-H ELLICOTT MILLS DRIVE, ELLICOTT CITY, MARYLAND 21043-4544 (410) 313-1771 FAX (410) 313-2648  
TDD (410) 313-2323 TOLL FREE 1-877-4MD-DHMH

AP 520106

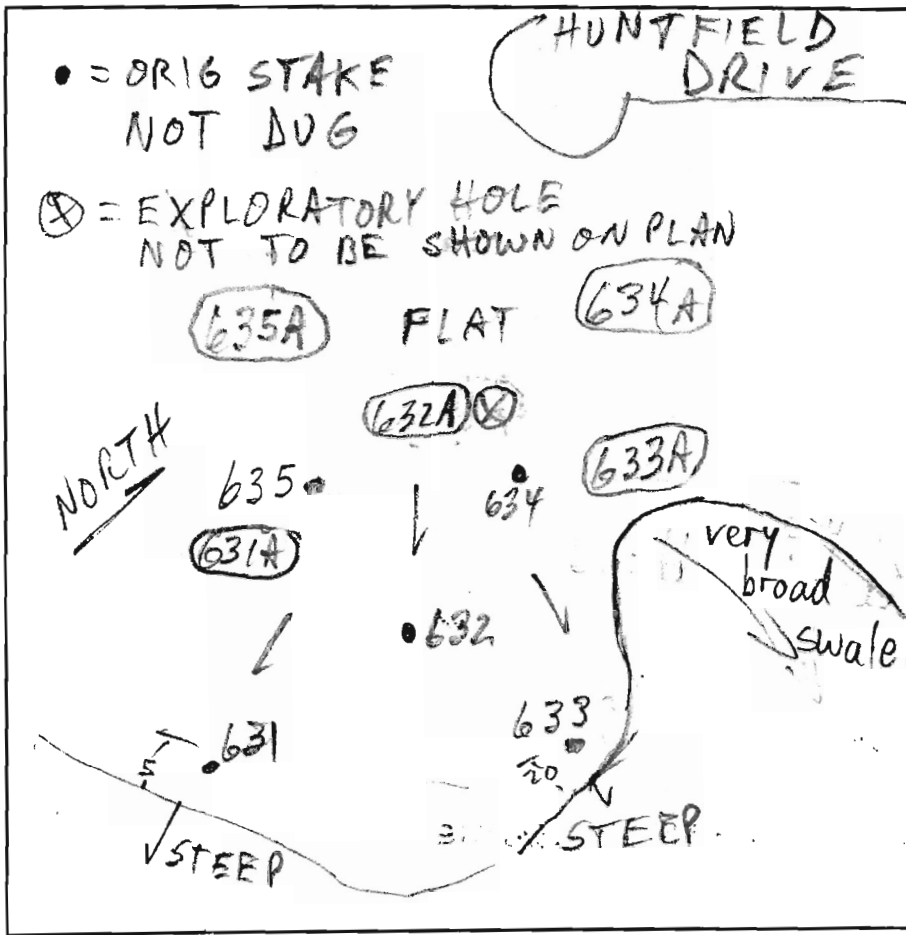

631A  
 orge hv ylm  
 2  
 2 1/2  
 tan gray light brn sand  
 25-35% Rx  
 10 1/2  
 HARD BOT

634A  
 orge hv ylm  
 2 1/2  
 -4  
 brn samilm  
 15-25% Rx  
 WORSE  
 ? NORTH  
 11-12

635A  
 orge dk. brn hv ylm  
 3 1/4  
 brn samilm  
 15-25% Rx  
 11 1/2

633A  
 brn hv sailm  
 2  
 brn samilm  
 3  
 25% Rx  
 DOWN HILL  
 7  
 11  
 10% frags UPHILL

632A  
 orge brn hv ylm  
 3 3/4  
 brn dk brn samilm  
 15-25% Rx  
 12 1/2

DATE	TEST #	DEPTH	START	BREAK 1' DROP	STOP 2' DROP	TIME OF 2ND INCH	P/F/H
4/20/04	631A	3	11:00:05	11:12:00	11:15	3	P
	631A	7 1/2	11:37	11:40	11:43	3	P
	631A	5 3/2	11:29	11:32	11:37	5 EST	P
	635A	11 1/2					P
	632A	4	11:46	11:52	12:03	11	P
	632A	12 1/2					P
	633A	11					P

REMARKS ALL HOLES NOT PER PLAN ORIG STAKED SDA UNACCEPTABLE  
 SANITARIAN M. Ripkin BACKHOE K&K OTHERS Hailey Development  
 TEST HOLES USED IN SDA ALL AVG. PERC TIME 5 SQ. FT/BR 180  
 TRENCH WIDTH 3 INLET DEPTH 3 MAX. BOT DEPTH 5 EFFECTIVE SW 2



3R  
Signed  
PC 3/1/07  
FF: 420.3  
B: 411.3

Proposed Septic  
Easement:  
10,030 SF

LOT 7  
3.021±Ac

MIB2

24' Private  
Use-in-common  
Access, Drainage &  
Utility Easement for  
lots 4, 5, 6, & 7.

SSF

LOD

MIB2

88  
Reten  
Area