


B06002909

Permit

MEADOW DISTRICT

B12001557 APPROVED ONLINE  
5-11-12 BY HEIDI SCOTT  
FOR REDECKING EX. UPPER AND LOWER  
DECKS

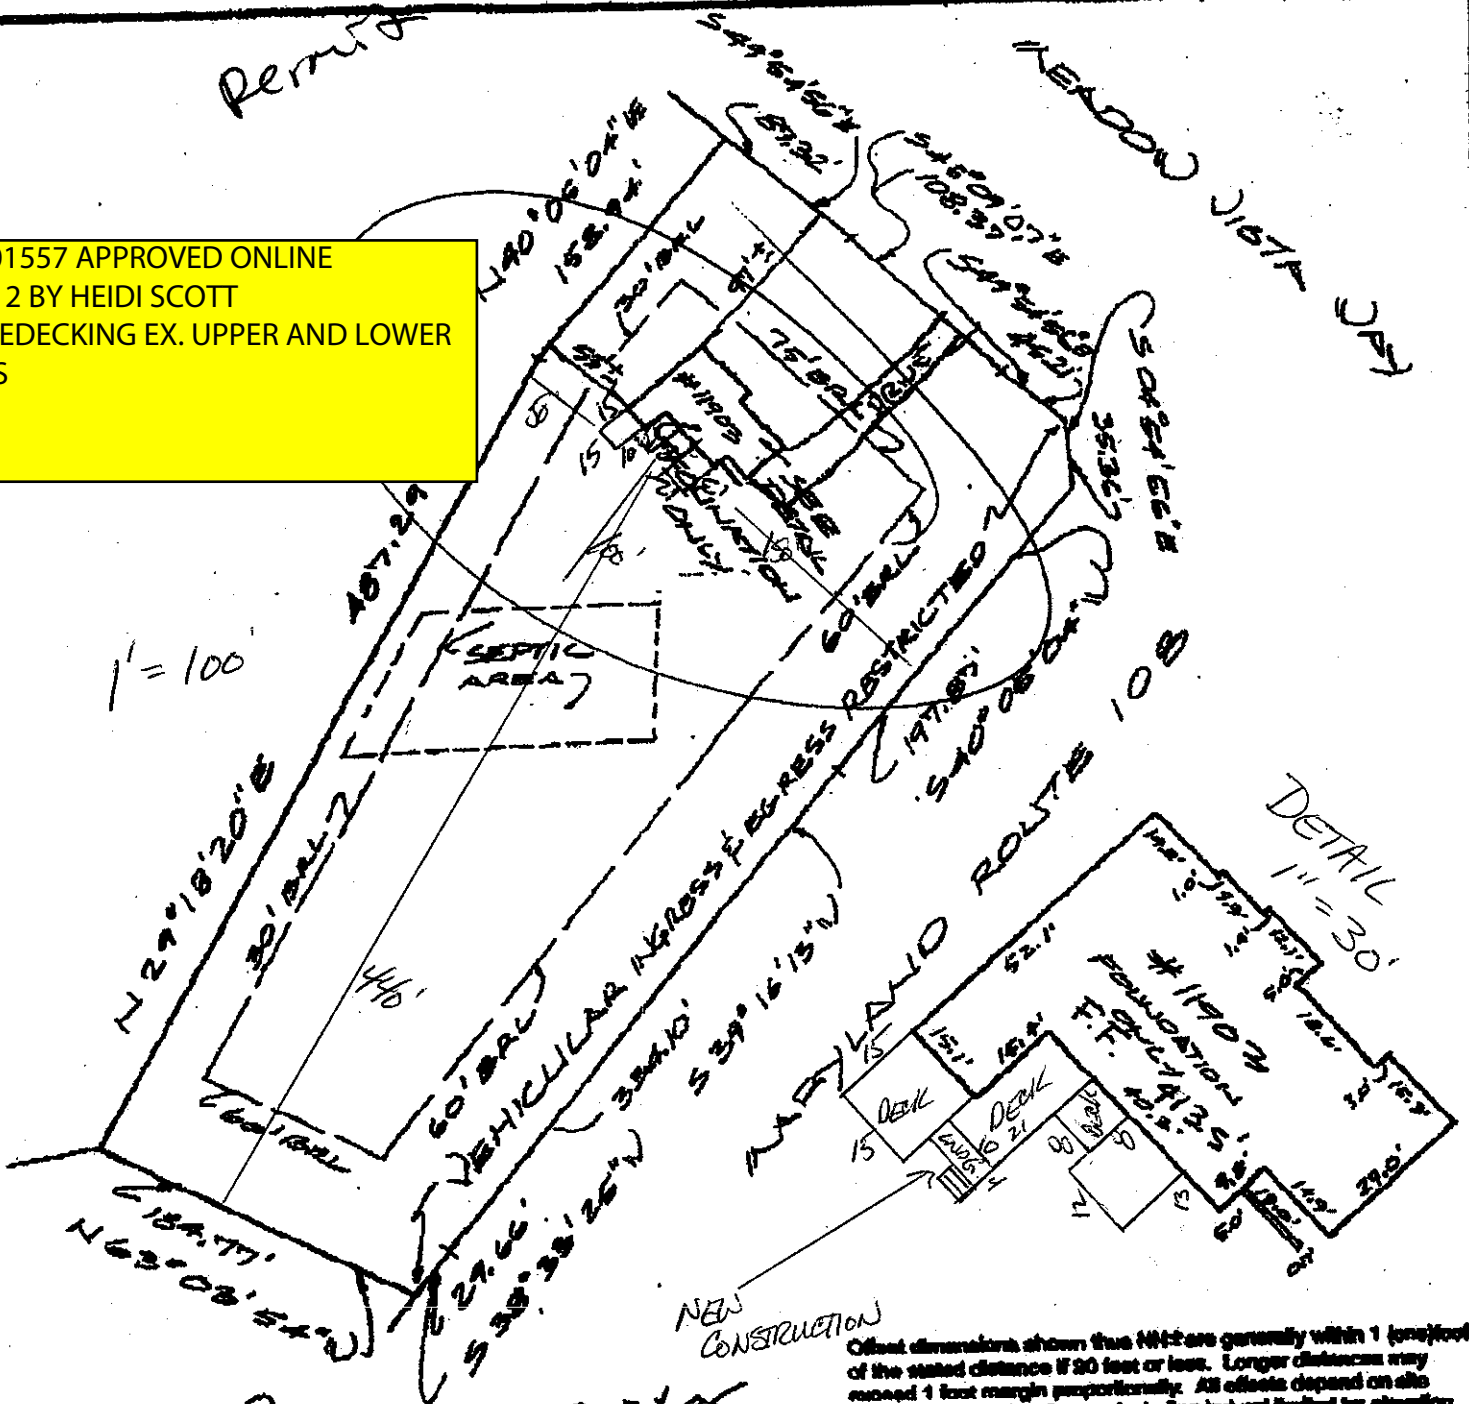

1" = 100'

DETAIL  
1" = 30'

Offset dimensions shown true HWT are generally within 1 (one) foot of the stated distance if 50 feet or less. Longer distances may exceed 1 foot margin proportionally. All offsets depend on site conditions and other factors including but not limited to; situation changes, availability of property markers, availability and age of land record data, irregularly shaped and/or large lots.

*Mark Lawrence* 7-28-95  
Date  
MD Reg. Professional Surveyor 90216 Jefferson D. Lawrence

Property shown hereon is not in a flood plain per existing records unless otherwise noted

**O'CONNELL & LAWRENCE, INC.**  
Surveyors, Engineers & Land Planners  
17904 Georgia Avenue, Suite 302  
Oxay, Maryland 20832-2239  
(301) 924-4370 FAX (301) 924-3872

**HOUSE LOCATION DRAWING**  
LOT 26 SECTION ONE  
CLEARVIEW ESTATES  
HOWARD COUNTY MARYLAND  
Plat Book: Plat 8740 Liber. Folio:

**SURVEYOR'S CERTIFICATION**  
I hereby certify to the best of my knowledge and belief that the property delineated hereon is in accordance with the Plat of Subdivision on file of record, that the improvements were located by accepted field practices and include permanent visible structures and encroachments, if any. This drawing is not to be relied upon for the establishment or location of fences, gates, buildings or other existing or future improvements. This drawing does not provide for the accurate identification of property boundary lines, but such identification may not be required for the transfer of title or securing financing or refinancing. Questions pertaining to relationships of the property corners or lines to real objects must be addressed by a Boundary Survey. This drawing is of benefit to a consumer only insofar as it is required by a lender or title insurance company or its agent in connection with contemplated transfer, financing or refinancing, and valid only within six months from said date, and as to them I warrant the accuracy of the drawing. No site report furnished.

Job No. 218-07  
Scale 1" = 100'  
Field Date  
Plot Check 7/25/95  
Final Loc. 12R-95  
Parcel