

APPLICATION

A 27886

SEWAGE DISPOSAL TESTING

P _____

STATE OF MARYLAND - DEPARTMENT OF HEALTH AND MENTAL HYGIENE

HOWARD COUNTY HEALTH DEPARTMENT
ENVIRONMENTAL HEALTH SERVICES
P. O. BOX 476, ELLICOTT CITY, MARYLAND 21043
TELEPHONE: 463-3000, EXT. 356

DISTRICT 3rd
DATE 4/17/78

BLDG. PERMIT SIGNED
AND RETURNED 4/13/84
Serial 59411 SFD

TO: THE COUNTY HEALTH OFFICER
ELLICOTT CITY, MARYLAND

I, HEREBY, APPLY FOR THE NECESSARY TEST IN ORDER TO CONSTRUCT (OR RECONSTRUCT) A SEWAGE DISPOSAL SYSTEM.

PROPERTY OWNER Robert Dorsey

ADDRESS 9926 Cypressmeade Drive, Ellicott City, Md. PHONE 465-5739

PROPERTY LOCATION:

SUBDIVISION Triadelphia Farms, Section II LOT NO. 1B

ROAD AND DESCRIPTION Triadelphia Road at Walt-Ann Drive

SIZE OF LOT ? TYPE BLDG. 3 or 4
NUMBER OF BEDROOMS

IF NOT SINGLE RESIDENCE DESCRIBE /s/ Robert L. Dorsey

THE SYSTEM INSTALLED UNDER THIS APPLICATION IS ACCEPTABLE ONLY UNTIL PUBLIC FACILITIES BECOME AVAILABLE.

SIGNATURE OF APPLICANT _____

APPROVED BY Raymond [Signature] FOR Trench or [Signature] DATE 3/18/78
(KIND OF SYSTEM)

REJECTED BY _____ FOR _____ DATE _____
(KIND OF SYSTEM)


HOLD PENDING FURTHER TESTS _____ DATE _____

REASONS FOR REJECTION OR HOLDING 5/9/79 HOLD FOR REVIEW

WATER MAY 79 FE SAID PERC OKR

THIS IS NOT A PERMIT

lot 1B

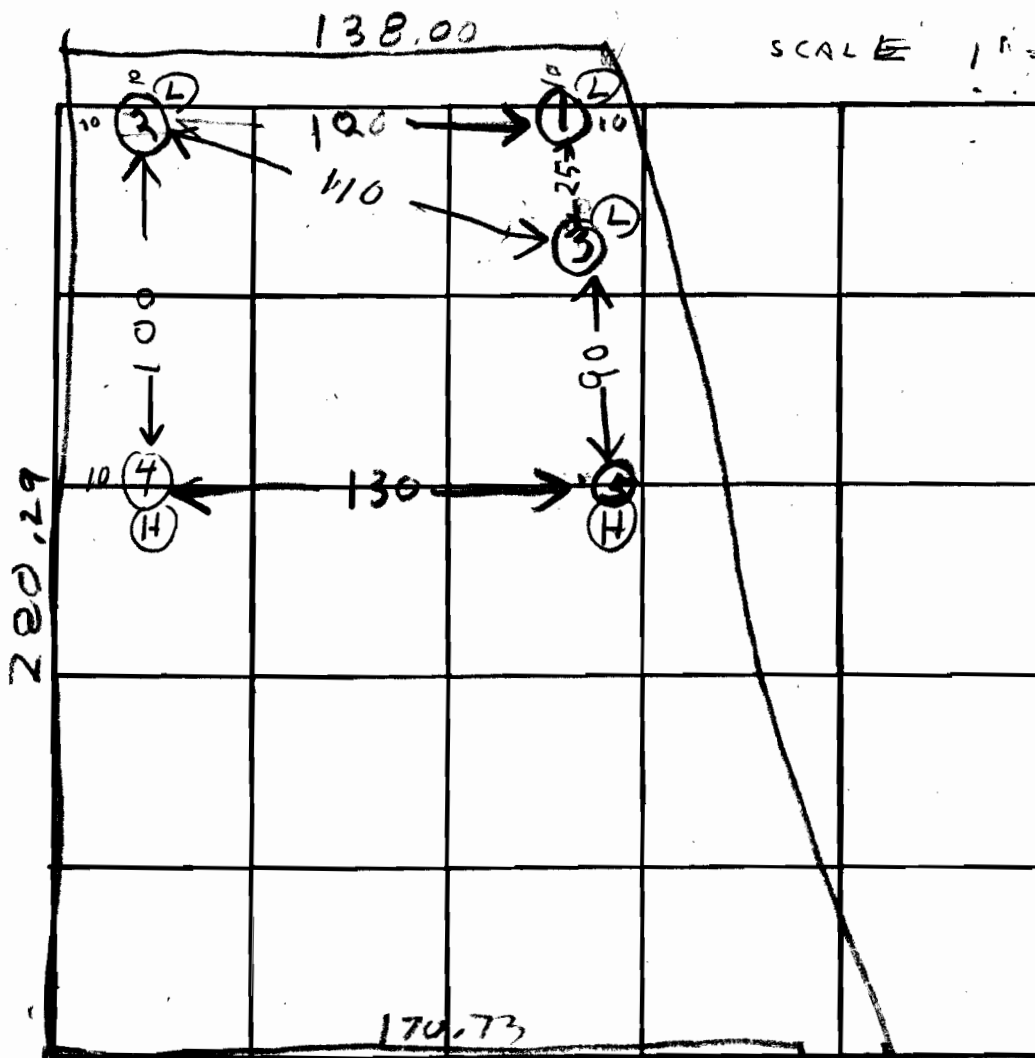

SCALE 1" = 50 FT

INDICATE NORTH. - NAME ADJOINING ROADWAY AS BASE LINE

SOIL TYPE
MID2

DATE	TEST NO.	DEPTH	PRE-WET		TEST - 1" DROP		TIME
			START	STOP	START	STOP	
5/9/78	1D	12	WATER		12 FT		
	1S	4	1159	1219	1219	1226	67
	1M	8	1159	1202	1202	1205	3
	2S	4 1/2	147	100	100	127	27
	2D	13	148	151	151	157	6
	3S	3 1/2	107	109	109	113	4
	3D	12 1/2	108	112	112	123	11
	4S	4	125	130	little more		
	4D	13	125	129	128	133	5
5/9/78	5V	12	TOP	3 FT	CLAY		
			BOT	9 FT	BANDY		DRY
	4M	5 1/2	137	138	138	139	11


REMARKS

TYPE OF SOIL

RHMB

ALL SAND

BODNER CO
HOWARD & DENNIS
FYOCK CO RICK

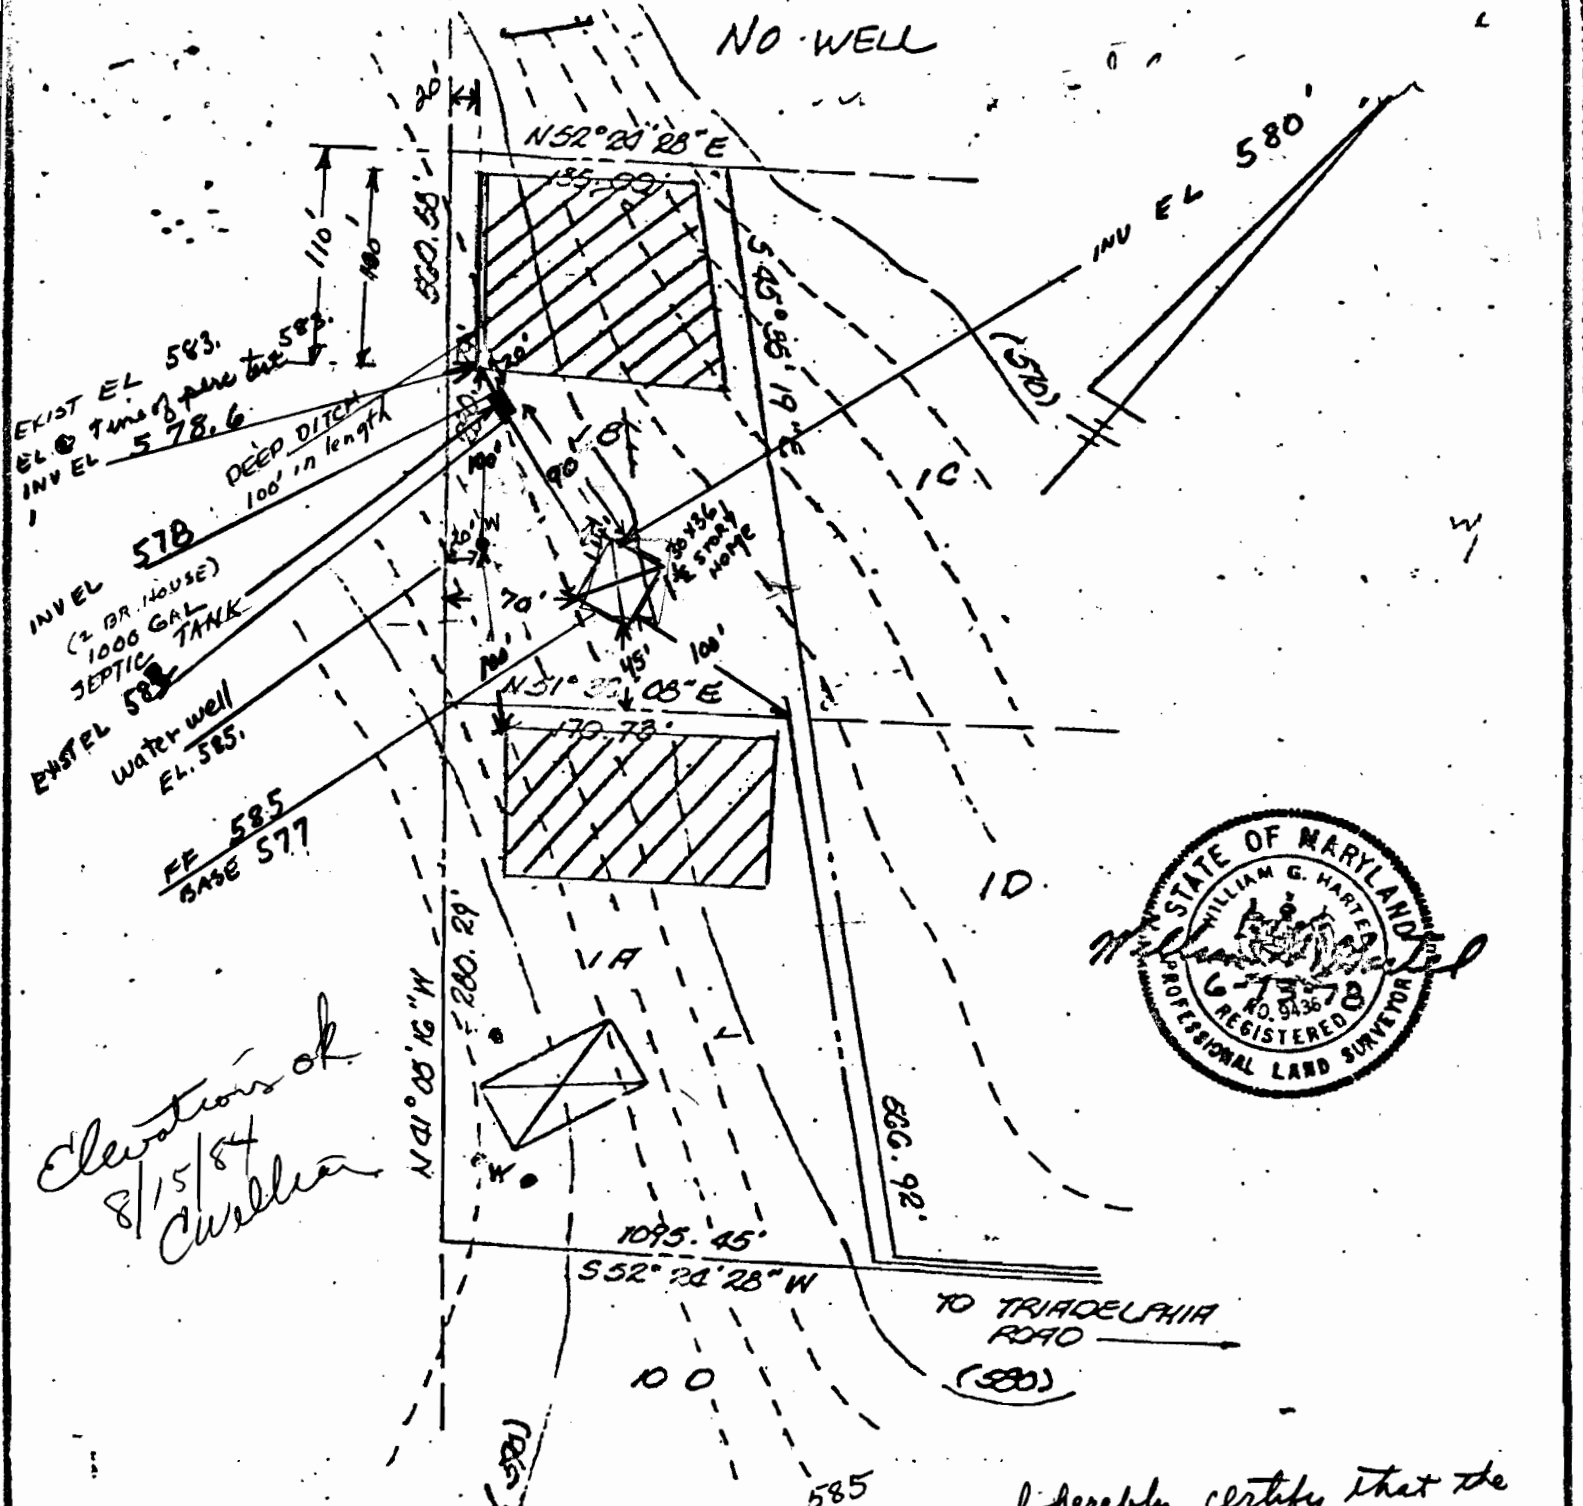

*Elevations of
8/15/84
Cushner*



THE LOTS SHOWN HEREON COMPLY WITH THE MINIMUM OWNERSHIP WIDTH AND LOT AREAS AS REQUIRED BY THE MARYLAND STATE DEPARTMENT OF HEALTH AND MENTAL HYGIENE.

*I hereby certify that the above measurements and elevations are actual and correct for this property.
No Basement plumbing
Robert L. Dorsey*

APPROVED: FOR PRIVATE WATER AND PRIVATE SEWERAGE SYSTEM

James Byler 9-11-78
HOWARD COUNTY HEALTH OFFICER DATE

NOTE: PERCOLATION TEST HOLES SHOWN HEREON HAVE BEEN FIELD LOCATED.

TITLE PERCOLATION TEST PLAT			
PROJECT TRIADOLPHIA FARMS II - LOTS 1A & 1B			
LOCATION THIRD ELECTION DISTRICT - HOWARD COUNTY, MARYLAND			
DATE: DEC. 1977	DESIGN BY: —	DRAWN BY: IMR	CHECKED BY: <i>[Signature]</i>
SCALE: 1" = 100'	JOB NO.: 7833	DRAWING NO.: 1	

boender associates

engineer
survey
planner