

# APPLICATION

A 27885

## SEWAGE DISPOSAL TESTING

P \_\_\_\_\_

STATE OF MARYLAND - DEPARTMENT OF HEALTH AND MENTAL HYGIENE

HOWARD COUNTY HEALTH DEPARTMENT  
ENVIRONMENTAL HEALTH SERVICES  
P. O. BOX 476, ELLICOTT CITY, MARYLAND 21043  
TELEPHONE: 465-8000, EXT. 356

DISTRICT 3 rd  
DATE 4/17/78

TO: THE COUNTY HEALTH OFFICER  
ELLICOTT CITY, MARYLAND

I, HEREBY, APPLY FOR THE NECESSARY TEST IN ORDER TO CONSTRUCT (OR RECONSTRUCT) A SEWAGE DISPOSAL SYSTEM.

PROPERTY OWNER Robert Dorsey

ADDRESS 9926 Cypressmeade Drive, Ellicott City, Md. PHONE 465-5739

PROPERTY LOCATION:

SUBDIVISION Triadelphia Farms, Section II LOT NO. 1A

ROAD AND DESCRIPTION 13330 Triadelphia Road at Walt-Ann Drive

SIZE OF LOT ? TYPE BLDG. 3 or 4  
NUMBER OF BEDROOMS \_\_\_\_\_

IF NOT SINGLE RESIDENCE DESCRIBE \_\_\_\_\_

THE SYSTEM INSTALLED UNDER THIS APPLICATION IS ACCEPTABLE ONLY UNTIL PUBLIC FACILITIES BECOME AVAILABLE.

SIGNATURE OF APPLICANT /s/ Robert L. Dorsey

APPROVED BY Raymond G. Hodge FOR Drywell or trench DATE 3/8/83  
(KIND OF SYSTEM)

REJECTED BY \_\_\_\_\_ FOR \_\_\_\_\_ DATE \_\_\_\_\_  
(KIND OF SYSTEM)

HOLD PENDING FURTHER TESTS \_\_\_\_\_ DATE \_\_\_\_\_


REASONS FOR REJECTION OR HOLDING 5/9/78 PERC OK HOLD FOR PLAT

3/8/83 - Spec written BLDG. PERMIT SIGNED AND RETURNED 4/19/84  
Serial # 57195

# THIS IS NOT A PERMIT

lot 1A

260-29

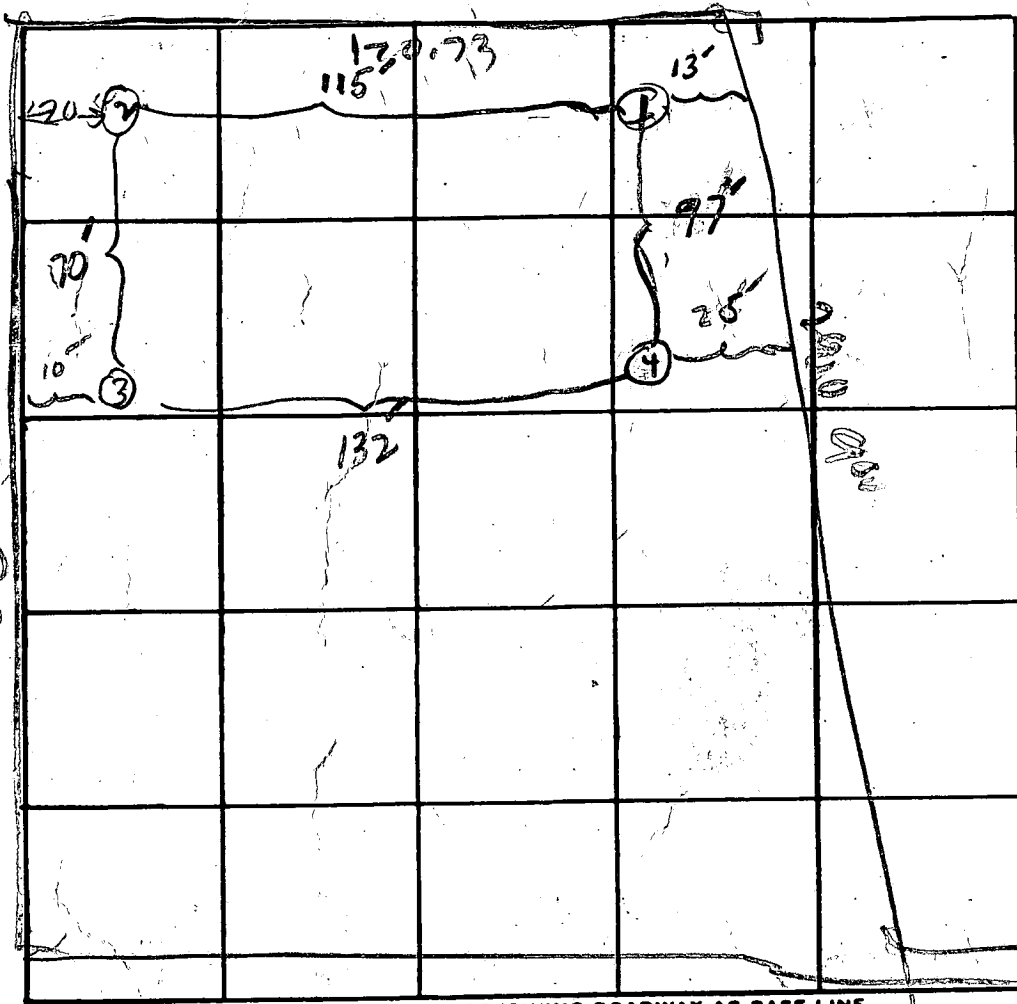

INDICATE NORTH. - NAME ADJOINING ROADWAY AS BASE LINE.

DATE	TEST NO.	DEPTH	PRE-WET		TEST - 1" DROP		TIME	
			START	STOP	START	STOP		
3/9	1	Sh	2 1/2 FE	1:45 PM	1:46	1:47	1:49	3 min
		Deep	12 1/2 FE	1:45	1:48	1:48	1:50	2 min
	2	clay to 3 FE	13 FE					
		3-13 FE						Fine material, Sand
Hi	3	S	3 FE	1:58	1:59	1:59	2:01	2 min
		D	12 FE	1:58	2:02	2:02	2:10	3 min
low	4	S	2 1/2 FE	2:22	2:24	2:24	2:26	2 min
		D	11 FE	2:22	2:27	2:27	2:41	14 min

REMARKS

TYPE OF SOIL R H ANB

DRUSIT FROCK CO