

P.C.P. 12/13/77
See books

12/23/77
12/27/77

PERMIT

P 27316
A 18306

SEWAGE DISPOSAL SYSTEM
MARYLAND STATE DEPARTMENT OF HEALTH

HOWARD COUNTY 12/29/77
a.m. please

ELLICOTT CITY
DISTRICT 3rd

12/30/77
hole also after noon
call back

DATE 12/13/77

INDEXED

Jim Brittingham IS PERMITTED TO INSTALL ALTER

ADDRESS Ellicott City, Md. PHONE _____

SUBDIVISION Eagles Loft ROAD Huntsmans Run LOT 17

PROPERTY OWNER Adelphia Developers

ADDRESS Balto., Md.

SPECIFICATIONS 4 bedrooms

SEPTIC TANK CAPACITY 1250 GALLONS

DRAIN FIELD _____ DEPTH _____ FEET, BOTTOM AREA _____ SQ. FT.

DEEP TRENCH _____ DEPTH _____ FEET, BOTTOM AREA _____ SQ. FT.

SEEPAGE PITS _____ ABSORBENT SIDE-WALL AREA 130 SQ. FT. per bedroom

INLET PIPE 3 FT. BELOW ORIGINAL GRADE. MAXIMUM DEPTH 10 FT. BELOW ORIGINAL GRADE

EFFECTIVE DEPTH AT _____ FT. BELOW ORIGINAL GRADE.

LOCATE DISPOSAL AREA 105 FT. FROM right LOT LINE AND 120 FT. FROM front LOT LINE AS SEEN WHEN

FACING LOT FROM front property line. (Perc hole 1 & 2)

PLANS APPROVED BY Charles B. Streaker DATE 2/11/76

COVER NO WORK UNTIL INSPECTED AND APPROVED.

NEITHER THE HOWARD COUNTY COUNCIL NOR THE HEALTH DEPARTMENT IS RESPONSIBLE FOR THE SUCCESSFUL OPERATION OF ANY SYSTEM.

NOTE: IF TRENCH IS USED CALL FOR INSPECTION BEFORE PLACING GRAVEL IN TRENCH.

NOTE: NO DRY WELL SHALL EXCEED 15 FOOT IN DIAMETER.

NOTE: ALL PIPE FROM HOUSE TO DISPOSAL AREA MUST BE CAST IRON.

PERMIT VOID AFTER THREE YEARS.


NOTE: INSTALL STAND PIPE ON SEPTIC TANK AND DRY WELL. STAND PIPES MUST BE 6 INCHES IN DIAMETER. CAST IRON, CONCRETE OR TERRA COTTA ACCEPTED.

***INSTALLER IS RESPONSIBLE FOR OBTAINING FINAL APPROVAL ON THIS PERMIT.**

A 18306

12/23/77
12/29/77

285 x 150

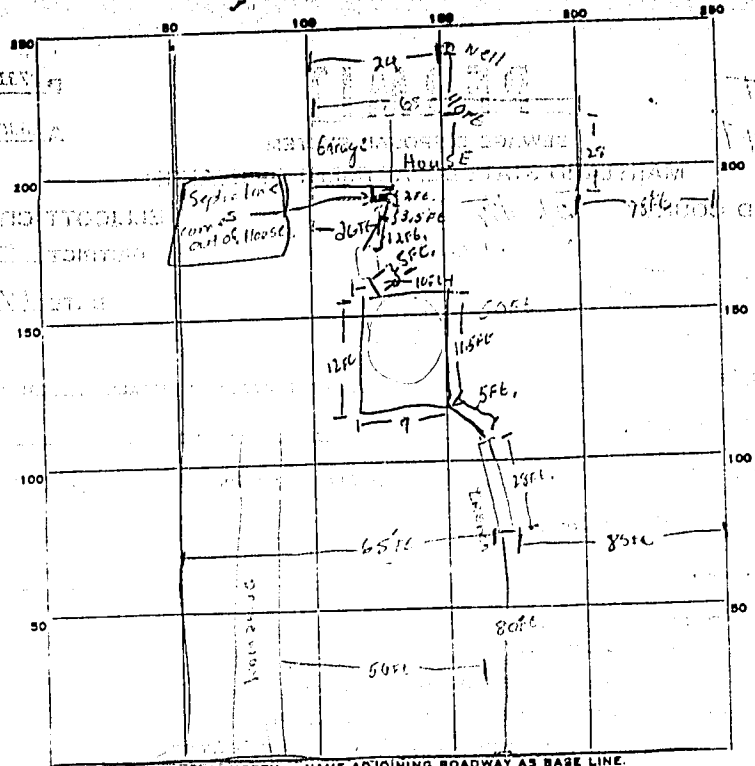

PERMIT CARD Holcom 12/20/77 Huntsmans Run 51T D. W.
 SEPTIC TANK, LEVEL OK CLEANOUTS ✓
 DISTRIBUTION BOX, LEVEL N/A

DITCH
 TRENCH DEPTH 10 1/2 FT. TRENCH WIDTH 2 FT.
 GRAVEL DEPTH 7 1/2 FT. TOTAL LENGTH 28 FT. 1 290
 NUMBER OF TRENCHES 1 TOTAL BOTTOM AREA _____
 SEEPAGE PITS, INSIDE PERIMETER 12.5 FT. DEPTH BELOW INLET 6.5 FT. 2 276
 ABSORBENT AREA 546 SQ. FT.

REMARKS 12/23/77 - TANK & DW NOT INSTALLED DITCH DUG
NOT FILLED. ADD STONE TO DITCH. INSTALL TANK & DW
IF SEWER LINES & CALL FOR INSPECTION R.H. CMB
12/29/77 partial waiting for gravel in Drywell and Trench. Need
5ft more + rep. should be 33 ft. OKAY to Back fill from house to 2 ft. of Drywell.
Call for re inspection, left info. with owner. M.B. 12/27/77 re inspection CMB
12/30/77 Finished per above. C. B. Bunker
 DATE SYSTEM APPROVED 12/30/77 INSPECTOR _____


A18306

HOUSE:
F.F. ELEV.: 540.2
BSMT. ELEV.: 531.5
INV. OUT.: 533.6

SEPTIC TANK:
EX. GRADE: 535.0
FIN. GRADE: 538.0
INV. OUT.: 533.0
INV. IN.: 533.3

DRY WELL:
EX. GRADE: 535.5
FIN. GRADE: 536.5
INV. IN.: 532.5

WELL:
EX. GRADE: 536.0
FIN. GRADE: 536.0

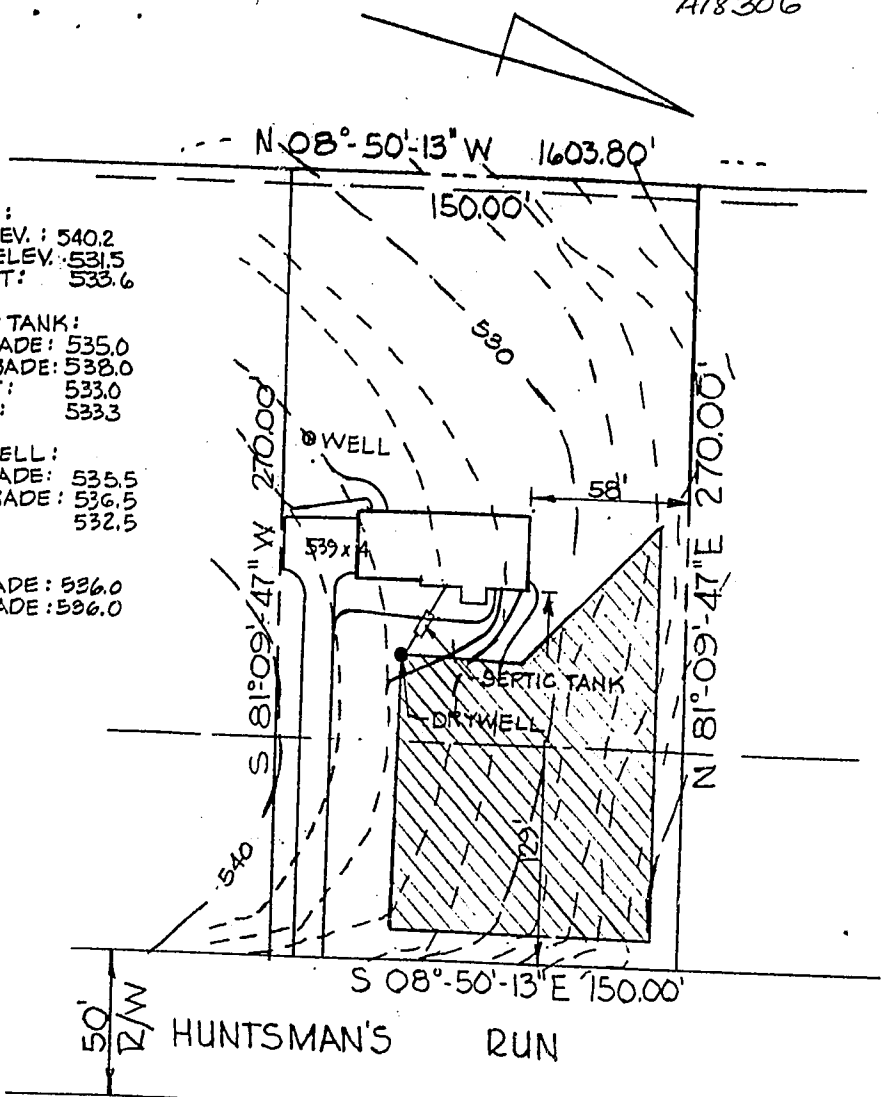

NOTE:
EXISTING TOPO: BY OWNERS.

8/5/77
Locations and
elevations approx OK
WJZ.
9/8/77
[Signature]