

Building Address 14624 CORYS CT
GLENELG MD. 21737

Suite/Apt. #: _____ SDP/WP/Petition #: _____

Census Tract _____ Subdivision EDGEWOOD FAIRM

Section _____ Area _____ Lot 17

Tax Map _____ Parcel A Grid _____

Zoning _____ Map Coordinates _____ Lot Size _____

Property Owner's Name BOB TWIGG
 Address 14624 CORYS CT
 City GLENELG State MD Zip Code 21737
 Home Phone _____ Work Phone 443 393 6205
 Applicant's Name & Mailing Address, (if other than stated herein): _____

Phone _____ Fax _____

Existing Use LAWN
 Proposed Use OUTDOOR BAR
 Estimated Construction Cost \$ _____
 Description of Work Construct Pavilion style outdoor Bar with half Bath 360 sq ft total

Occupant or Tenant _____

Contact Name _____
 Address _____
 City _____ State _____ Zip Code _____
 Phone _____ Fax _____

Contractor Company _____
 Contact Person _____
 Address _____
 City _____ State _____ Zip Code _____
 License No. _____
 Phone _____ Fax _____

Engineer or Architect Company _____
 Contact Person _____
 Address _____
 City _____ State _____ Zip Code _____
 Phone _____ Fax _____

BUILDING DESCRIPTION - COMMERCIAL

BUILDING DESCRIPTION - RESIDENTIAL

Building Characteristics	Utilities
Height: _____	Water Supply: _____ <input type="checkbox"/> Public <input type="checkbox"/> Private
No. of stories: _____	Sewage Disposal: _____ <input type="checkbox"/> Public <input type="checkbox"/> Private
Gross area, sq. ft. per floor: _____	Electric Yes <input type="checkbox"/> No <input type="checkbox"/> Gas Yes <input type="checkbox"/> No <input type="checkbox"/>
Use group: _____	Heating System: _____ Electric <input type="checkbox"/> Oil <input type="checkbox"/> Natural Gas <input type="checkbox"/> Propane Gas <input type="checkbox"/>
Construction type: _____ <input type="checkbox"/> Reinforced Concrete <input type="checkbox"/> Structural Steel <input type="checkbox"/> Masonry <input type="checkbox"/> Wood Frame <input type="checkbox"/> State Certified Modular	Sprinkler system: N/A <input type="checkbox"/> <input type="checkbox"/> Full <input type="checkbox"/> Partial <input type="checkbox"/> Other Suppression <input type="checkbox"/> # of Heads _____

Building Characteristics	Utilities
SF Dwelling <input type="checkbox"/> SF Townhouse <input type="checkbox"/> Depth _____ Width _____ 1 st floor: _____ 2 nd floor: _____ Basement: _____	Water Supply: _____ <input type="checkbox"/> Public <input type="checkbox"/> Private
Finished Basement <input type="checkbox"/> Unfinished Basement <input type="checkbox"/> Crawl space <input type="checkbox"/> Slab on Grade <input type="checkbox"/> No. of Bedrooms _____	Sewage Disposal: _____ <input type="checkbox"/> Public <input type="checkbox"/> Private
Multi-family dwellings: No. of efficiency units: _____ No. of 1 BR units: _____ No. of 2 BR units: _____ No. of 3 BR units: _____	Electric Yes <input type="checkbox"/> No <input type="checkbox"/> Gas Yes <input type="checkbox"/> No <input type="checkbox"/>
Other Structure: <u>OUTDOOR BUILDING</u> Dimensions: <u>20'9" x 14'9"</u> Footings: <u>monolithic</u> Roof: <u>truss</u>	Heating System: _____ Electric <input type="checkbox"/> Oil <input type="checkbox"/> Natural Gas <input type="checkbox"/> Propane Gas <input type="checkbox"/>
<input type="checkbox"/> State Certified Modular <input type="checkbox"/> Manufactured Home	Sprinkler system: N/A <input type="checkbox"/> <input type="checkbox"/> NFPA #13D <input type="checkbox"/> NFPA #13R <input type="checkbox"/> Other: _____

THE UNDERSIGNED HEREBY CERTIFIES AND AGREES AS FOLLOWS: (1) THAT HE/SHE IS AUTHORIZED TO MAKE THIS APPLICATION; (2) THAT THE INFORMATION IS CORRECT; (3) THAT HE/SHE WILL COMPLY WITH ALL REGULATIONS OF HOWARD COUNTY WHICH ARE APPLICABLE THERETO; (4) THAT HE/SHE WILL PERFORM NO WORK ON THE ABOVE REFERENCED PROPERTY NOT SPECIFICALLY DESCRIBED IN THIS APPLICATION; (5) THAT HE/SHE GRANTS COUNTY OFFICIALS THE RIGHT TO ENTER ONTO THIS PROPERTY FOR THE PURPOSE OF INSPECTING THE WORK PERMITTED AND POSTING NOTICES.

Applicant's Signature [Signature]
 Email Address btwigg@comcast.net
 Title/Company _____

Print Name Robert L Twigg
 Date 9/29/11

Checks payable to: **DIRECTOR OF FINANCE OF HOWARD COUNTY**
 PLEASE WRITE NEATLY AND LEGIBLY.

- FOR OFFICE USE ONLY -

AGENCY	DATE	SIGNATURE	APPROVAL
Land Development, DPZ			
State Highways			
Building Officials			
Dev. Engineering, DPZ			
Health	<u>9/29/2011</u>	<u>[Signature]</u>	
Fire Protection			

DPZ SETBACK INFORMATION

Front: _____
 Rear: _____
 Side: _____
 Side St.: _____

All minimum setbacks met?
 YES NO

PROPERTY ID #

Filing fee \$ _____
 Permit fee \$ _____
 Excise tax \$ _____
 Add'l per fee \$ _____
 TOTAL FEES \$ _____
 Sub-total paid \$ _____

Is Sediment Control approval required prior to issuance?
 YES NO

Is Entrance Permit Required?
 YES NO
 Historic District?
 YES NO
 Lot Coverage for New Town Zone _____
 SDP/Red-line approval date _____

Balance due \$ _____
 Check # _____
 Validation # _____


CONTINGENCY CONSTRUCTION START:
 ONE STOP SHOP:

Accepted by _____

The proposed revision to the layout of the septic tank at address: 14624 Corys Court Glenelg, Maryland 21737 is to provide ample space for planned outdoor living space as well as landscape plantings and a possible "future" pool installation on the property. The revision will allow for the planned spaces to be designed in a single area of the yard. This will leave the rest of the yard undisturbed.

Prepared by Craig D. Hood Signed [Signature]

Approved For Private Water and Private Sewerage Systems
 Health Officer, Howard County Health Department
[Signature]
 Date 9/6/2011

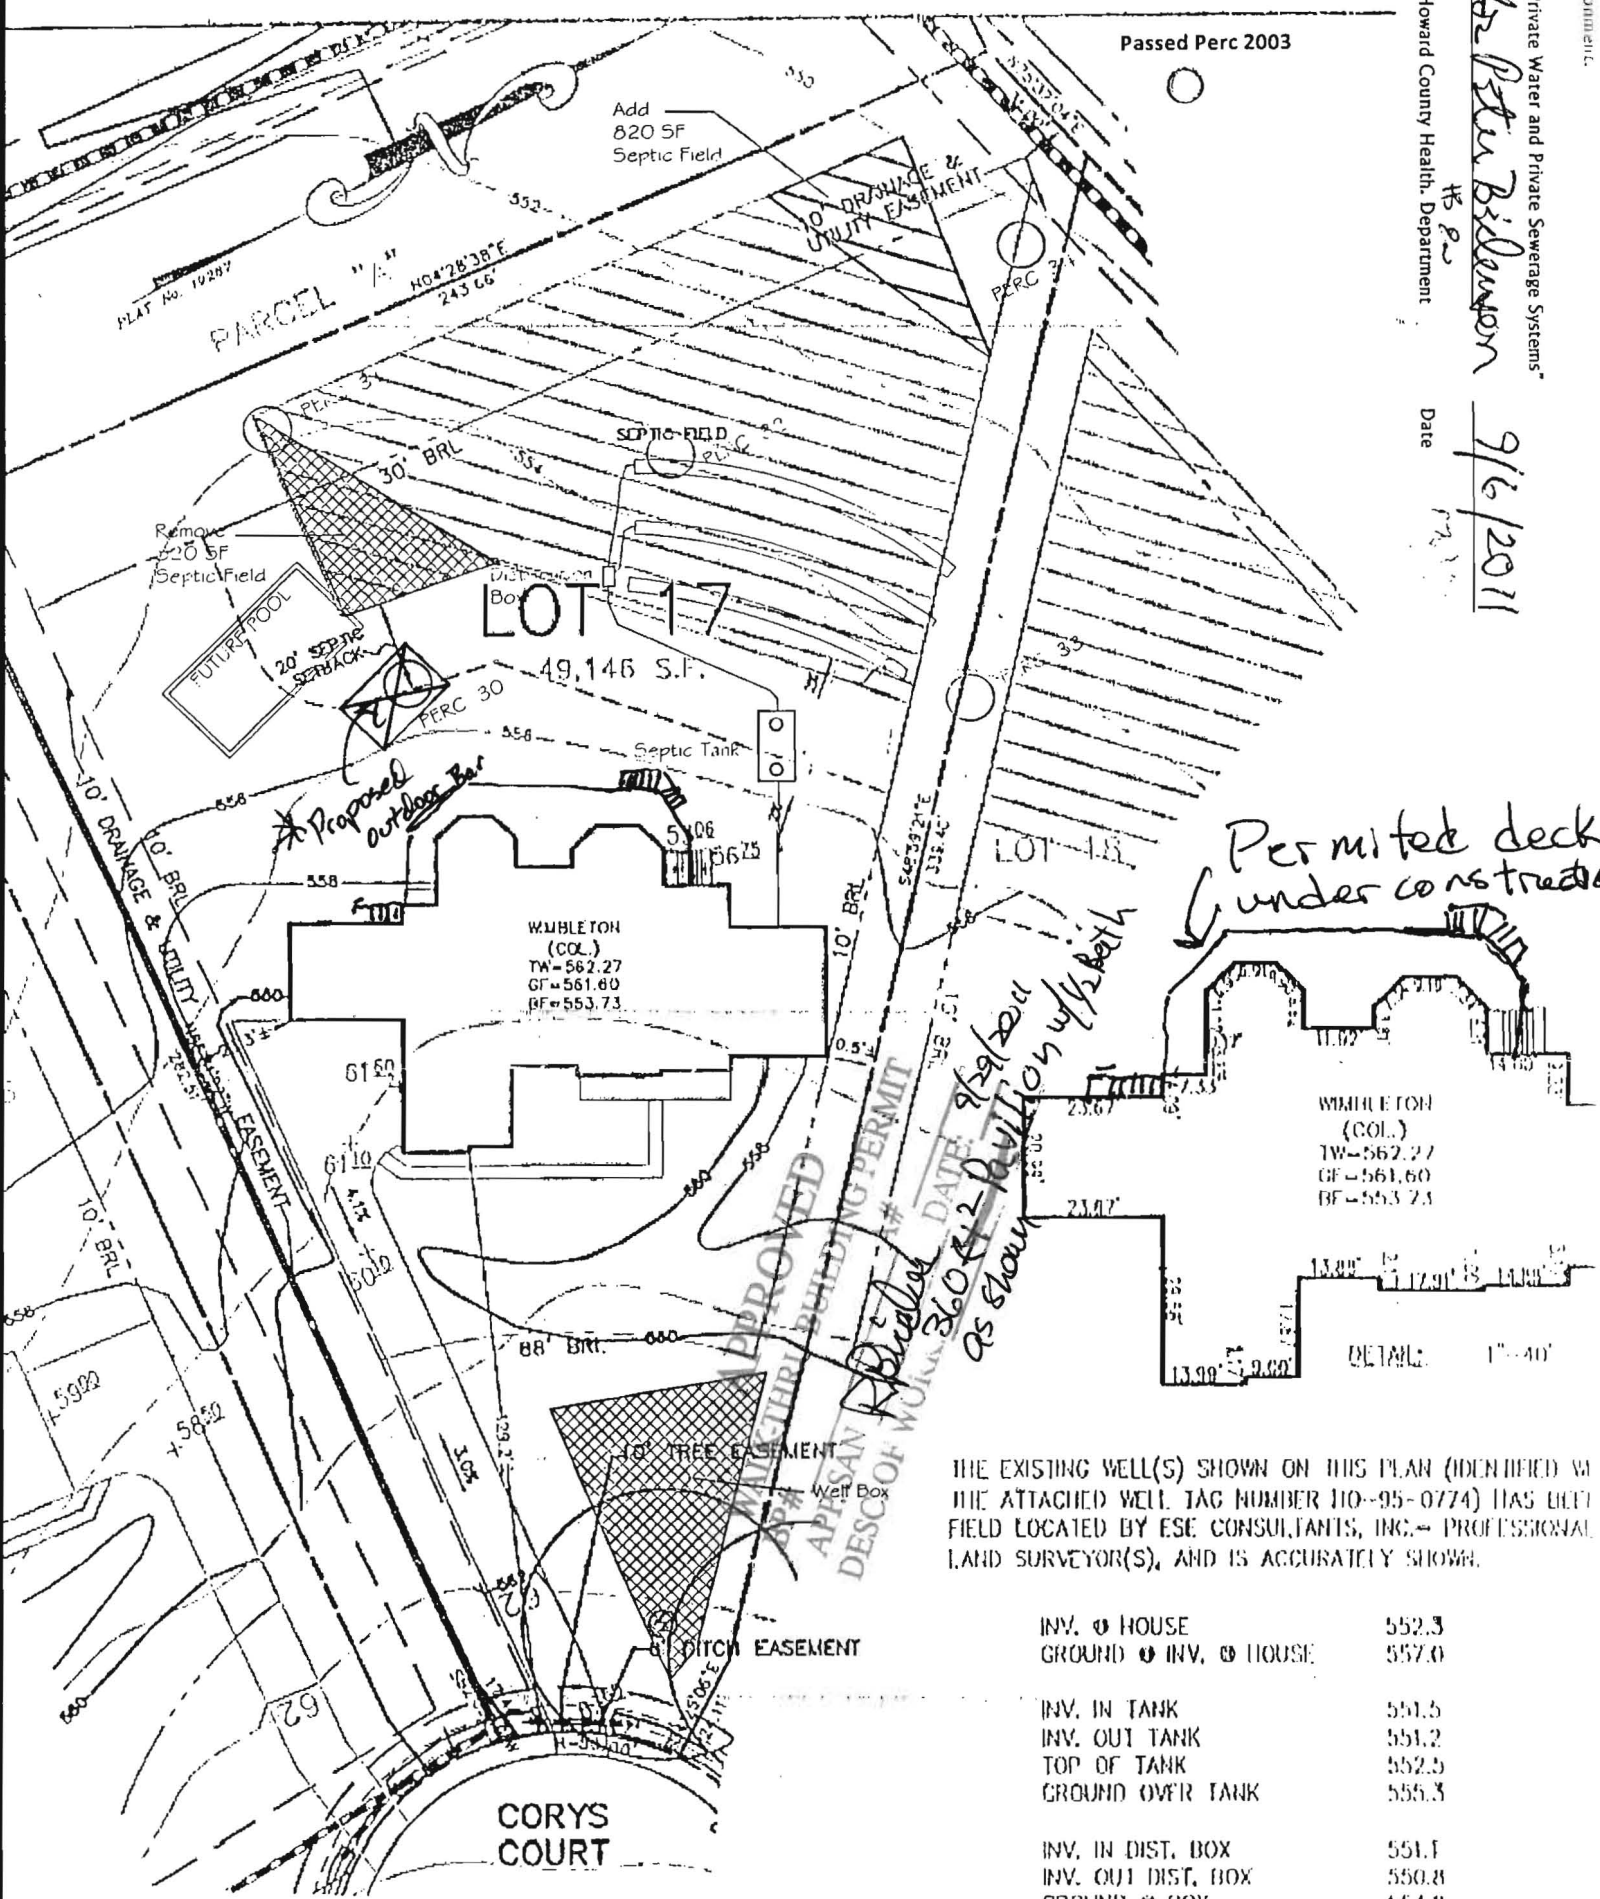

THE EXISTING WELL(S) SHOWN ON THIS PLAN (IDENTIFIED WITH THE ATTACHED WELL TAG NUMBER 110-95-0774) HAS BEEN FIELD LOCATED BY ESE CONSULTANTS, INC. - PROFESSIONAL LAND SURVEYOR(S), AND IS ACCURATELY SHOWN.


statement for lots created after March 1972:

"This area designates a private sewage disposal area of at least 10,000 sq. ft. as required by the Maryland Department of Environment for individual sewage disposal. Improvements of any nature in this area are restricted. This sewage disposal shall become null and void upon connection to a public sewerage system. The Health Officer shall have authority to grant adjustments to the private sewage disposal permit. Recordation of a revised sewage easement shall not be necessary."

SETBACKS (B.R.L.'s) SHOWN HEREON PER SITE
 PRESENT PLAN SETBACK DISTANCES SHOWN
 WITH "±" HAVE AN ACCURACY OF ±0.1' FOOT.

ADDRESS: 14624 CORYS COURT
 GLENELG, MD 21737

*Corys
apartment
MSB*

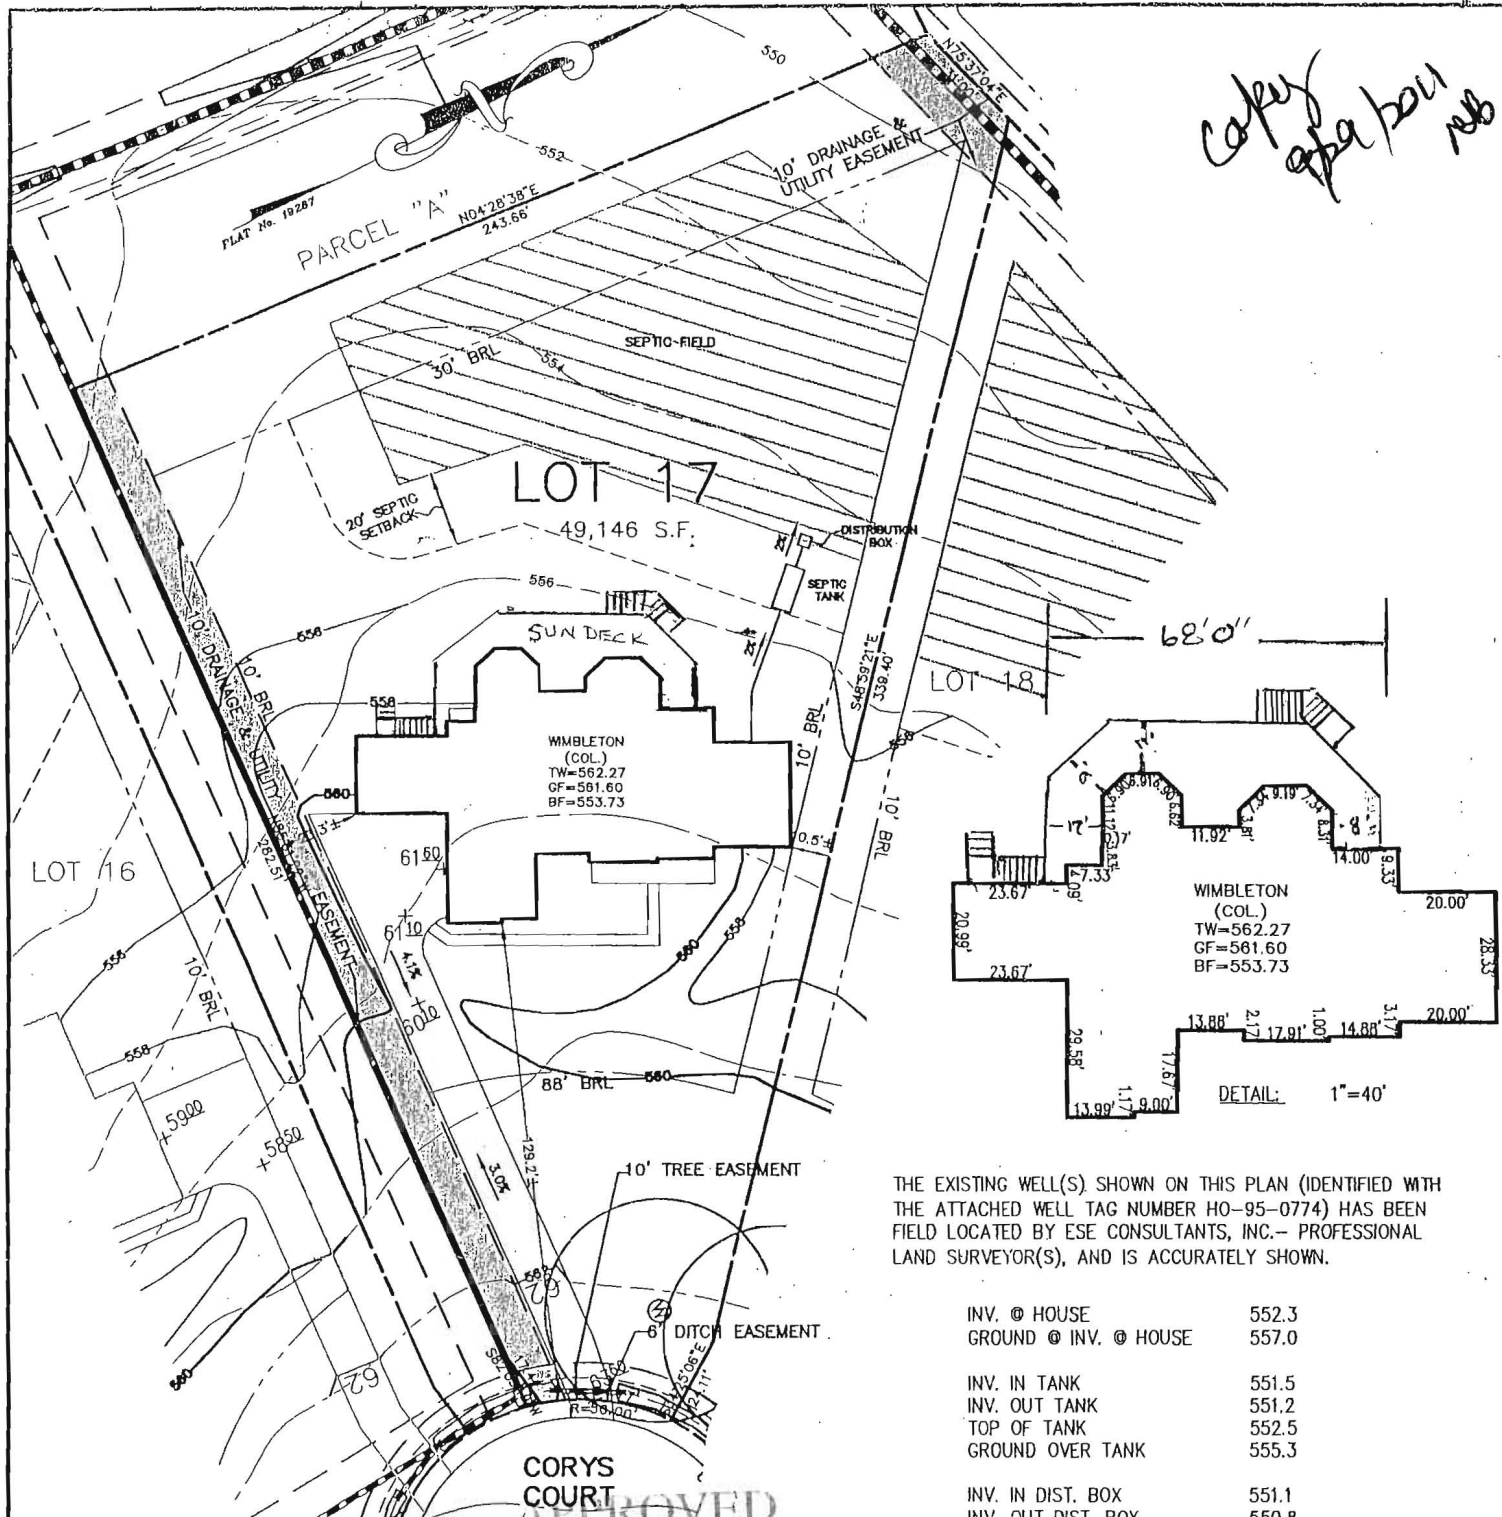

THE EXISTING WELL(S) SHOWN ON THIS PLAN (IDENTIFIED WITH THE ATTACHED WELL TAG NUMBER HO-95-0774) HAS BEEN FIELD LOCATED BY ESE CONSULTANTS, INC. - PROFESSIONAL LAND SURVEYOR(S), AND IS ACCURATELY SHOWN.

INV. @ HOUSE	552.3
GROUND @ INV. @ HOUSE	557.0
INV. IN TANK	551.5
INV. OUT TANK	551.2
TOP OF TANK	552.5
GROUND OVER TANK	555.3
INV. IN DIST. BOX	551.1
INV. OUT DIST. BOX	550.8
GROUND @ BOX	554.8

WALK-THRU BUILDING PERMIT

BP# _____ A# _____ WELL No. HO-95-0774
 APP. SAN *P. Baiker* DATE: 7/27/11
 DESC. OF WORK *1120sq ft Deck w/ steps as shown*
 ADDRESS: 14624 CORYS COURT
 GLENELG, MD 21737

BUILDING SETBACKS (B.R.L.'s) SHOWN HEREON PER SITE DEVELOPEMENT PLAN SETBACK DISTANCES SHOWN HEREON AS "±" HAVE AN ACCURACY OF ±0.1' FOOT.

- TYPE: WIMBLETON (COLONIAL)-
 DAYLIGHT BASEMENT
 EXPANDED FAMILY ROOM
 GRAND CONSERVATORY ELITE
 ADD'L 1' TO HEIGHT OF BASEMENT
 NAPLES SUNROOM
 DOUBLE-WIDE TAIL ON DRIVEWAY
 STONE TO GRADE 4 SIDES
 CUSTOM 4TH & 5TH CAR GARAGE


- OPTION No. 018
 OPTION No. 023
 OPTION No. 037
 OPTION No. 070
 OPTION No. 529
 OPTION No. 851
 OPTION No. XXX
 OPTION No. XXX

PLOT PLAN
 LOT #17
EDGEWOOD FARM
 LIBER 4174, FOLIO 0436
 PLAT No. 19267
 FOURTH ELECTION DISTRICT
 HOWARD COUNTY, MARYLAND

ESE Land Planning
 Engineering
 Land Surveying


ESE Consultants Inc.
 7164 Columbia Gateway Dr.
 Suite 203
 Columbia, MD 21046
 TEL: 410-872-9105
 FAX: 410-872-4870

DATE: 11/21/07 SCALE: 1"=50' FILE: LOT_17 11_15_07rev
 CHK'D: GVS/MJB JOB#: 1498 DRAWN: CRC

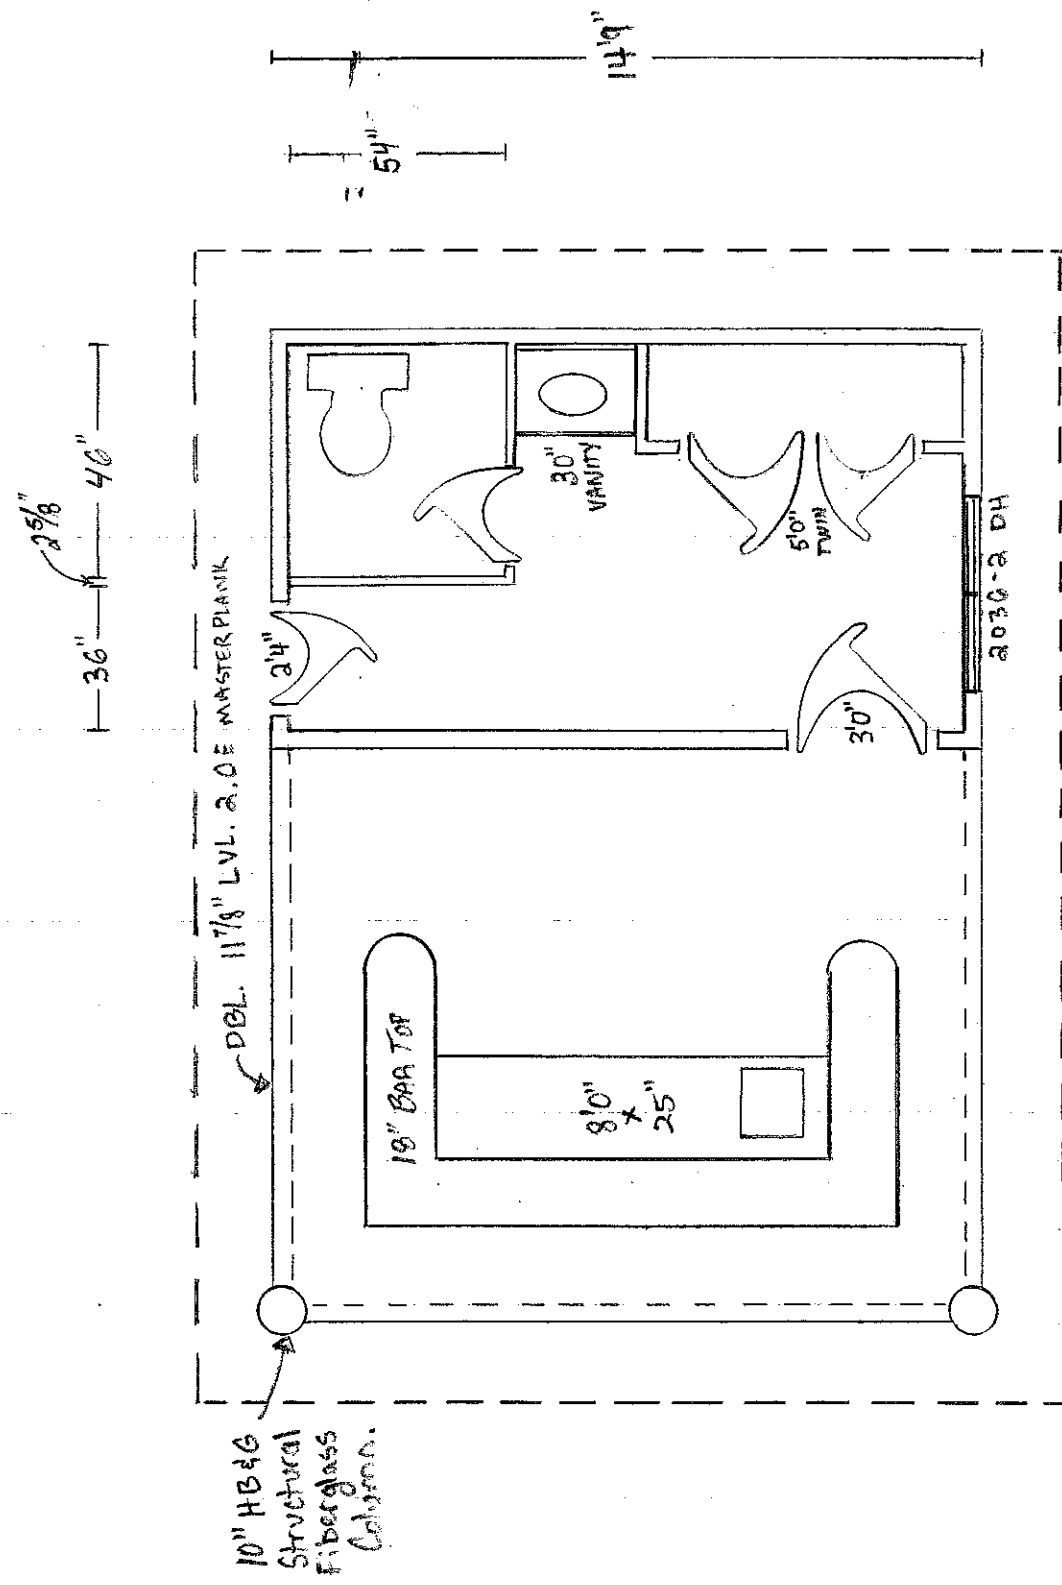

12'0" ——— 8'9" ———
 20'9" ———

PLAN VIEW 1/4" = 1'0"

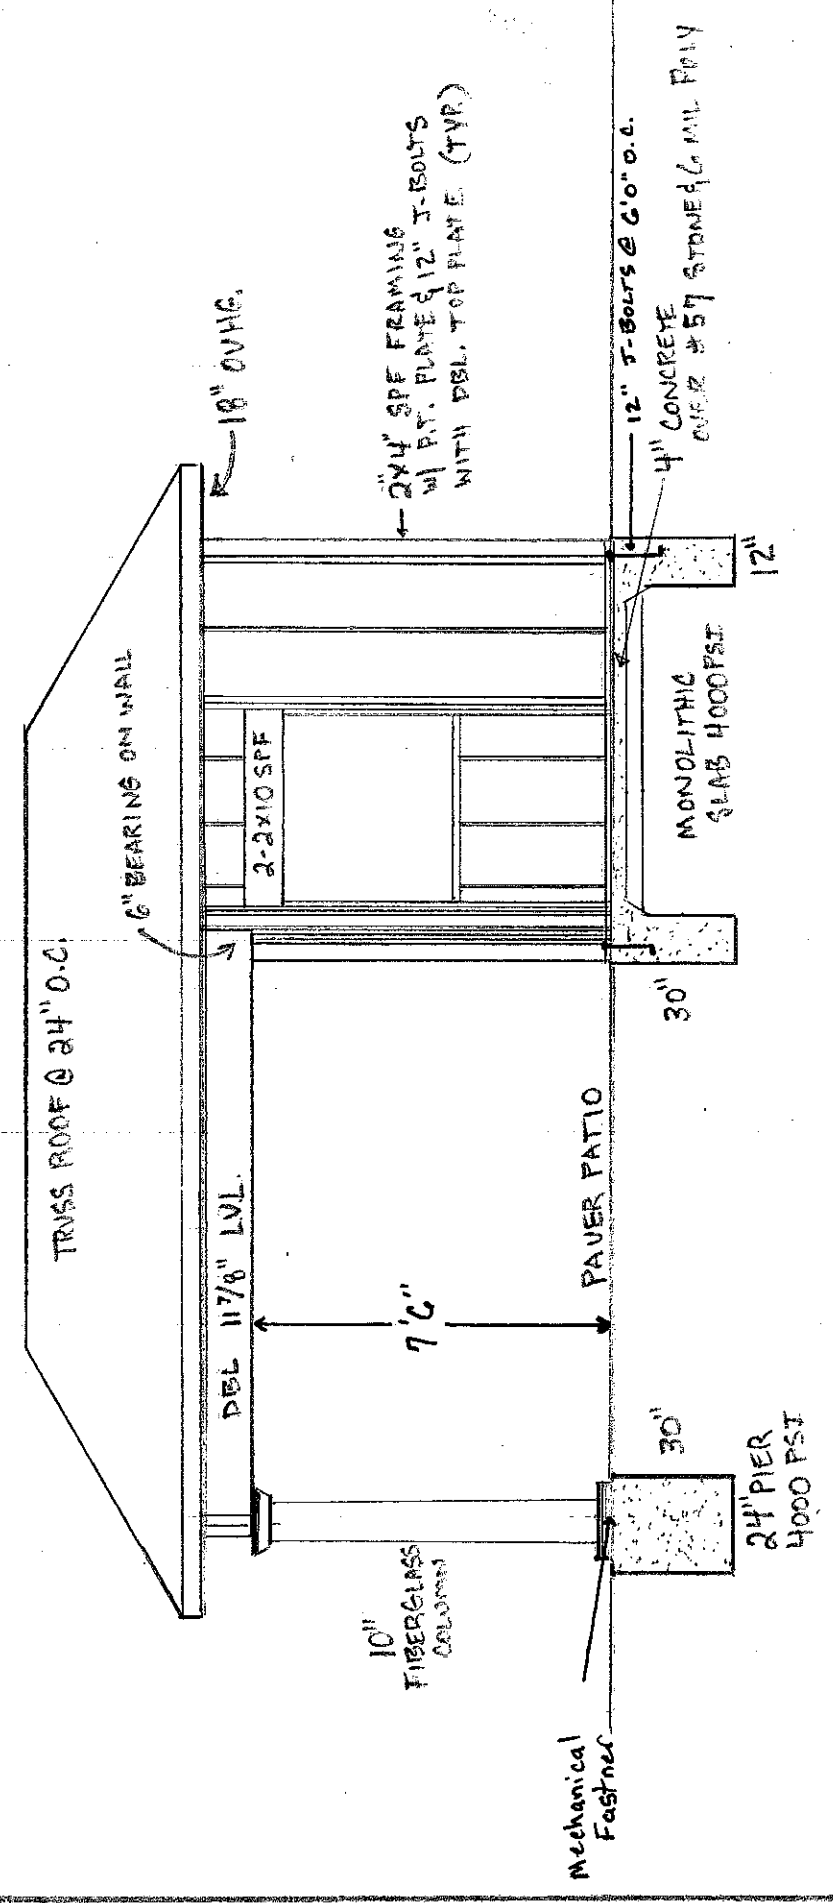

SECTION 1/4" = 1'0"

TWIGG RESIDENCE = OUTDOOR BAR AREA


EDGEWOOD FARM LOT #17
 14624 CORYS COURT
 GLENELG, MD. 21737

- GENERAL NOTES:**
- 1) DO NOT CUT OR MODIFY TRUSS
 - 2) TRIM OVERHANGS AS REQUIRED
BUT DO NOT CUT HEEL PLATE
 - 3) FIELD-FRAME HATCHED AREAS BY OTHERS
 - 4) TRUSSES SPACED 24" O/C U.N.O.

THIS LAYOUT IS INTENDED FOR THE PURPOSE OF TRUSS LOCATION AND PLACEMENT ONLY.
REFER TO BUILDING PLANS FOR ACTUAL BUILDING CONSTRUCTION.

ORDER#
111661

20-09-00

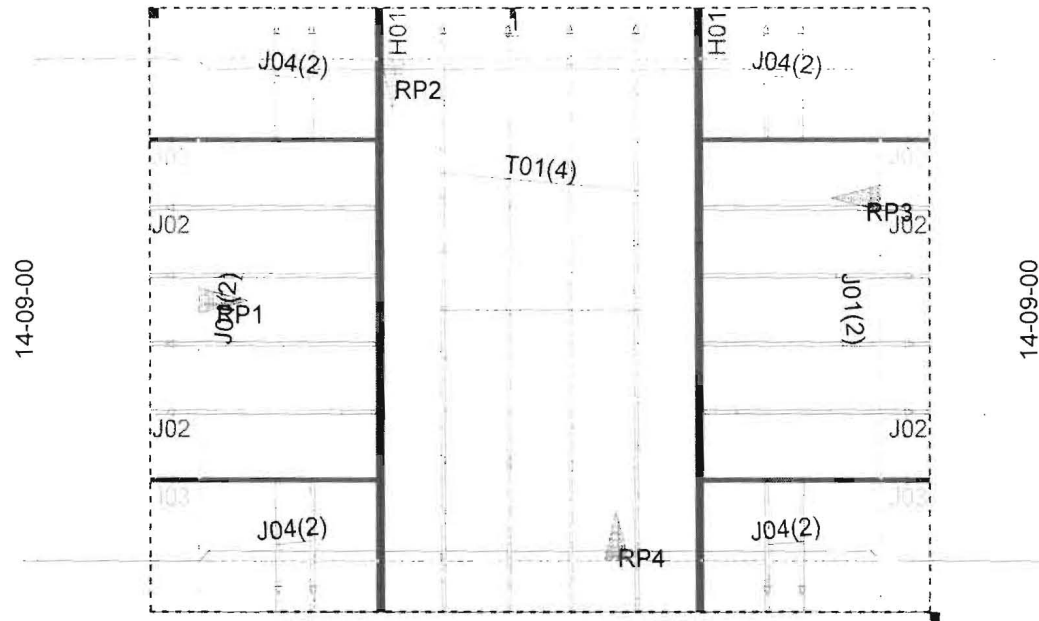

Comment 1
6/12 HIP EACH END
STD 12" OH TOP
CHORD

20-09-00

MATERIAL SCHEDULE		CAPAC.	ROOF LOADING	WIND 90 MPH
SYMBOL	QUAN.	DESCRIPTION	SYP—SPF	TC LIVE:30
	00	LUS26 LIGHT DUTY	1035—805	TC DEAD:10
●	00	HUS28 HEAVY DUTY	3700—2680	BC DEAD:10
▨	00	HUS28-2 2-PLY HEAVY DUTY	4465—3765	TOTAL LOAD:50
—	00	THJA26/HJC26 CORNER HANGER		
—	00	HUS26 MED DUTY	2950—2475	
▲	00	SUR/L26 45 CORNER HANGER	960—795	




JOB: TWIGG 14-9-0 X 20-9-0 HIPEE

MODEL: CUSTOM

SCALE: PO#: ORDER#111661

DRAWN BY: DATE: 9-29-11 REV.: SHIP:.

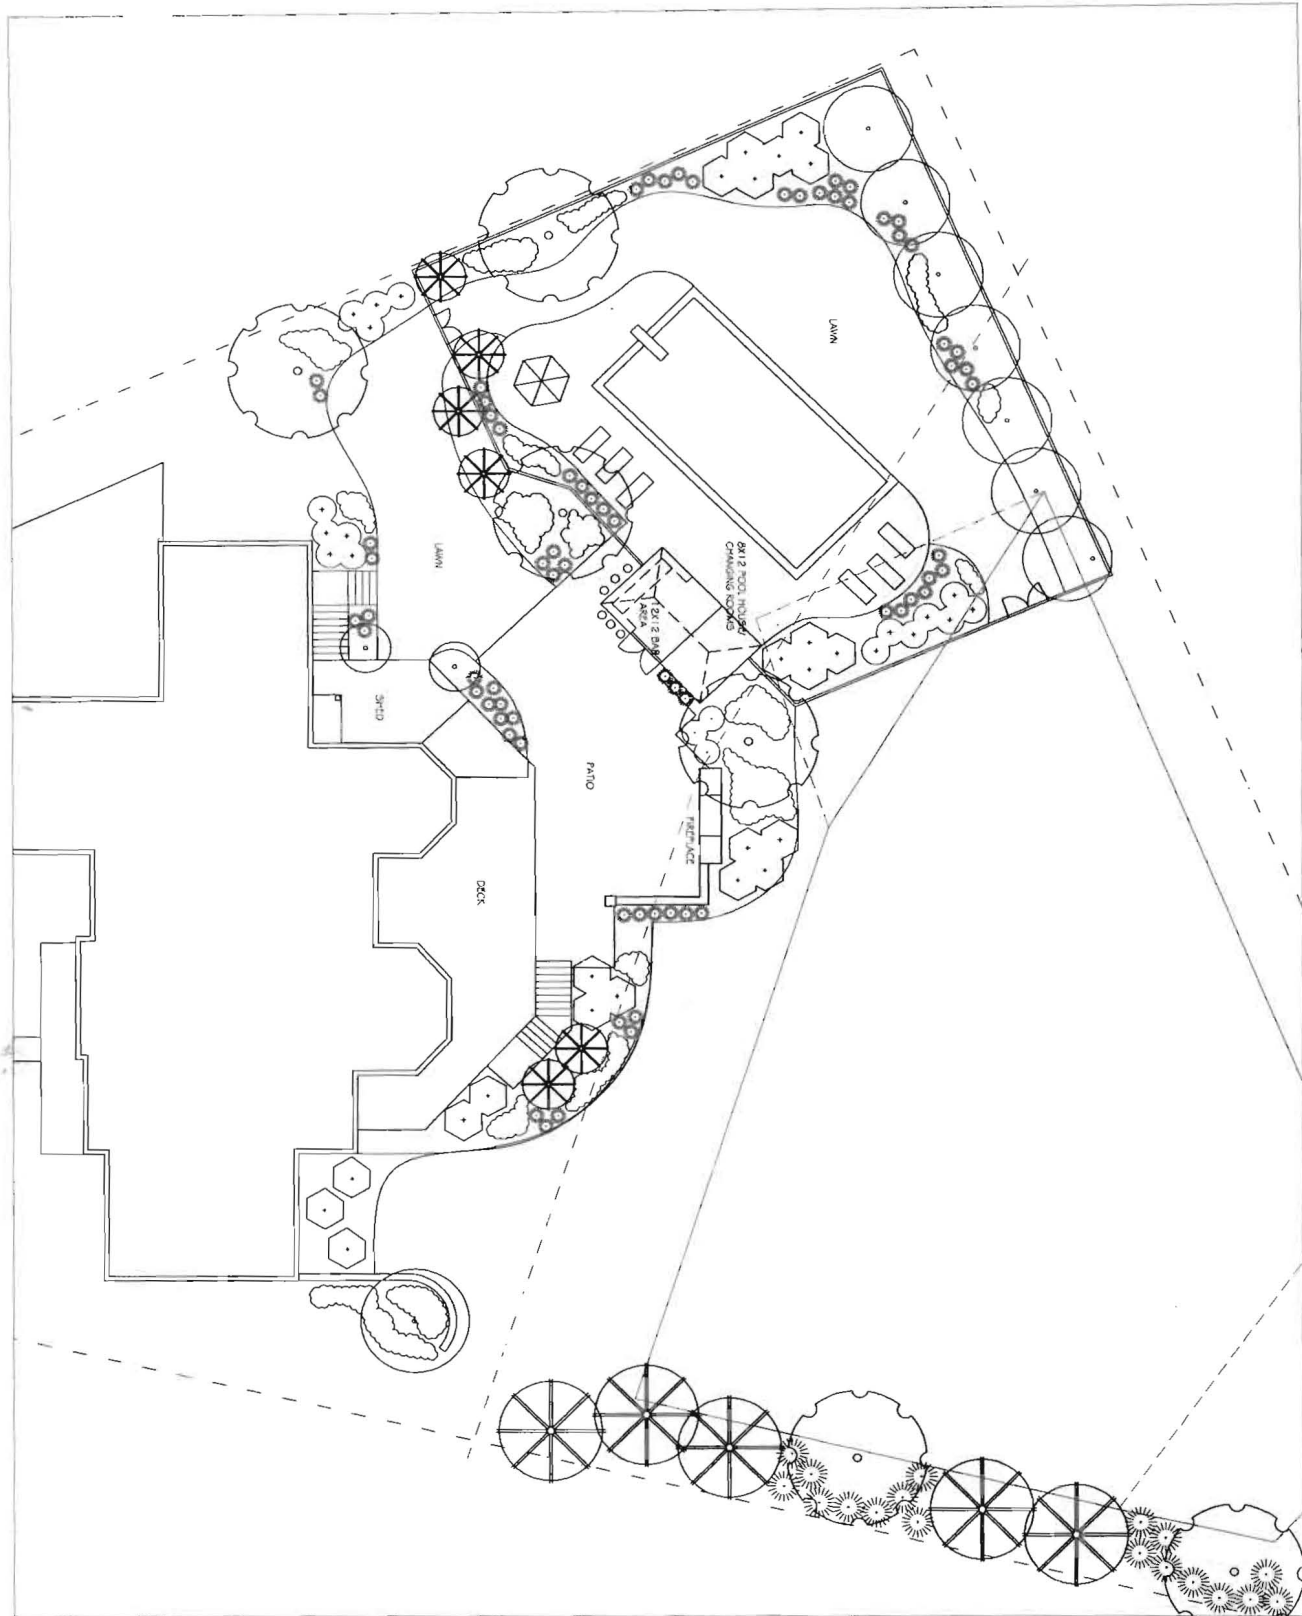

Scale: 1/4" = 1'

Date: 6/12/11

Drawn By:

Sheet No: 1 of 2

Revisions

No.	Description	Date



TWIGGY RESIDENCE

14624 Corys Court
Glenelg, MD 21737