

Fill out in triplicate.  
Make \$30.00, check payable:  
Howard County Health Dept. - Sanitation

# APPLICATION

A 23319

*Received*  
*11/16/77*  
*9:30 A.M.*  
*1:30 P.M.*

*4-13' tested*  
*1210,000 ft.*

SEWAGE DISPOSAL TESTING

P \_\_\_\_\_

STATE OF MARYLAND - DEPARTMENT OF HEALTH AND MENTAL HYGIENE

DISTRICT A<sup>th</sup>

HOWARD COUNTY HEALTH DEPARTMENT  
ENVIRONMENTAL HEALTH SERVICES  
P.O. BOX 476, ELLICOTT CITY, MARYLAND 21043  
TELEPHONE: 465-5000, EXT. 356

DATE 5/21/76

*60' trench 4-10' deep*

*existing house. To run on center - parallel to front*  
*of house from existing elec across lawn*

TO: THE COUNTY HEALTH OFFICER  
ELLICOTT CITY, MARYLAND

I, HEREBY, APPLY FOR THE NECESSARY TEST IN ORDER TO CONSTRUCT (OR RECONSTRUCT) A SEWAGE DISPOSAL SYSTEM.

PROPERTY OWNER  Judson D. Hulsey (CONTRACT PURCHASER)  
15922 A.E. Mullinix Rd.  
ADDRESS  Woodbine, MD 21797 PHONE 442-2742

PROPERTY LOCATION:

SUBDIVISION RIVER FARMS INC. SECTION I LOT NO.  13

ROAD AND DESCRIPTION directions travel south on Darcy Rd - right turn  
on A.E. Mullinix Rd - Take left past fifth house -

SIZE OF LOT  22,373 Acres TYPE BLDG. FRAME 5 Beds  
NUMBER OF BEDROOMS

(IF NOT SINGLE RESIDENCE DESCRIBE \_\_\_\_\_)

THE SYSTEM INSTALLED UNDER THIS APPLICATION IS ACCEPTABLE ONLY UNTIL PUBLIC FACILITIES BECOME AVAILABLE.

SIGNATURE OF APPLICANT  Judson D. Hulsey BLDG. PERMIT SIGNED AND RETURNED 11/21/77  
Series No. 57755


APPROVED BY [Signature] FOR Prop. DATE 11/16/77  
(KIND OF SYSTEM)

REJECTED BY \_\_\_\_\_ FOR \_\_\_\_\_ DATE \_\_\_\_\_  
(KIND OF SYSTEM)

HOLD PENDING FURTHER TESTS \_\_\_\_\_ DATE \_\_\_\_\_

REASONS FOR REJECTION OR HOLDING \_\_\_\_\_

# THIS IS NOT A PERMIT

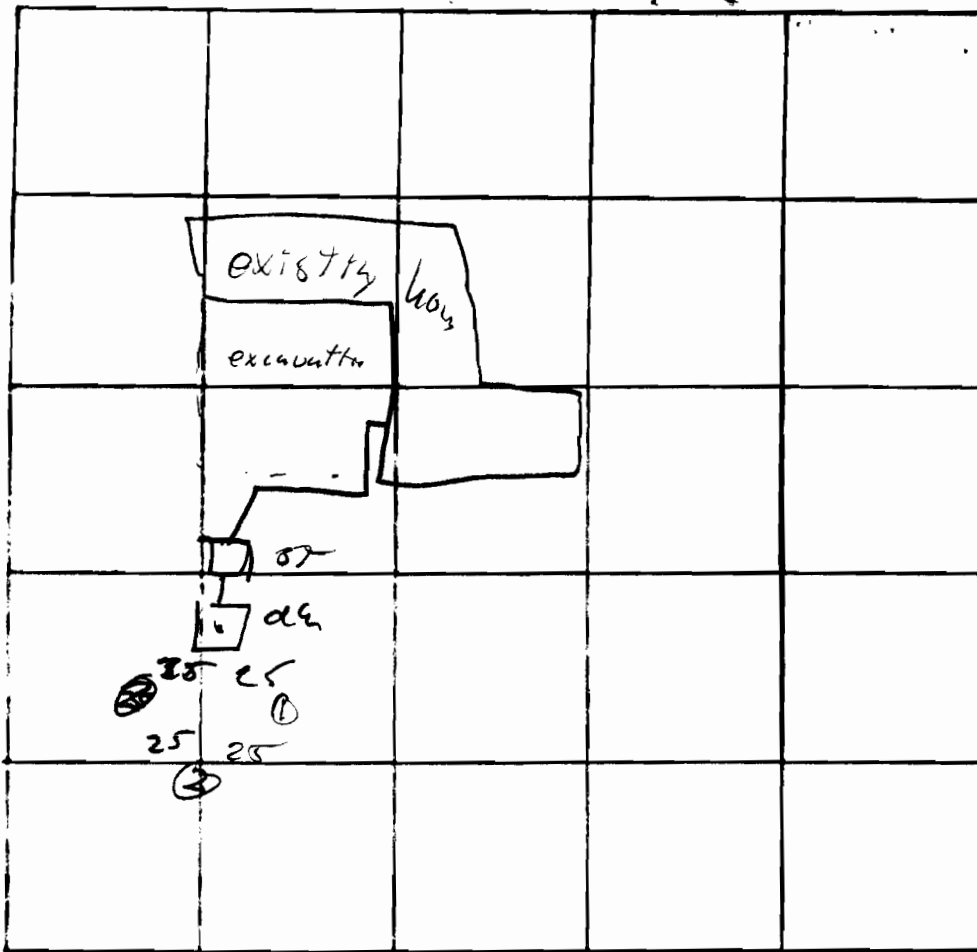

INDICATE NORTH - NAME ADJOINING ROADWAY AS BASE LINE.

DATE	TEST NO.	DEPTH	PRE-WET		TEST - 1" DROP		TIME
			START	STOP	START	STOP	
11/5/44	1, 2, 3	4-12'	all 04				
		Sandy loam	some staly				
		all vertical holes.					

REMARKS \_\_\_\_\_

TYPE OF SOIL Sandy loam.

TESTED BY A. J. M.

ALSO PRESENT: Richard Barry

# APPLICATION

A 23319

## SEWAGE DISPOSAL TESTING

P \_\_\_\_\_

STATE OF MARYLAND - DEPARTMENT OF HEALTH AND MENTAL HYGIENE

HOWARD COUNTY HEALTH DEPARTMENT  
ENVIRONMENTAL HEALTH SERVICES  
P. O. BOX 476, ELLICOTT CITY, MARYLAND 21043  
TELEPHONE: 465-5000, EXT. 356

DISTRICT 4<sup>th</sup>

DATE 5/21/76

TO: THE COUNTY HEALTH OFFICER  
ELLICOTT CITY, MARYLAND

I, HEREBY, APPLY FOR THE NECESSARY TEST IN ORDER TO CONSTRUCT (OR RECONSTRUCT) A SEWAGE DISPOSAL SYSTEM.

PROPERTY OWNER Judson D. Hulsey (CONTRACT PURCHASER)  
15922 A. E. Mullinix Rd.  
ADDRESS Woodbine, MD 21797 PHONE \_\_\_\_\_

PROPERTY LOCATION:

SUBDIVISION Rivers Farms Inc. Section I LOT NO. 13

ROAD AND DESCRIPTION Traveling South on Daisy Rd - Right turn  
on A. E. MULLINIX Rd - Take dirt road <sup>to left</sup> Past 5<sup>th</sup> house

SIZE OF LOT 22.373 Acres TYPE BLDG. Frame 5 Bed  
NUMBER OF BEDROOMS

NOT SINGLE RESIDENCE DESCRIBE \_\_\_\_\_

THE SYSTEM INSTALLED UNDER THIS APPLICATION IS ACCEPTABLE ONLY UNTIL PUBLIC FACILITIES BECOME AVAILABLE.

SIGNATURE OF APPLICANT Judson D. Hulsey

APPROVED BY \_\_\_\_\_ FOR \_\_\_\_\_ DATE \_\_\_\_\_  
(KIND OF SYSTEM)

REJECTED BY \_\_\_\_\_ FOR \_\_\_\_\_ DATE \_\_\_\_\_  
(KIND OF SYSTEM)

HOLD PENDING FURTHER TESTS \_\_\_\_\_ DATE \_\_\_\_\_

REASONS FOR REJECTION OR HOLDING \_\_\_\_\_

# THIS IS NOT A PERMIT

Permit # 33755

H.R. Barron

15 895 Mullin's Rd. Rt. 2 Woodlawn

10-5-77 no answer

10-11-77 no answer 12:30

addition \$12,000

40 x 36

Family, Bed, Bath,  
Kit & Porch.


Send note to contact H.P. unable to approve until perc.

conducted. (~~fee 100.00 applic. evols~~) base appl. on record  
LH

"Mailed notification to Mrs Barron this  
date / hr

6/77 spoke to Mr B re needing perc. L

8/9-10<sup>1/2</sup>

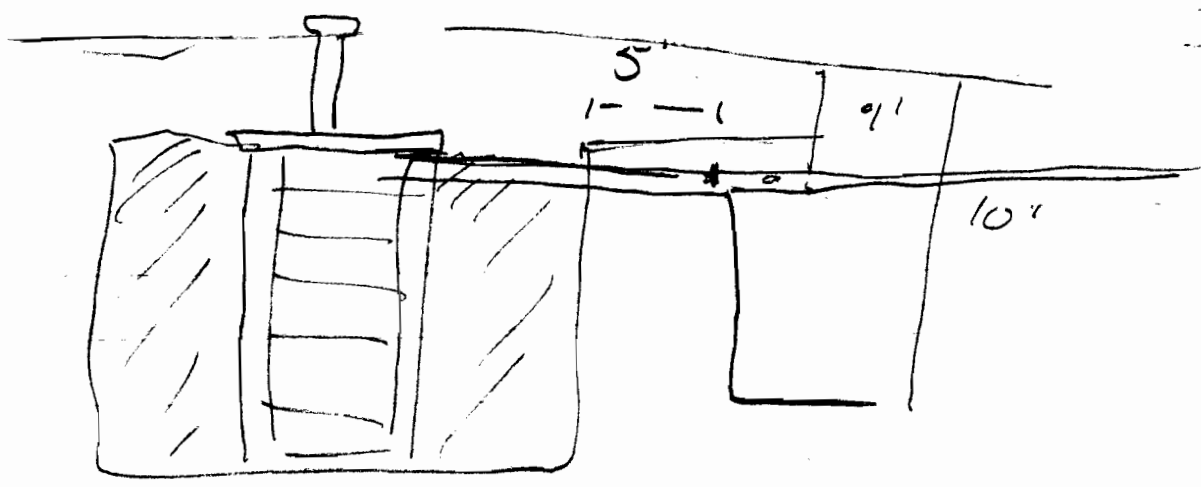

Applied for perc test 10/31/77

~~Perc date 11/10/77 9:30 a.m.~~

serial no: 33755

11/15/77

1:30 P.M.

Done