

1" = 30'

Lot # 1, BRAEBURN

B.P. # 64895

BRAEBURN

N 61°-16'-10"W

202.35'

Dry Well

TRENCH

Well site at least 270ft from Dry Well

SEPTIC TANK

Sewer pipe outlet No lower than 400 1/2 ft

EXISTING WELL

Proposed House Upper Level 406 Lower Level 397

LOT 1 BRAEBURN

SEPTIC SYSTEM - ELEVATIONS

400.5	OUTLET FROM HOUSE - 400.5'
400.35	INLET TO TANK 400.0'
400.10	OUTLET FROM TANK 399.6'
399.7	INLET TO DRYWELL 399.0'

Pond water surface 388.2

Septic clear & sealin sk pipe / 7.7.6-7-85

? reduce depth 8' not?

Draw

Well?

more tank closer to house to 10' min


20' Side Yard B.R.L.

Wood Shed

Cherry

6" P.A.E.

6" w. flow

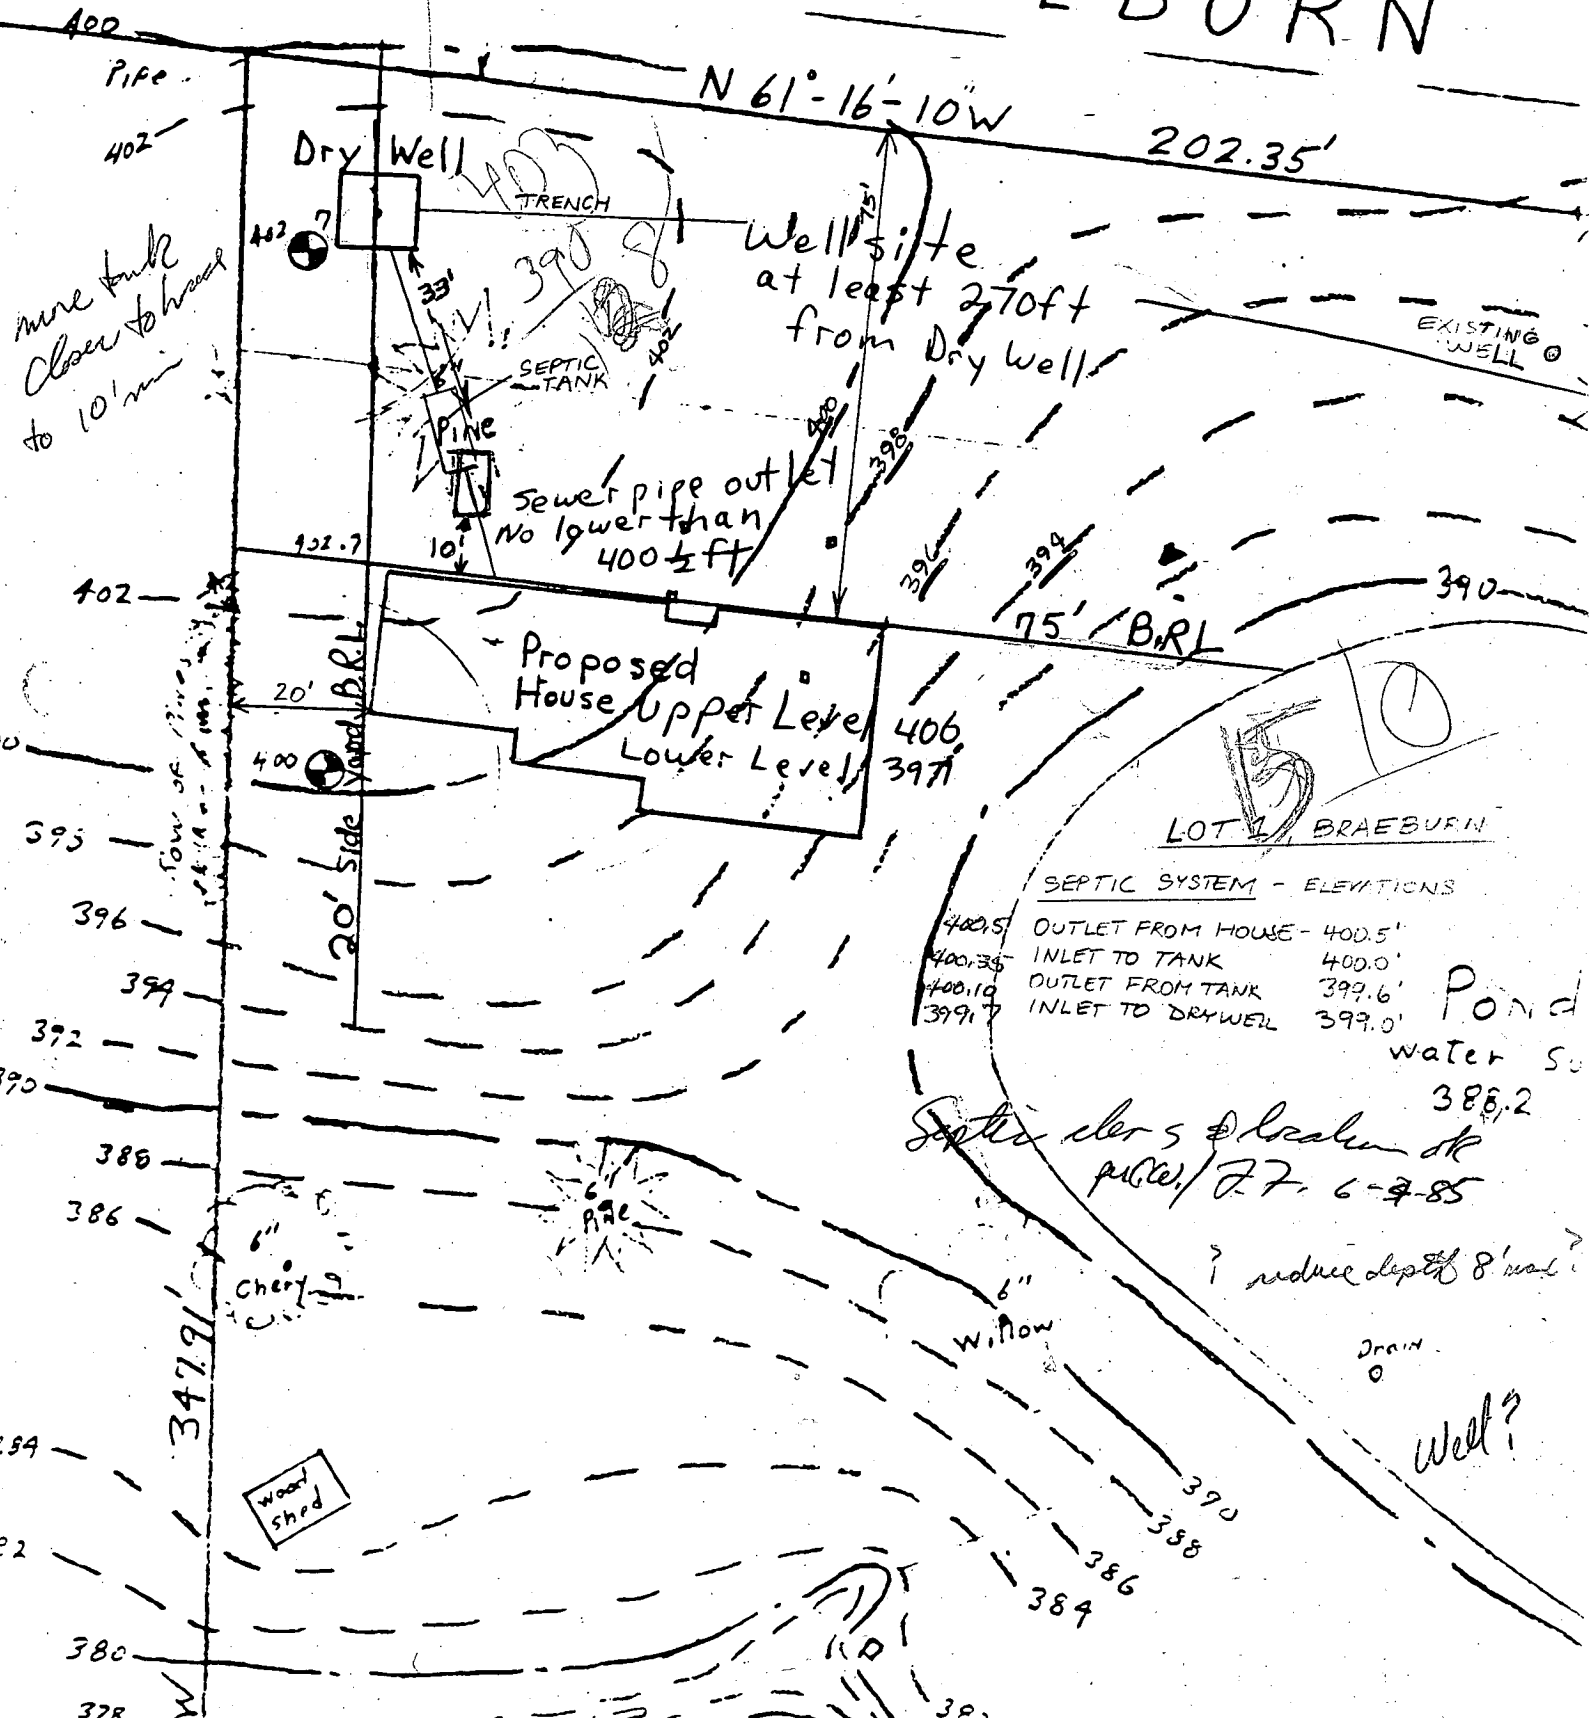

of some
~~CONFIDENTIAL~~
4/5
29

RECEIVED
HARRIS COUNTY
HEALTH DEPT.
MAY 14 8 54 AM '84
DIVISION OF
ENVIRONMENTAL
HEALTH