

B 1 9837 SEQUENCE NO. (OEP USE ONLY)

STATE OF MARYLAND PERMIT TO DRILL WELL

OEP PERMIT NUMBER

HO-73-4338

(THIS NUMBER IS TO BE PUNCHED IN COLS. 2 ON ALL CARDS)

please print or type

fill in this form completely

Date Received 120382 (OEP Use Only) OWNER INFORMATION LUBER CATHERINE 4851 MORRIS RD BALTIMORE MD 21227

LOCATION OF WELL COUNTY HOWARD SUBDIVISION Taxmap 31, par. 143 SECTION 23 LOT 48 NEAREST TOWN ELKRIDGE MILES FROM TOWN 3

DRILLER INFORMATION Sperry B. Cochran 5 EDGAR HARRIS CORP 2047 FALLS RD COCKEYSVILLE 21030

DIRECTION OF WELL FROM TOWN (CIRCLE BOX) ON WHICH SIDE OF ROAD (CIRCLE APPROPRIATE BOX) DISTANCE FROM ROAD 100 FEET

WELL INFORMATION APPROX. PUMPING RATE (GAL. PER MIN.) 5 AVERAGE DAILY QUANTITY NEEDED (GAL. PER DAY) 750


USE FOR WATER (CIRCLE APPROPRIATE BOX) HOME (SINGLE OR DOUBLE HOUSEHOLD UNIT ONLY) FARMING (LIVESTOCK WATERING & AGRICULTURAL IRRIGATION) INDUSTRIAL, COMMERCIAL, STATE AND FEDERAL GOV. OTHER (REQUIRES APPROPRIATION PERMIT) PUBLIC OR PRIVATE WATER COMPANY (REQUIRES APPROPRIATION PERMIT AND STATE HEALTH DEPARTMENT APPROVAL) TEST, OBSERVATION, MONITORING (MAY REQUIRE APPROPRIATION PERMIT)

SOURCES OF DRILLING WATER 1. 2. 3. WRITE THE BOX NUMBER FROM THE MAP HERE

APPROXIMATE DEPTH OF WELL 200 FEET APPROXIMATE DIAMETER OF WELL 6 INCH NEAREST INCH

METHOD OF DRILLING (circle one) BORED (OR AUGERED) JETTED JETTED & DRIVEN AIR ROTARY AIR PERCUSSION ROTARY (HYDRAULIC ROTARY) CABLE REVERSE ROTARY DRIVE POINT other

REPLACEMENT OR DEEPEMED WELLS (CIRCLE APPROPRIATE BOX) THIS WELL WILL NOT REPLACE AN EXISTING WELL THIS WELL WILL REPLACE A WELL THAT WILL BE ABANDONED AND SEALED THIS WELL WILL REPLACE A WELL THAT WILL BE USED AS A STANDBY THIS WELL WILL DEEPEM AN EXISTING WELL PERMIT NUMBER OF WELL TO BE REPLACED OR DEEPEMED (IF AVAILABLE) 41

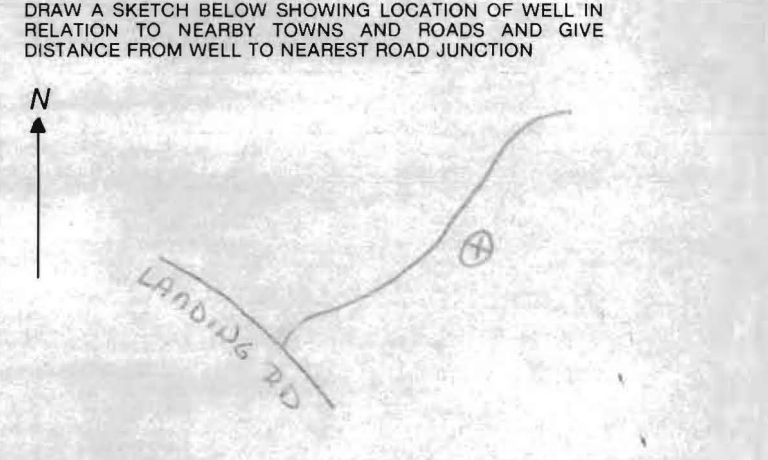

Not to be filled in by driller (OEP USE ONLY) APPROX. PERMIT NUMBER GAP FORCE INITIALS IN BOX PERMIT No. 10734337

NOT TO BE FILLED IN BY DRILLER HEALTH DEPARTMENT APPROVAL HOWARD COUNTY NAME A32458 COUNTY NO. OEP SIGNATURE DATE ISSUED CO SIGNATURE NORTH GRID EAST GRID EXPIRES

SPECIAL CONDITIONS 8-63

465-4433

10 45 am
11/30/82

FILE Replacement Well Site Check DATE REPORTED 11/30/82

PROPERTY OWNER Catherine Luber

P. O. ADDRESS 6851 Norris Lane

DIRECTIONS TO PROPERTY near Trinity Prep. School 8/10 mile from Landing Rd.

INFORMANT Ms. Luber has spring which is contaminated
septic behind house; spring to left of house
Meet Gold Mustang @ Norris Lane & Landing Rd.

CONDITION FOUND: 11/30/82 Talked with Mrs Luber. New well
location can be anywhere in front of house.
Because of extreme slope graded around front,
well will be at least 50 ft from house. J
(see sketch on back)

12/3/82 T.C. c Harr Drilling Co. re. permit # is HO-73-4338 J.S.

ACTION TAKEN: _____

FINAL DISPOSITION: _____

Step slope
springs
(X)

Septic area

