

PUBLIC SEWER AVAILABLE: YES NO

ISSUE DATE:

2/13/02

**PERMIT
INDEXED**

P

516513

APPROVAL DATE:

2/14/02

A

REPAIR

**ON-SITE SEWAGE DISPOSAL SYSTEM
HOWARD COUNTY HEALTH DEPARTMENT
BUREAU OF ENVIRONMENTAL HEALTH**

02-199408

Jenkins Brothers

IS PERMITTED TO

INSTALL

ALTER

ADDRESS:

7670 Smith's Private Road, Sykesville

PHONE NUMBER:

410-461-9282

SUBDIVISION:

NA

LOT NUMBER:

NA

ADDRESS:

3552 Church Road

PROPERTY OWNER:

David Gallitano

SEPTIC TANK CAPACITY (GALLONS):

ex: 1250-1500 midseam?

PUMP CHAMBER CAPACITY (GALLONS):

NA

NUMBER OF BEDROOMS:

4

SQUARE FEET PER BEDROOM:

180

LINEAR FEET OF TRENCH REQUIRED:

103' (2-50' Trenches)

TRENCHES:	Trench to be 2 feet wide. Inlet 2 feet below original grade. Bottom maximum depth 9 feet below original grade. Effective area begins at 2 feet below original grade. 7 feet of stone below distribution pipe.
LOCATION:	Run 2 Trenches on Contour as discussed in field 10-12' CTC w/new d. box if needed
PURPOSE:	Existing septic system has failed. Call for inspection when ground is opened so sanitarian can recommend repair.

PLANS APPROVED:

Steven R. Krieg

DATE:

2/13/02

NOTE: PERMIT VOID AFTER 2 YEARS

NOTE: CONTRACTOR RESPONSIBLE FOR SCHEDULING A PRE-CONSTRUCTION INSPECTION FOR ALL INSTALLATIONS

NOTE: WATERTIGHT SEPTIC TANKS REQUIRED

NOTE: ALL PARTS OF SEPTIC SYSTEM SHALL BE 100 FEET FROM ANY WATER WELL


NOTE: MANHOLE RISERS REQUIRED ON ALL SEPTIC TANKS AND PUMP CHAMBERS

**NEITHER THE HOWARD COUNTY COUNCIL NOR THE HEALTH DEPARTMENT IS
RESPONSIBLE FOR THE SUCCESSFUL OPERATION OF ANY SYSTEM
PERMITTEE RESPONSIBLE FOR OBTAINING FINAL APPROVAL ON THIS PERMIT
CALL 410-313-2640 FOR INSPECTION OF SEPTIC SYSTEM**

P516513

NOT TO SCALE

(B)

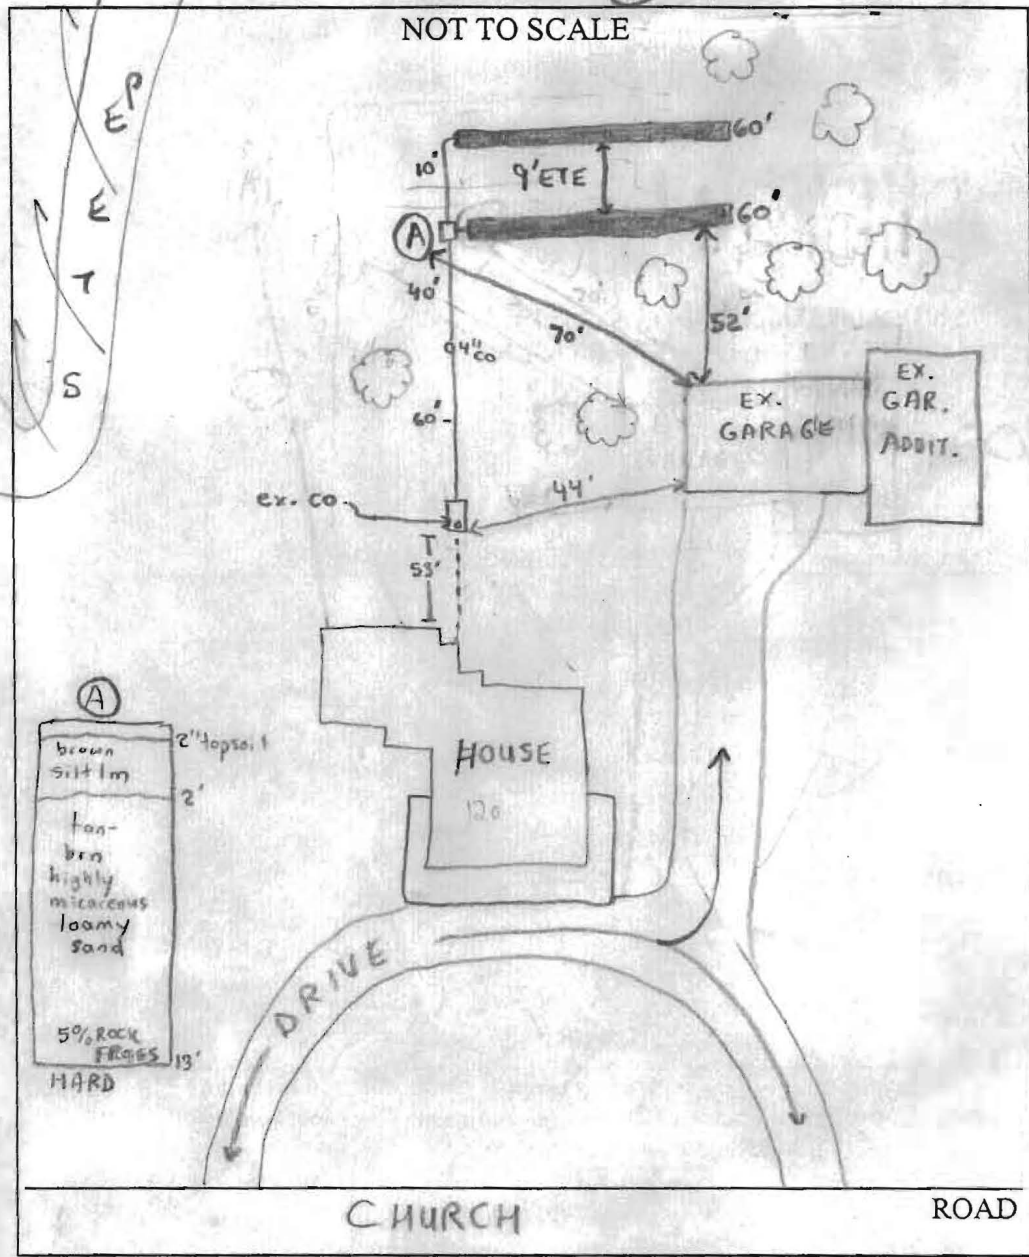

TRENCH/DRAINFIELD DATA		
WIDTH	INLET	BOTTOM
2'	2'	9'
NUMBER OF TRENCHES		2
TOTAL LENGTH		120'
ABSORPTION AREA		840ft ²
DISTRIBUTION BOX LEVEL		✓
DISTRIBUTION BOX BAFFLE		✓
DISTRIBUTION BOX PORT		NA

SEPTIC TANK DATA EXISTING	
SEPTIC TANK 1 LEVEL	✓
CAPACITY	1500? GAL
SEAM LOC	likely mid
TANK LID DEPTH	2'±
BAFFLES	rear repl. w/PVC
BAFFLE FILTER	NA
MANHOLE LOC	NA
6" PORT LOC	front ex.
WATERTIGHT TEST	NA
SEPTIC TANK 2 LEVEL	NA
CAPACITY	NA GAL
SEAM LOC	NA
TANK LID DEPTH	NA
BAFFLES	NA
BAFFLE FILTER	NA
MANHOLE LOC	NA
6" PORT LOC	NA
WATERTIGHT TEST	NA

PRE-CONSTRUCTION 2/13/02^{AM} - PERC HOLE DUG IN LOCATION (A) SEE SOIL PROFILE, INSTALL PER DISCUSSED IN FIELD, WILL PERC SHALLOW & SIDEWALLS ARE IDEAL FOR DEEP TRENCH SYSTEM - (SRV)

INSTALLATION 2/13/02^{PM} - OK TO CONTINUE WORK, CALL FOR FINAL TOMORROW

- (SRV/KF) 2/14/02 - OK TO COVER ALL WORK, ONLY 5-10% ROCK ENCOUNTERED IN TRENCHES, HOUSE HAS PUBLIC H₂O, PREVIOUS WELL LOCATION UNKNOWN BY CURRENT HOMEOWNER - (SRV)

NEAR (B)

PLENTY OF AREA EXISTS ON LOT FOR FUTURE REPAIRS ASSUMING GOOD SOILS

FINAL INSPECTOR Steven R. Krieg DATE OF APPROVAL 2/14/02