

# APPLICATION

A 21795

P \_\_\_\_\_

## SEWAGE DISPOSAL TESTING

STATE OF MARYLAND - DEPARTMENT OF HEALTH AND MENTAL HYGIENE

HOWARD COUNTY HEALTH DEPARTMENT  
ENVIRONMENTAL HEALTH SERVICES  
P. O. BOX 478, ELLICOTT CITY, MARYLAND 21043  
TELEPHONE 465-3000, EXT. 336

DISTRICT 4

DATE 7/10/75

TO: THE COUNTY HEALTH OFFICER  
ELLICOTT CITY, MARYLAND

I, HEREBY, APPLY FOR THE NECESSARY TEST IN ORDER TO CONSTRUCT (OR RECONSTRUCT) A SEWAGE DISPOSAL SYSTEM.

PROPERTY OWNER Robert M. Warfield & wife

ADDRESS Daisy Road, Woodhins, Md. PHONE 774-7893

PROPERTY LOCATION:

SUBDIVISION \_\_\_\_\_ LOT NO. \_\_\_\_\_

ROAD AND DESCRIPTION Daisy Road - sign says ROBERT M. WARFIELD - Quarry on the Cat Tail approx. 2 miles from Lisbon on left

SIZE OF LOT 11.163 acres TYPE BLDG. Farm trailer  
3  
NUMBER OF BEDROOMS

IF NOT SINGLE RESIDENCE DESCRIBE \_\_\_\_\_

THE SYSTEM INSTALLED UNDER THIS APPLICATION IS ACCEPTABLE ONLY UNTIL PUBLIC FACILITIES BECOME AVAILABLE

SIGNATURE OF APPLICANT Robert M. Warfield

APPROVED BY \_\_\_\_\_ FOR \_\_\_\_\_ DATE \_\_\_\_\_  
(KIND OF SYSTEM)

REJECTED BY \_\_\_\_\_ FOR \_\_\_\_\_ DATE \_\_\_\_\_  
(KIND OF SYSTEM)

HOLD PENDING FURTHER TESTS \_\_\_\_\_ DATE \_\_\_\_\_

REASONS FOR REJECTION OR HOLDING \_\_\_\_\_

# THIS IS NOT A PERMIT



5/20/71  
5/21/71  
Mississippi  
Don

APP 7-1-71  
DUMP

# PERMIT

SEWAGE DISPOSAL SYSTEM

MARYLAND STATE DEPARTMENT OF HEALTH

HOWARD COUNTY

P 15960

A 15175

ELLICOTT CITY

DISTRICT 4

DATE 5/20/71

## INDEXED

7/1/71  
Ready

Don Grigsby IS PERMITTED TO INSTALL R ALTER

ADDRESS Mt. Airy, Maryland PHONE \_\_\_\_\_

A SEWAGE DISPOSAL SYSTEM LOCATED AT \_\_\_\_\_

SUBDIVISION \_\_\_\_\_ ROAD Daisy LOT \_\_\_\_\_

PROPERTY OWNER Robert M. Warfield, et al

ADDRESS \_\_\_\_\_

SPECIFICATIONS - 5 bedrooms

DRAIN FIELD \_\_\_\_\_ DEPTH \_\_\_\_\_ FEET, BOTTOM AREA \_\_\_\_\_ SQ. FT.

SEEPAGE PITS \_\_\_\_\_ ABSORBENT SIDE-WALL AREA \_\_\_\_\_ SQ. FT.

SEPTIC TANK CAPACITY 1,500 GALLONS

FOR GARBAGE GRINDER, INCREASE DISPOSAL AREA 22% & TANK CAPACITY 50%.

OTHER Dry well - dig pit 16 ft. sq. set block and top for 12 ft. diameter and

fill in rest of pit with gravel. Dry well to have 6 ft. effective area below the first

5 ft. of non-absorbent ground, then come off dry well with 5 ft. solid pipe.

Then begin trench - trench to be 40 ft. long 11 to 12 ft. deep with 5 ft. gravel under pipe. Max. depth permitted for dry well is 12 ft. below original grade.

Locate dry well 27 ft. behind right rear corner of house as seen when facing from stream, Trench to be to left of dry well.

CALL FOR INSPECTION OF TRENCH BEFORE GRAVEL IS INSTALLED.

PLANS APPROVED BY Donald W. Monaghan DATE 3/31/71

NOTE: ALL PIPE FROM HOUSE TO SEPTIC TANK MUST BE CAST IRON.

FILL SEPTIC TANK AND DISTRIBUTION BOX WITH WATER BEFORE CALLING FOR AN INSPECTION. COVER NO WORK UNTIL INSPECTED AND APPROVED.


PERMIT VOID AFTER THREE YEARS.

NEITHER THE HOWARD COUNTY COMMISSIONERS NOR THE HEALTH DEPARTMENT IS RESPONSIBLE FOR THE SUCCESSFUL OPERATION OF ANY SYSTEM.

A 15175

17-1-71  
 02103

45.10  
 64.5  
 320  
 450  
 76

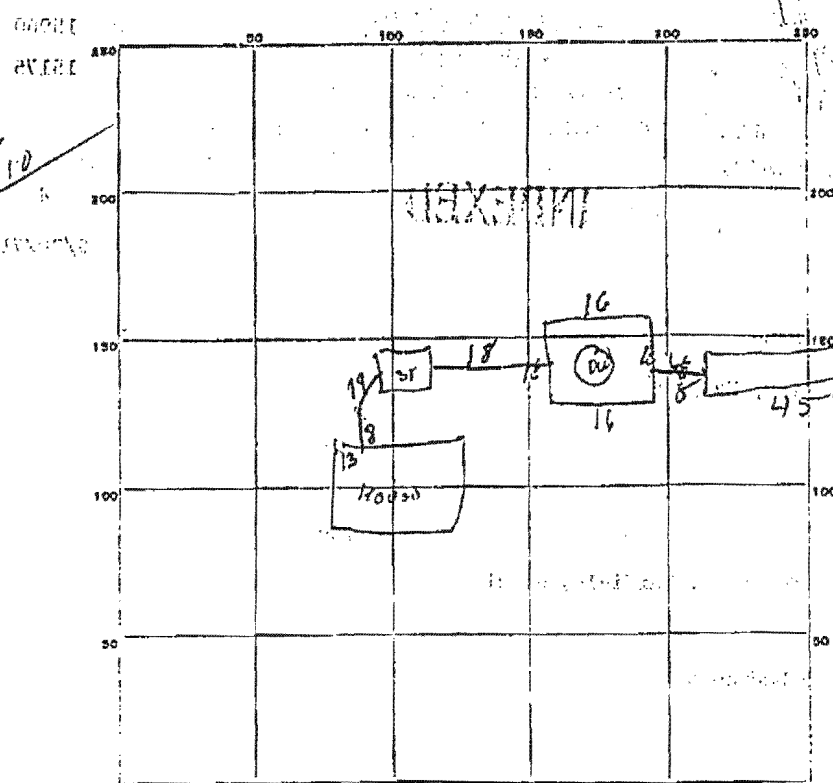

PERMIT CARD OK

SEPTIC TANK, LEVEL OK CLEANOUTS 012

DISTRIBUTION BOX, LEVEL \_\_\_\_\_

TILE FIELD, DEPTH \_\_\_\_\_ FT. TRENCH WIDTH \_\_\_\_\_ FT.

GRAVEL DEPTH \_\_\_\_\_ IN. TOTAL LENGTH \_\_\_\_\_ FT.

NUMBER OF TRENCHES \_\_\_\_\_ TOTAL BOTTOM AREA \_\_\_\_\_

SEEPAGE PITS, INSIDE DIAMETER 64 FT. DEPTH BELOW INLET 9' 6" + effective trunk with 5' r effluent

ABSORBENT AREA 770+ SQ. FT.

REMARKS 5-20-71 - need 5 ft solid pipe of dry well - then trench across  
all dirt must be removed from under tile - tile must not be clean gravel.  
tile must be spaced 1/2 to 3/4 inch apart - joints to be covered with 1/2 inch tan paper.  
slope in trench must be 1/2" per 40 ft. - inside of gravel  
over pipe then roofing paper - need 8" black pipe on septic tank  
to grade level - pipe from foundation to tank + from tank to dry well  
must be installed

DATE SYSTEM APPROVED 7-1-71 INSPECTOR D.W. Morgan

call for final when all of above is done

# APPLICATION

SEWAGE DISPOSAL TESTING

MARYLAND STATE DEPARTMENT OF HEALTH

HOWARD COUNTY

ELLICOTT CITY

DISTRICT 4

DATE 4/22/70

A 15175

P \_\_\_\_\_

TO: THE COUNTY HEALTH OFFICER  
ELLICOTT CITY, MARYLAND

I, HEREBY, APPLY FOR THE NECESSARY TESTS IN ORDER TO CONSTRUCT (OR RECONSTRUCT) A SEWAGE DISPOSAL SYSTEM.

PROPERTY OWNER Robert M. Warfield, et al

ADDRESS Woodbine, Maryland

PHONE 489-4135

PROPERTY LOCATION:

SUBDIVISION \_\_\_\_\_ LOT NO. \_\_\_\_\_

ROAD AND DESCRIPTION Dadby Road

OCCUPANT \_\_\_\_\_ PHONE \_\_\_\_\_

PERSON TO CONSTRUCT SYSTEM \_\_\_\_\_

ADDRESS \_\_\_\_\_ PHONE \_\_\_\_\_

SIZE OF LOT 10.00 acres TYPE BLDG. 5

NUMBER OF BEDROOMS

IF NOT SINGLE RESIDENCE DESCRIBE \_\_\_\_\_ (Single Fmly. Dwllg.)

SIGNATURE OF APPLICANT Robert M. Warfield

✓ APPROVED BY Ann Mangham

FOR

Shirley (S)  
(HIND OF SYSTEM)

DATE

4/25/70

REJECTED BY \_\_\_\_\_ FOR \_\_\_\_\_ DATE \_\_\_\_\_

(HIND OF SYSTEM)

HOLD PENDING FURTHER TESTS \_\_\_\_\_ DATE \_\_\_\_\_

REASONS FOR REJECTION OR HOLDING \_\_\_\_\_

## THIS IS NOT A PERMIT



