


33
A
p

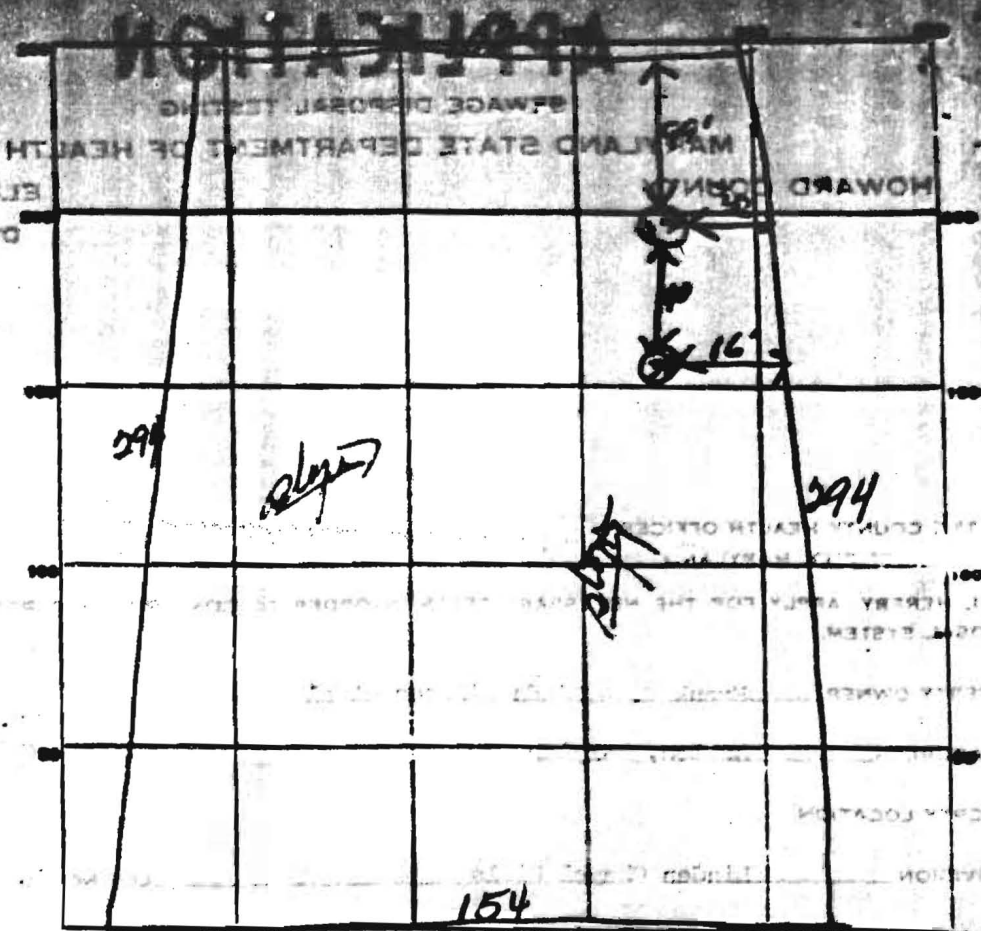

INDICATE NORTH - NAME ADJOINING HIGHWAY AS EDGE LINE

Wm Mamed Rd

Lot 5-C

DATE	TEST NO.	DEPTH	PRE-WET		TEST - 1" DROP		TIME
			START	STOP	START	STOP	
3/18/71	1	12	1105	1106	1106	1110	4 min
	2	4	1105	1108	1108	1102	4 min
	3	9	1114	1116	1116	1130	4 min
	4	3	1114	1117	1117	1130	5 min

SOIL AUGER FINDING: *chle 4 to 14 ft deep dry 3/4*

TESTED BY: *[Signature]*

REMARKS: *[Blank]*

THIS IS NOT A TOU 21 21HT