




USED SPLIT 3 RAIL  
CE W/WIRE MESH

1928 PF  
Proposed pool  
location ok  
as shown.

(JKB)

1-18-06  
Proposed steel beams  
OK (KJB)

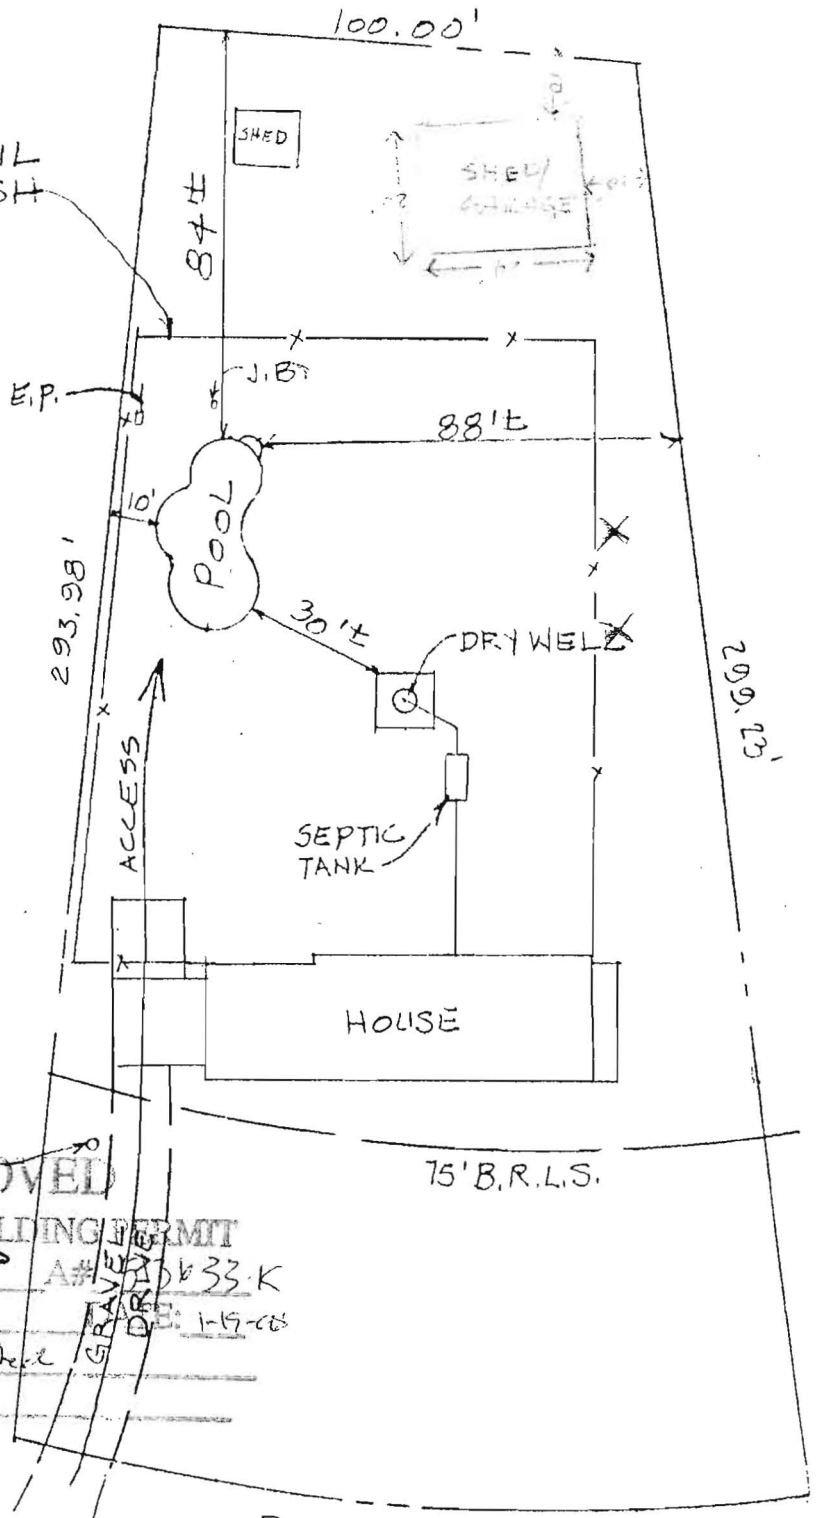

APPROVED

WALK-THRU BUILDING PERMIT  
 BP# **B00157808** A# **20633-K**  
 APP. SAN **KJB** DATE: **1-17-06**  
 DESC. OF WORK: **Steel Beam**

ORION DRIVE  
 SCALE: 1" = 40'

