

WELL COMPLETION REPORT

WELL NUMBER 15762

DATE OF WELL COMPLETION July 27, 1976 DEPTH OF WELL 300 FEET TO NEAREST FOOT

PERMIT NO. 14-73-2728

OWNER Briggs LAST NAME Funkhouser FIRST NAME Thos.

STREET OR RFD _____ POST OFFICE _____

WELL LOG

STATE THE KIND OF FORMATIONS PENETRATED, THEIR COLOR, DEPTH, THICKNESS AND IF WATER BEARING

DESCRIPTION (USE ADDITIONAL SHEETS IF NECESSARY)	FEET		WATER BEARING
	FROM	TO	
<u>Sand</u>	<u>0</u>	<u>38</u>	
<u>Micro Rock</u>	<u>38</u>	<u>300</u>	

GROUTING RECORD

WELL HAS BEEN GROUTED (CIRCLE APPROPRIATE BOX)

TYPE OF GROUTING MATERIAL (CIRCLE ONE)

CEMENT GYPSUM CEMENT

NO. OF BAGS 19 NO. OF PUMPS 876

GALLONS OF WATER 41

DEPTH OF GROUT SEAL (TO NEAREST FOOT)

FROM 0 FT. TO 38 FT.

CASING RECORD

CASING TYPES (INSERT APPROPRIATE CODE BELOW)

STEEL CONCRETE

PLASTIC OTHER

MAIN CASING TYPE SH NOMINAL DIAMETER (NEAREST INCH) 6 TOTAL DEPTH OF MAIN CASING (NEAREST FOOT) 40

OTHER CASING (IF USED)

DIAMETER (INCH) _____ DEPTH (FEET) _____

SCREEN RECORD

SCREEN TYPE OR OPEN HOLE (INSERT APPROPRIATE CODE BELOW)

STEEL BRASS BRASS OR STEEL

PLASTIC OTHER

SCREENING

DEPTH (NEAREST WHOLE FOOT)

1 56 370

SLOT SIZE 1. _____ 2. _____ 3. _____

DIAMETER OF SCREEN _____ INCH

GRAVEL PACK _____

IF WELL DRILLED WAS A FLOWING WELL (CIRCLE ONE)

TELESCOPE CASING LOG INDICATOR OTHER DATA AVAILABLE

PUMP TEST

WELL PUMPED TO NEAREST GALLON 2

PUMPING RATE (GALLONS PER MINUTE TO NEAREST GALLON) 1

METHOD USED TO MEASURE PUMPING RATE liters

WATER LEVEL (INSTANT) (FROM LAND SURFACE)

BEFORE PUMPING 60 (NEAREST FOOT)

WHEN PUMPING 100 (NEAREST FOOT)

TYPE OF PUMPS USED (CIRCLE APPROPRIATE ONE)

A AIR P PISTON T TURBINE

C CENTRIFUGAL R ROTARY O OTHER (DESCRIBE BELOW)

J JET S SUBMERSIBLE

PUMP INSTALLED

TYPE OF PUMP (INSERT APPROPRIATE LETTERS) _____

DRILLER WILL INSTALL PUMP (CIRCLE APPROPRIATE BOX)

CAPACITY: _____

PUMP HORSE POWER _____

PUMP COLUMN LENGTH (NEAREST FOOT) 43 67

CASING HEIGHT (CIRCLE APPROPRIATE BOX)

ABOVE BELOW

LOCATION OF WELL ON LOT

SHOW PERMANENT STRUCTURE SUCH AS BUILDING, SEPTIC TANKS, AND/OR OTHER LAND MARKS AND INDICATE NOT LESS THAN TWO DISTANCED MEASUREMENTS TO WELL.

Front
House

CIRCLE APPROPRIATE BOXES

A WELL WAS ABANDONED AND SEALED WHEN THIS WELL WAS COMPLETED

E ELECTRIC LOG OBTAINED

P TEST WELL CONVERTED TO PRODUCTION WELL

I HEREBY CERTIFY THAT I HAVE COMPLIED WITH ALL CONDITIONS STATED ON THE ABOVE-CITED "PERMIT TO DRILL WELL", AND THAT THE INFORMATION CONTAINED IN THIS REPORT IS TRUE, ACCURATE, AND COMPLETE TO THE BEST OF MY KNOWLEDGE, INFORMATION AND BELIEF.


DRILLERS NAME Jesse P. Magee

(PLEASE PRINT) Jesse P. Magee

SIGNATURE Jesse P. Magee

List of Property Owners in Orion Drive, also known as Lot 5 in the subdivision
"Linden Chapel Hills" and recorded map of the land records of Howard County in Plat
Book 23, Folio 67.

A15762

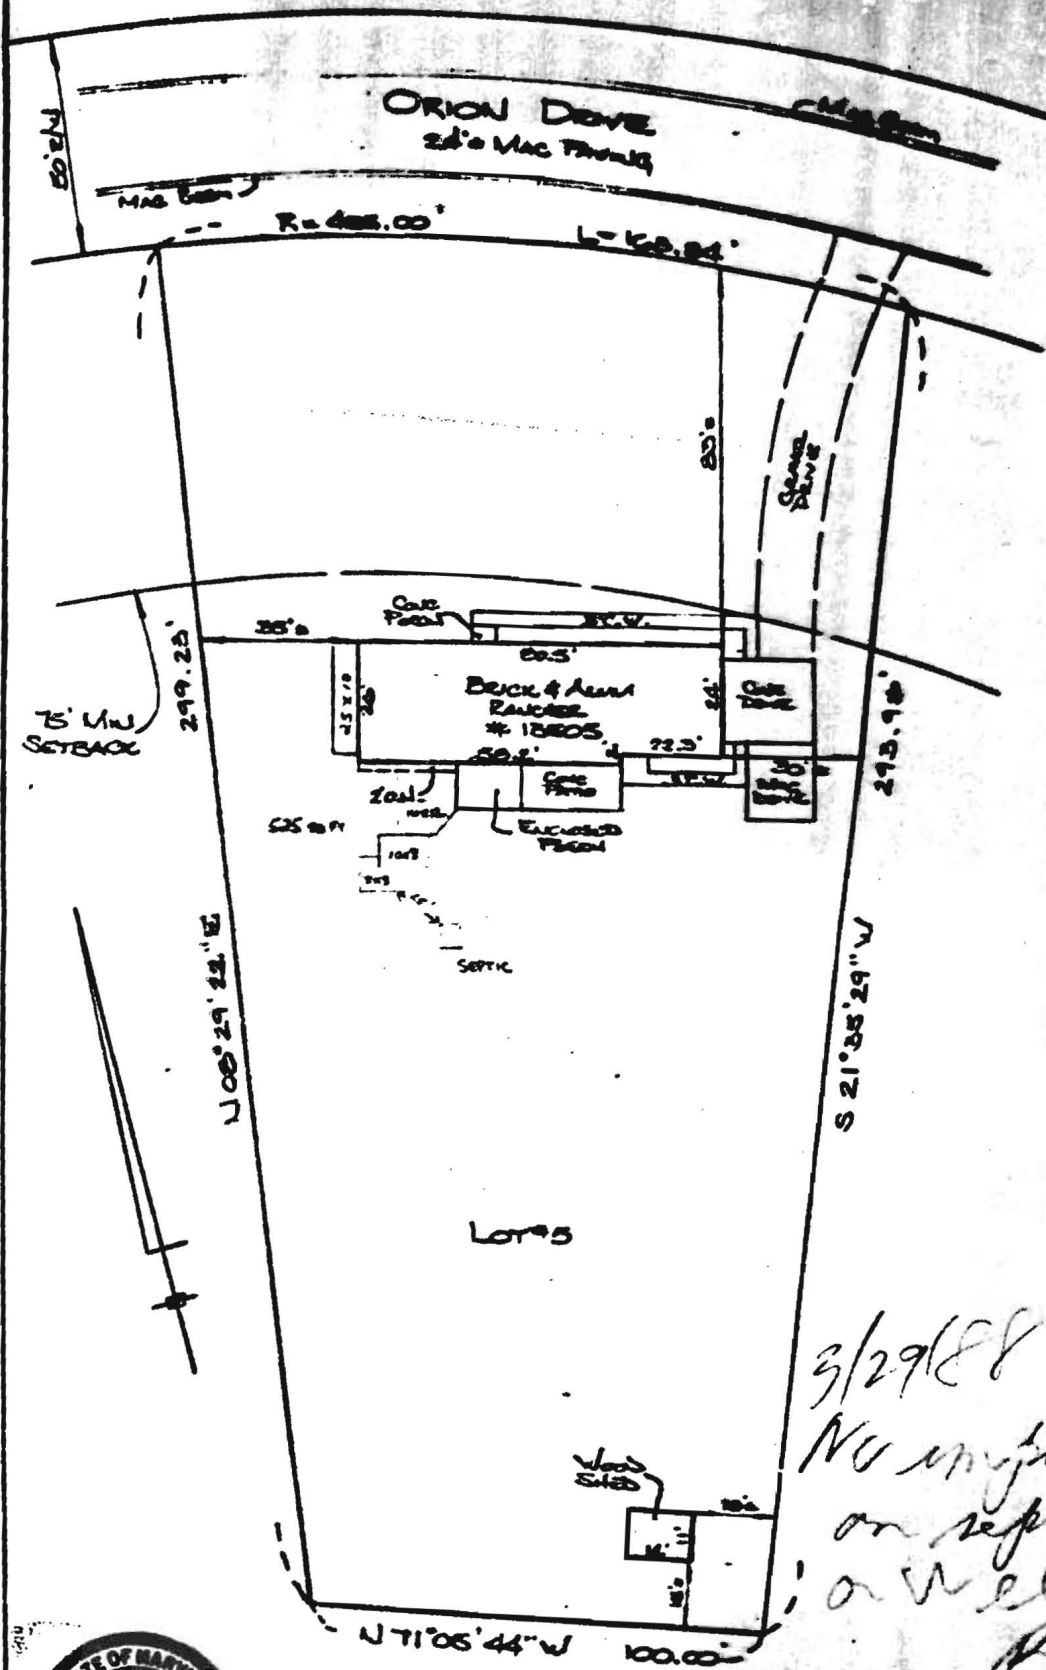


3/29/88
No impact
on septic
or well
RJD



SITE INSPECTION SHEET

OWNER: Allan Ames PHONE #: 410-531-0749
ADDRESS: 13505 Orion Drive CONTRACTOR: _____
SUBDIVISION: _____ LOT: _____ WELL TAG #: HO-73-0704
PROPOSAL: 20 x 24' Shed COUNTY #: Howard

LOCATION DIAGRAM

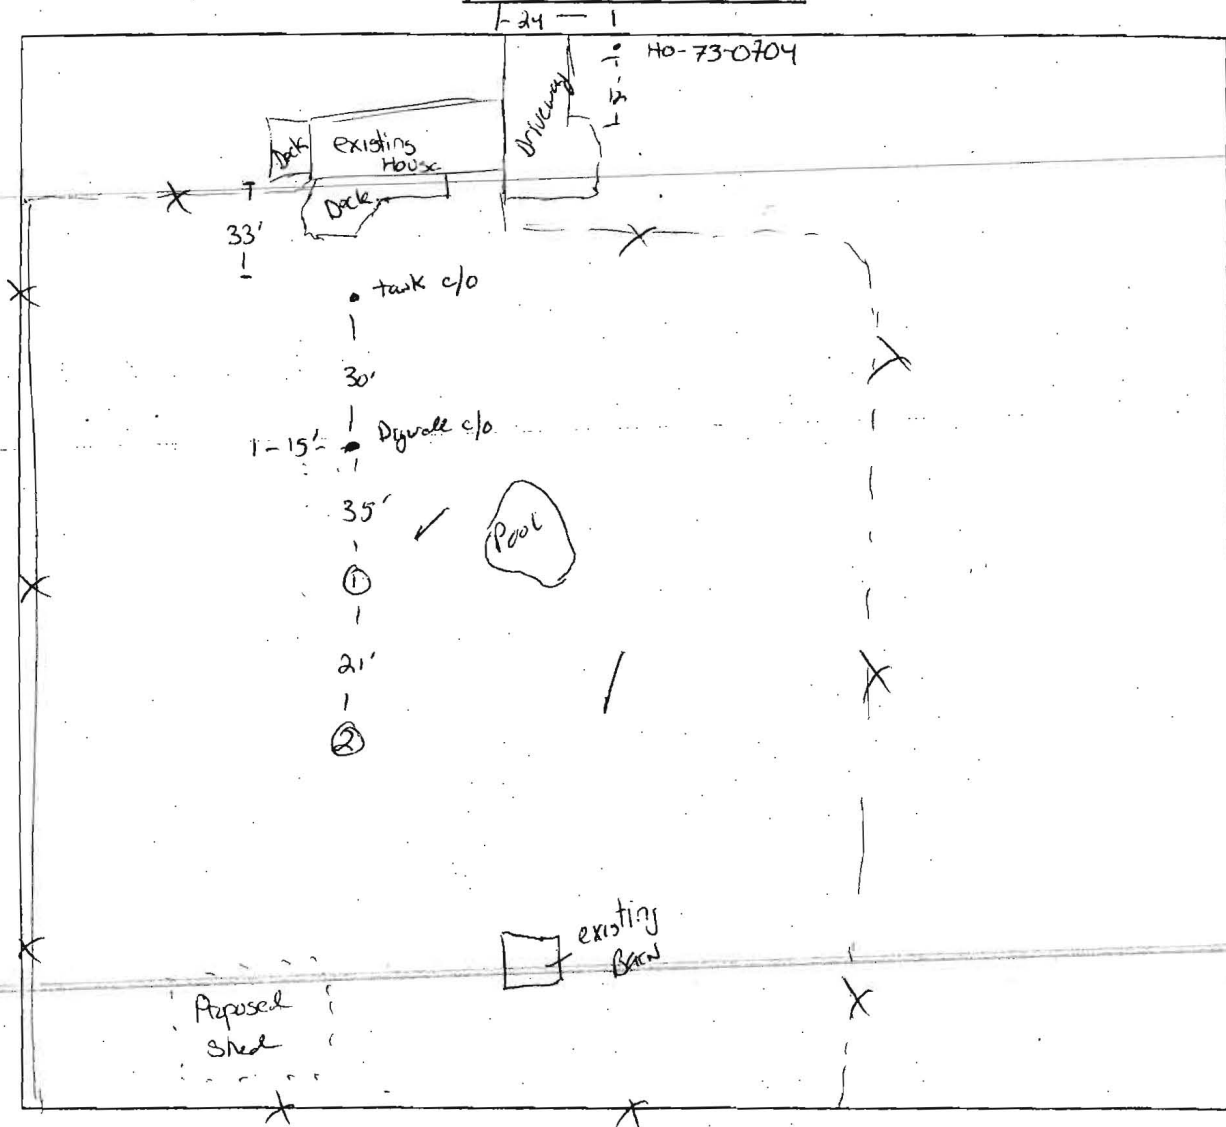

COMMENTS: Two hand augers will be used to establish repair area for future system.

DATE: 1-13-06

INSPECTOR: KJB