

LAYOUT 2/11/03 2/5/03 11 AM INSP 4 \_\_\_\_\_  
 INSP 2 3/5/03 12 INSP 5 \_\_\_\_\_  
 INSP 3 3/19/03 1:30 INSP 6 \_\_\_\_\_

ISSUE DATE: 1/27/2003

APPROVAL DATE: 3/19/03

**PERMIT**  
**INDEXED**

P 518521  
 A 525256  
 A 514687E

*RPS#*  
*OS-434939*

**ON-SITE SEWAGE DISPOSAL SYSTEM**  
**HOWARD COUNTY HEALTH DEPARTMENT**  
**BUREAU OF ENVIRONMENTAL HEALTH**

Fogles Septic Clean, Inc IS PERMITTED TO INSTALL  ALTER

ADDRESS: 580 Obrecht Road PHONE NUMBER: 410-795-5670

SUBDIVISION: Pindell Woods LOT NUMBER: 3

ADDRESS: 7201 Preservation Court PROPERTY OWNER: Dale Thompson Builders

SEPTIC TANK CAPACITY (GALLONS): 1500 OUTLET BAFFLE FILTER REQUIRED

PUMP CHAMBER CAPACITY (GALLONS): ~~1500~~ COMPARTMENTED TANK REQUIRED

NUMBER OF BEDROOMS: 5

SQUARE FEET PER BEDROOM: 210

LINEAR FEET OF TRENCH REQUIRED: ~~263~~ 240 SFR

TRENCHES:	Trench to be 2.0 feet wide. Inlet 3.5 feet below original grade. Bottom maximum depth 7.5 feet below original grade. Effective area begins at 4.0 feet below original grade. 4.0 feet of stone below distribution pipe.
LOCATION:	Place the distribution box as shown on the building permit plan.. <del>Run trenches on contour toward Preservation Court. Future pool to be installed 20' from easement.</del> <i>System Design changed in field. Future pool to be installed 20' from easement</i>
NOTES:	Maintain 100 foot separation from the well on lot 23. <i>from easement</i>

PLANS APPROVED: Brian Baker *OK* 1/17/03 *(SO)* DATE: 9/10/2002


- NOTE: PERMIT VOID AFTER 2 YEARS
- NOTE: CONTRACTOR RESPONSIBLE FOR SCHEDULING A PRE-CONSTRUCTION INSPECTION FOR ALL INSTALLATIONS
- NOTE: WATERTIGHT SEPTIC TANKS REQUIRED
- NOTE: ALL PARTS OF SEPTIC SYSTEM SHALL BE 100 FEET FROM ANY WATER WELL
- NOTE: MANHOLE RISERS REQUIRED ON ALL SEPTIC TANKS AND PUMP CHAMBERS UNLESS SPECIFICALLY AUTHORIZED

**NEITHER THE HOWARD COUNTY COUNCIL NOR THE HEALTH DEPARTMENT IS RESPONSIBLE FOR THE SUCCESSFUL OPERATION OF ANY SYSTEM PERMITTEE RESPONSIBLE FOR OBTAINING FINAL APPROVAL ON THIS PERMIT CALL 410-313-2640 FOR INSPECTION OF SEPTIC SYSTEM**

**BUILDING PERMIT SIGNED AND RETURNED**

*11/16/05 BOO 157032 - IG POOL*  
*5/26/06 BOO 157130 - Sun Room*

NOT TO SCALE

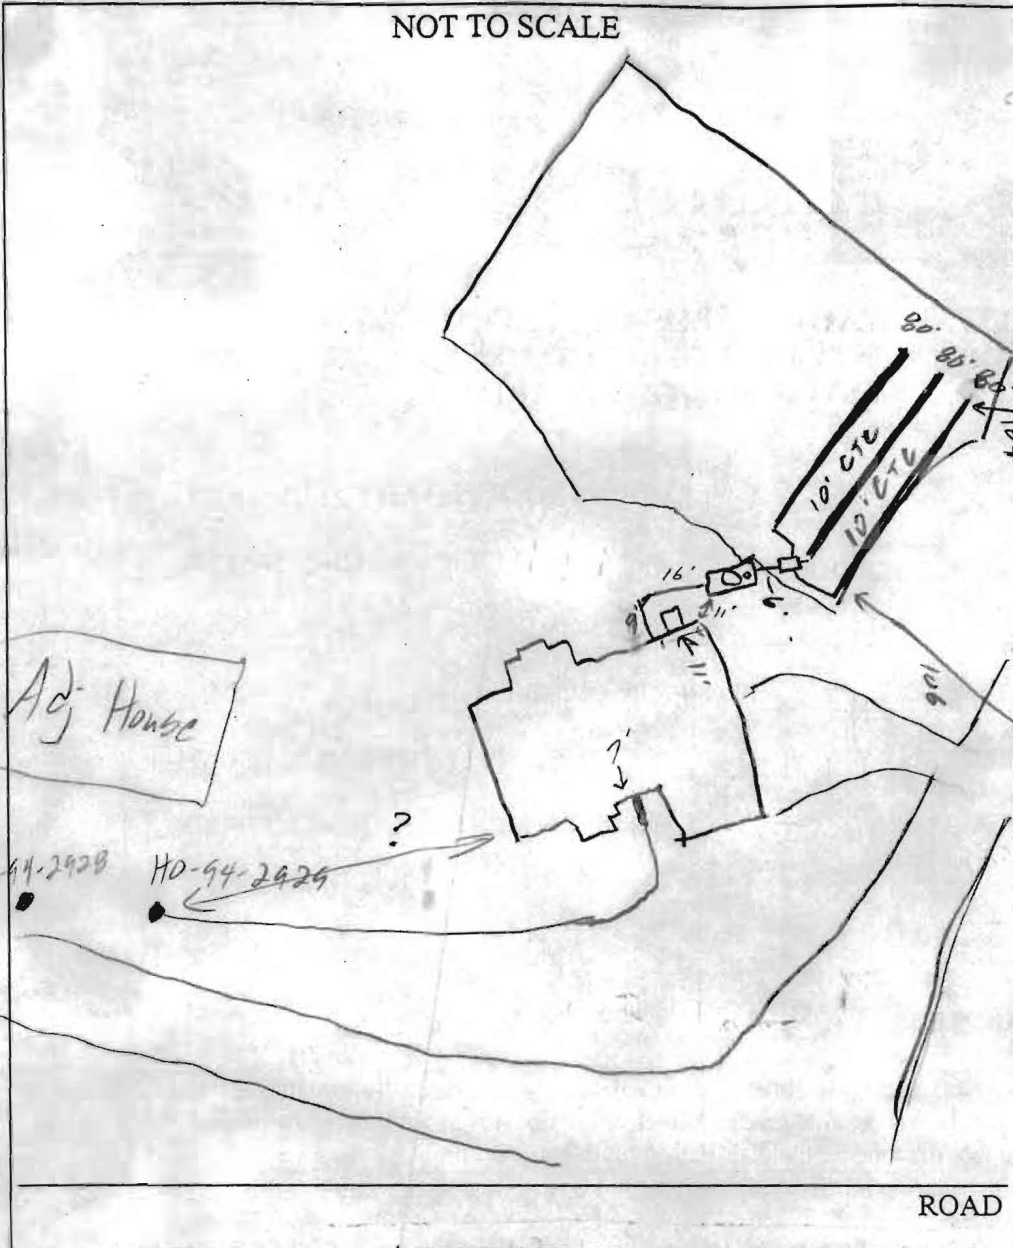

TRENCH/DRAINFIELD DATA		
WIDTH	INLET	BOTTOM
2	3.5	7.5
NUMBER OF TRENCHES		3
TOTAL LENGTH		240'
ABSORPTION AREA		720 <del>4</del>
DISTRIBUTION BOX LEVEL		<input checked="" type="checkbox"/>
DISTRIBUTION BOX BAFFLE		<input checked="" type="checkbox"/>
DISTRIBUTION BOX PORT		<input type="checkbox"/>



SEPTIC TANK DATA	
SEPTIC TANK 1 LEVEL <input checked="" type="checkbox"/>	
CAPACITY	1250 GAL
SEAM LOC	Top
TANK LID DEPTH	1-1.5'
BAFFLES	<input checked="" type="checkbox"/>
BAFFLE FILTER	<input checked="" type="checkbox"/>
MANHOLE LOC	Center
6" PORT LOC	Front
WATERTIGHT TEST	<input checked="" type="checkbox"/>
SEPTIC TANK 2 LEVEL _____	
CAPACITY	_____ GAL
SEAM LOC	_____
TANK LID DEPTH	M/A
BAFFLES	M/A
BAFFLE FILTER	_____
MANHOLE LOC	_____
6" PORT LOC	_____
WATERTIGHT TEST	_____

PRE-CONSTRUCTION 2/5/03 SDA staked contour not as shown, need to shoot on a warmer less windy day (SD) 3/5/03 Not ready (SD) 3/17/03

INSTALLATION Revised specs (SD/SRK) 3/19/03 OK to cover all work (SC)

FINAL INSPECTOR [Signature] DATE OF APPROVAL 3/19/03

— 5' — 5' — 5' — SILT FENCE  
 — 100' — 100' — 100' — LIMIT OF DISTURBED AREA

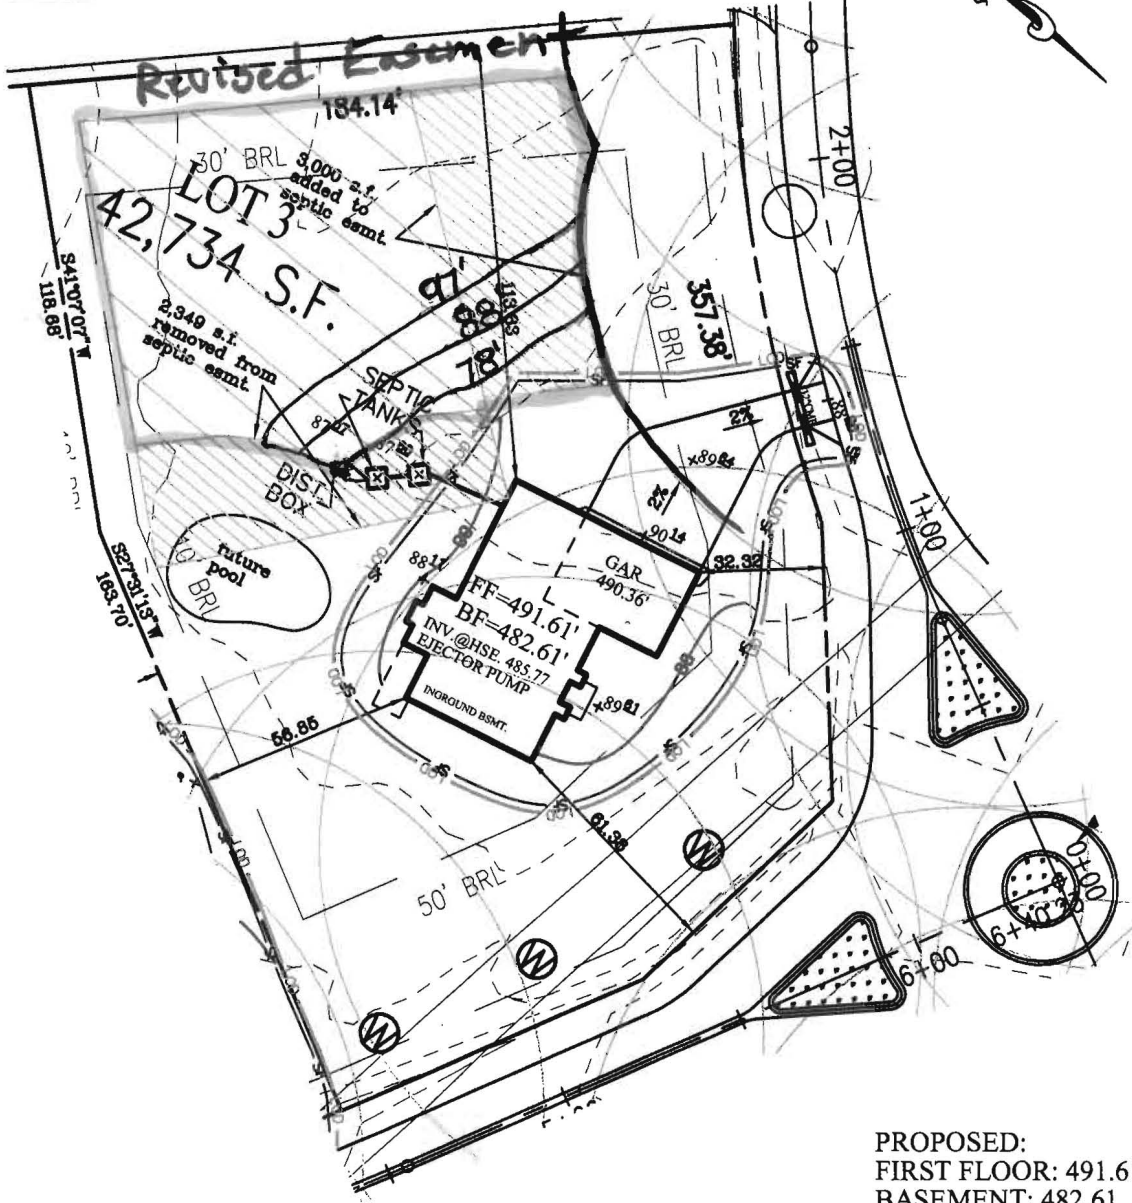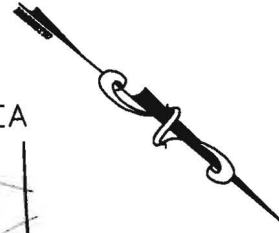

PAVING SPECIFICATION:  
 2' ASPHALT 4'CR-6 OR  
 2.5' ASPHALT 1.5' OVERLAY

GRADE@SEPTIC TANK: 487.80  
 GRADE@DIST.BOX: 487.07  
 GRADE@TRENCHES: 487.07

PROPOSED:  
 FIRST FLOOR: 491.61  
 BASEMENT: 482.61  
 INVERT OUT OF HOUSE: 485.77  
 INVERT INTO SEPTIC TANK: 485.30  
 INVERT INTO DIST.BOX: 485.57  
 INVERT INTO TRENCHES: 484.00

Engineers  
 Planners  
 Surveyors  
 Landscape Architects

**Dewberry & Davis LLC**  
 A Dewberry Company

10001 Dereewood Lane, Suite 100  
 Lanham, MD 20706  
 (301) 731-5551 Fax: (301) 731-0188

804 West Diamond Avenue, Suite 200  
 Gaithersburg, MD 20878-1414  
 (301) 948-8300 Fax: (301) 258-7607

HOUSE MODEL  
 LEWIS RESIDENCE

DATE: AUGUST 6, 2002  
 SCALE: 1"=50'

PLAT REFERENCES  
 LIBER/FOLIO:  
 PLAT BOOK:  
 PLAT NO. FOLIO:

LOT 3, PINDELL WOODS LOTS 1 THRU 47  
 AND PRESERVATION PARCELS A THRU F

OWNER/BUILDER:  
 DALE THOMPSON BUILDERS  
 6300 WOODSIDE COURT  
 COLUMBIA, MD 21045  
 (410) 995-6736


**PLOT PLAN  
 SINGLE FAMILY  
 DWELLING**

LOT 3 PINDELL WOODS  
 HOWARD COUNTY, MARYLAND

1/27/03

House located as per B.P. plan  
but lowered 1'. Basement gravity  
service not proposed. O.K. (BB)

MD. STATE GRID MERIDIAN

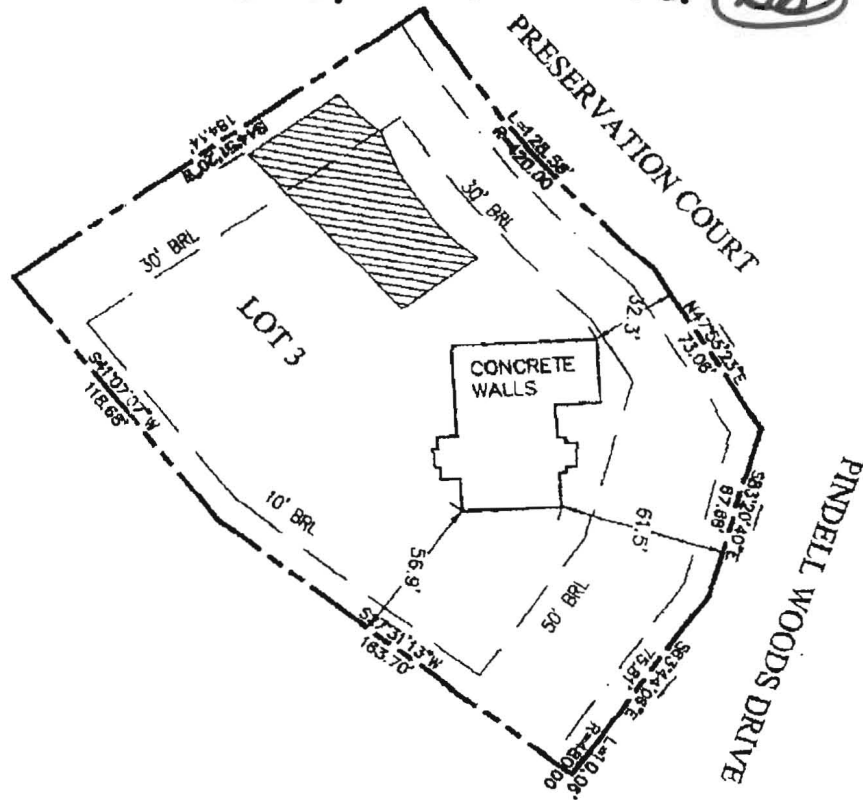

TOP OF WALL ELEVATION = 489.83

RECORD REFERENCES	WALL CHECK	MARKS & ASSOCIATES L.L.C. SURVEYORS—LAND PLANNING CONSULTANTS
LIBER/FOLIO PLAT BOOK/FOLIO PLAT NO. 14022	LOT 3 <b>PINDELL WOODS</b> HOWARD COUNTY, MARYLAND	4521 COLLEGE AVENUE ELICOTT CITY, MARYLAND TELEPHONE (410) 747-6738 FAX (410) 747-6739
SCALE: 1"=50' DATE: NOVEMBER 03, 2002		I HEREBY CERTIFY THAT THE IMPROVEMENTS ARE LOCATED AS SHOWN HEREON AND TO THE BEST OF MY KNOWLEDGE AND BELIEF, THERE ARE NO ENCROACHMENTS EXCEPT AS SHOWN. <i>Eric C. Marks</i> ERIK C. MARKS R.P.L.S. NO. 607