

APPLICATION

PERCOLATION TESTING

A _____

P _____

HOWARD COUNTY HEALTH DEPARTMENT
BUREAU OF ENVIRONMENTAL HEALTH
3525-H ELLICOTT MILLS DRIVE/ELLICOTT CITY, MARYLAND 21043
TELEPHONE: 313-2640

DISTRICT 5th

DATE _____

TO: THE COUNTY HEALTH OFFICER
ELLICOTT CITY, MARYLAND

I HEREBY APPLY FOR THE NECESSARY TEST PRIOR TO APPLICATION FOR PERMIT TO CONSTRUCT (OR RECONSTRUCT) A SEWAGE DISPOSAL SYSTEM.

PROPERTY OWNER H Y Real Estate Joint Venture, c/o Robert B. Canter, Esquire

ADDRESS 11921 Rockville Pike, Suite 300 PHONE (301) 230-5220
Rockville, MD. 20852-2737

AGENT OR PROSPECTIVE BUYER Mount View, LLC. Attention: Paul M. Revelle

ADDRESS 6258 Cardinal La, Columbia Md. 21044 PHONE (410) 992 5805

PROPERTY LOCATION:


SUBDIVISION Pindell Woods LOT NO. 3

ROAD AND DESCRIPTION "B"

TAX MAP 41 PARCEL # 274 & 275

SIZE OF LOT 1-Acre Lot TYPE BLDG. Single Family Dwelling
(SINGLE FAMILY DWELLING OR COMMERCIAL)

THE SYSTEM INSTALLED UNDER THIS APPLICATION IS ACCEPTABLE ONLY UNTIL PUBLIC FACILITIES BECOME AVAILABLE. I FULLY UNDERSTAND THE FEE CONNECTED WITH THE FILING OF THIS PERC TEST APPLICATION IS NON-REFUNDABLE UNDER ANY CIRCUMSTANCES. I ALSO AGREE TO COMPLY WITH ALL M.O.S.H.A. REQUIREMENTS IN TESTING THIS LOT.

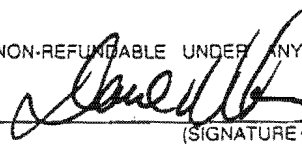
(SIGNATURE OF APPLICANT)

APPROVED BY _____ FOR _____ DATE _____

DISAPPROVED BY _____ FOR _____ DATE _____

HOLD PENDING FURTHER TESTS _____

REASONS FOR REJECTION OR HOLDING _____

PERCOLATION TEST PLAT/PRELIMINARY PLAT - TITLE OR I.D. # _____ DATE _____


SITE DEVELOPMENT PLAN/FINAL PLAT - TITLE OR I.D. # _____ DATE _____

THIS IS NOT A PERMIT

COUNTY #

SOIL PROFILE

0' 662
 1' topsoil
 red org
 brn
 sa cl lm
 4'
 med
 red brn
 sa mica
 lm
 15%+
 sapr
 sh
 12'

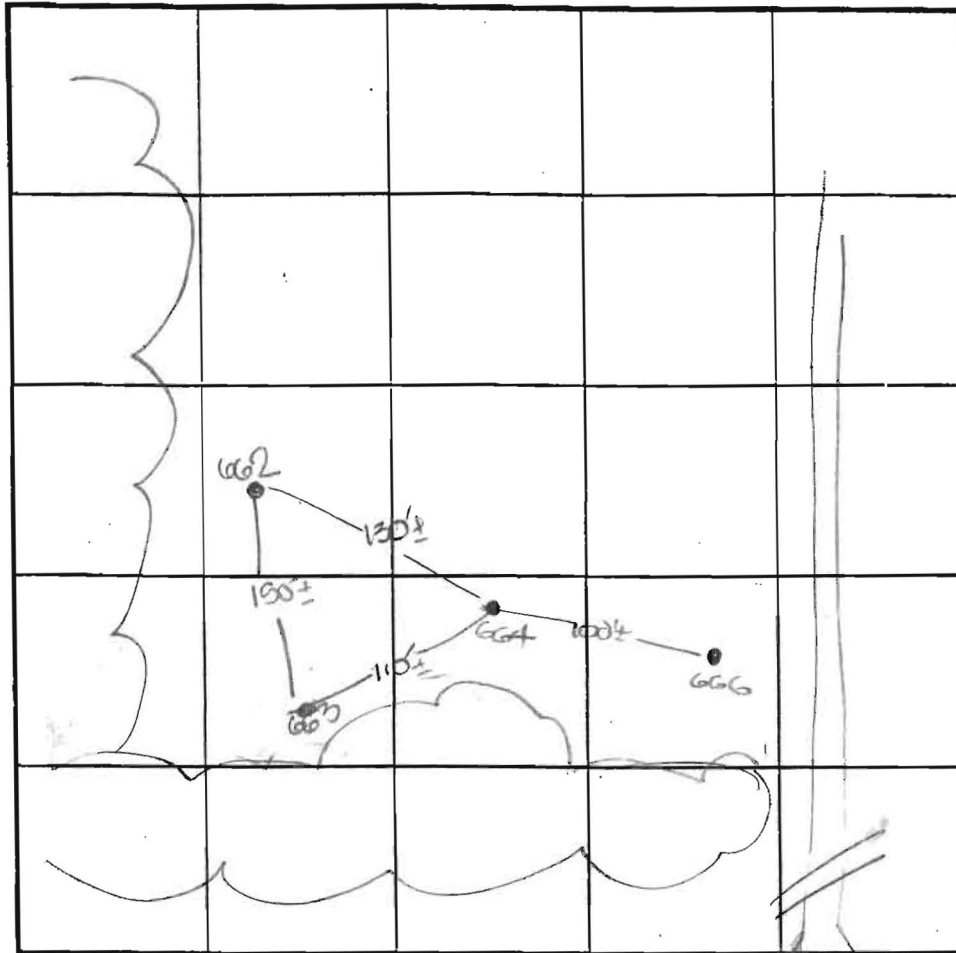

SOIL PROFILE

0' 662
 1' topsoil
 red org
 brn
 cl lm
 4'
 med
 red org
 brn
 sa mica
 lm
 10-15%
 sapr
 sh
 12'

INDICATE NORTH - NAME ADJOINING ROADWAY AS BASE LINE.

Pindel School Road

DATE	TEST NO.	DEPTH	PRE-WET		TEST - 1" DROP		TIME
			START	STOP	START	STOP	
6-30-00	662	3.5' S	2:123	2:203	2:203	2:32	12
		12.0' D	visual	- see	profile		OK
	664	13.0' D	visual	- see	profile		CL
	663	3.5' S	2:15	No movement			-
		11.5' S	visual	- see	profile		OK
	662	12.0' D	visual	- see	profile		OK
	663	4.5' M	2:38	2:49	2:49	3:18	29

REMARKS holes tested as standard

TYPE OF SOIL

TESTED BY DKS ALSO PRESENT C. Tepp, R. Colson

TRENCH DESIGN DATA: AVERAGE PERCOLATION TIME TRENCH WIDTH

INLET DEPTH MAXIMUM BOTTOM DEPTH SQ. FT./BEDROOM

0' 664
 1' topsoil
 red org
 brn
 cl lm
 3.5'
 4' pale
 org bedg
 sa mica
 lm
 10%
 sapr
 sh
 13'

0' 663
 1' topsoil
 org brn
 cl lm
 5' med
 red brn
 sa mica
 lm
 20%+
 sapr
 sh
 11.5'

COUNTY #

SOIL PROFILE

803

0'
6"

topsoil
org brn
silt loam
pale
org brn
to
pe brn
sa mica
lan
10-15%
rock

13'

SOIL PROFILE

0'



INDICATE NORTH - NAME ADJOINING ROADWAY AS BASE LINE.

DATE	TEST NO.	DEPTH	PRE-WET		TEST - 1" DROP		TIME
			START	STOP	START	STOP	
10-26-00	803	3.5' S	1:22	1:25	1:25	1:29	4
		13.0' D	visual - see		profile		OK

REMARKS holes tested as staked

TYPE OF SOIL _____

TESTED BY DCC ALSO PRESENT C. Zepp, P. Revene

TRENCH DESIGN DATA: AVERAGE PERCOLATION TIME _____ TRENCH WIDTH _____

INLET DEPTH _____ MAXIMUM BOTTOM DEPTH _____ SQ. FT/BEDROOM _____

ON THIS PLAN FOR WATER, SEWER, STORM DRAINAGE, OTHER PUBLIC UTILITIES AND FOREST CONSERVATION (DESIGNATED AS "FOREST CONSERVATION AREA"), LOCATED IN, ON, OVER AND THROUGH LOTS 1 THRU 47 AND PARCELS "A" THROUGH "F", ANY CONVEYANCES OF THE AFORESAID LOTS SHALL BE SUBJECT TO THE EASEMENTS HEREIN RESERVED, WHETHER OR NOT EXPRESSLY STATED IN THE DEED(S) CONVEYING SAID LOT(S). DEVELOPER SHALL EXECUTE AND DELIVER DEEDS FOR THE EASEMENTS HEREIN RESERVED TO HOWARD COUNTY, WITH A METES AND BOUNDS DESCRIPTION OF THE FOREST CONSERVATION AREA. UPON COMPLETION OF THE PUBLIC UTILITIES AND THEIR ACCEPTANCE BY HOWARD COUNTY, AND IN THE CASE OF FOREST CONSERVATION EASEMENT(S). UPON COMPLETION OF THE DEVELOPER'S OBLIGATIONS UNDER THE FOREST CONSERVATION INSTALLATION AND MAINTENANCE AGREEMENT EXECUTED BY DEVELOPER AND THE COUNTY, AND THE RELEASE OF DEVELOPER'S SURETY POSTED WITH SAID AGREEMENT, THE COUNTY SHALL ACCEPT THE EASEMENTS AND RECORD THE DEED(S) OF EASEMENT IN THE LAND RECORDS OF HOWARD COUNTY."

(AS SUPPLEMENTED) AS FAR AS THEY RELATE TO THE MARKING OF THIS PLAT AND THE SETTING OF MARKERS, HAVE BEEN COMPLIED WITH.


Dale Thompson 8-6-01
DALE THOMPSON, MEMBER OF MOUNT VIEW L.L.C. DATE

Clarence Carvell 8-6-01
CLARENCE CARVELL, OWNER DATE

Martha Carvell 8-6-01
MARTHA CARVELL, OWNER DATE

John C. Mellema 8-6-01
JOHN C. MELLEMA, SURVEYOR DATE

F-01-08c

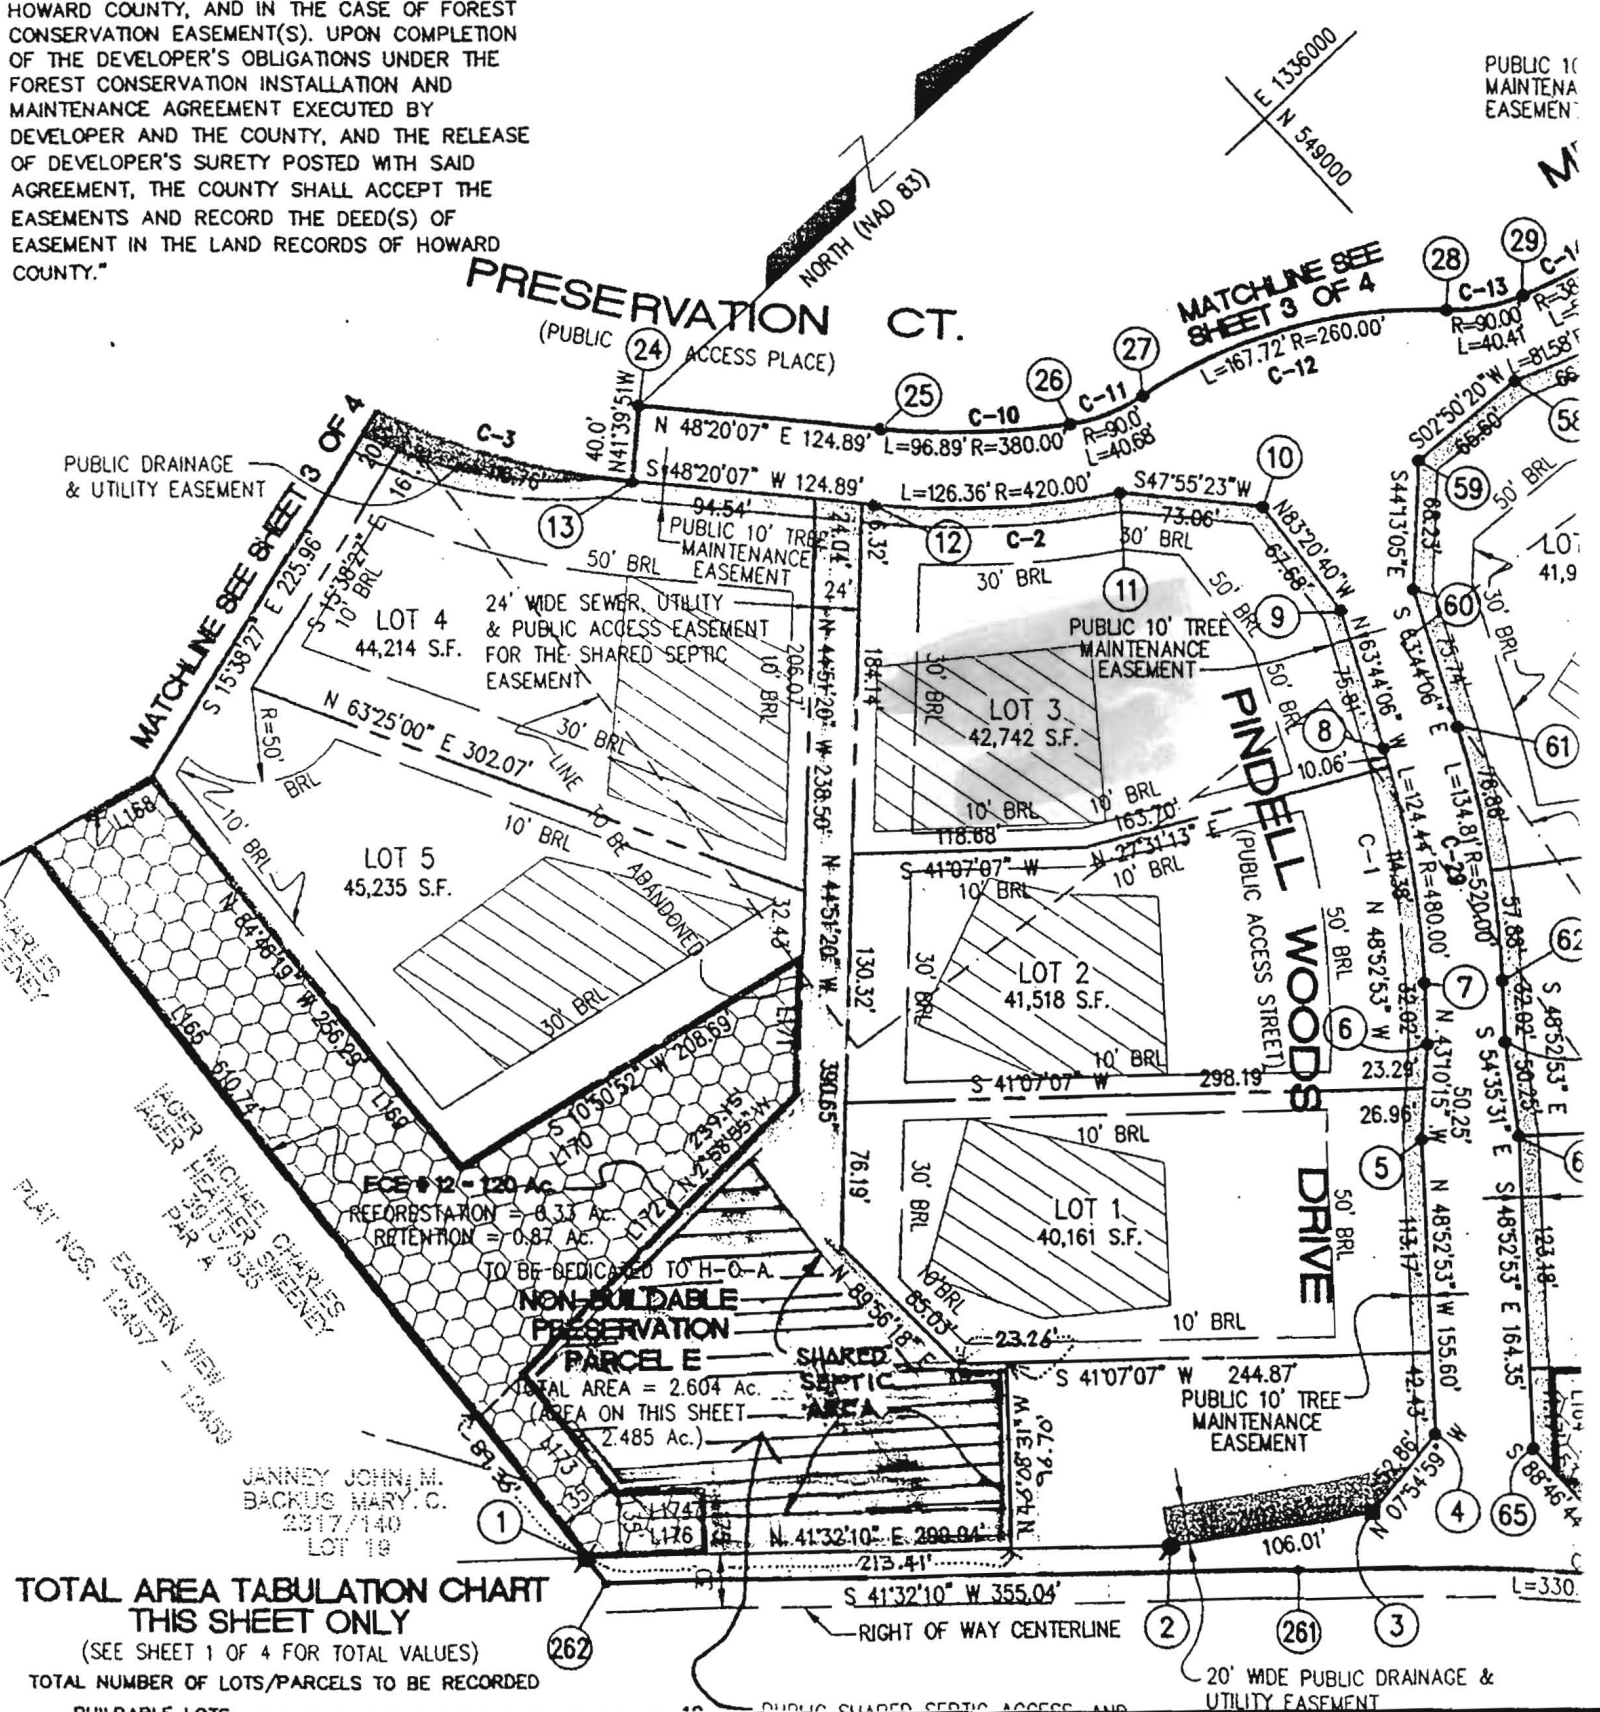

TOTAL AREA TABULATION CHART THIS SHEET ONLY
(SEE SHEET 1 OF 4 FOR TOTAL VALUES)

TOTAL NUMBER OF LOTS/PARCELS TO BE RECORDED

RECORDATION = 0.33 AC.
RETENTION = 0.87 AC.
TOTAL AREA = 2.604 AC.
(AREA ON THIS SHEET = 2.485 AC.)

JANNEY JOHN, M.
BACKUS MARY, C.
2817/140
LOT 19