

2. 50 to 75 app

APPLICATION

A 27649

P _____

SEWAGE DISPOSAL TESTING

Recorded

3/14/78
9:30 A.M.

STATE OF MARYLAND - DEPARTMENT OF HEALTH AND MENTAL HYGIENE
HOWARD COUNTY HEALTH DEPARTMENT
ENVIRONMENTAL HEALTH SERVICES
P. O. BOX 476, ELLICOTT CITY, MARYLAND 21043
TELEPHONE: 465-5000, EXT. 356

DISTRICT 5th

DATE 3/9/78

TO: THE COUNTY HEALTH OFFICER
ELLICOTT CITY, MARYLAND

I, HEREBY, APPLY FOR THE NECESSARY TEST IN ORDER TO CONSTRUCT (OR RECONSTRUCT) A SEWAGE DISPOSAL SYSTEM.

- David Southall -

*Office - Ft. Meade
688-6459*

PROPERTY OWNER

Donald T. Stivers (Seller)

Contact Purchaser David M. Southall

ADDRESS

5230 Patriot Lane, Columbia, md 21045

PHONE

997-2473

PROPERTY LOCATION:

SUBDIVISION

Braeburn

LOT NO.

1

ROAD AND DESCRIPTION

10817

direction

Braeburn Rd.

Turn right off

Cedar Lane on Braeburn Rd; lot # 1 is first on left.

SIZE OF LOT

2.57 acres

TYPE BLDG.

4 Bedrooms

NUMBER OF BEDROOMS

IF NOT SINGLE RESIDENCE DESCRIBE

House to be built in future

THE SYSTEM INSTALLED UNDER THIS APPLICATION IS ACCEPTABLE ONLY UNTIL PUBLIC FACILITIES BECOME AVAILABLE

SIGNATURE OF APPLICANT

David M. Southall

APPROVED BY

FOR

DATE

B.P. # 69895

(KIND OF SYSTEM)

REJECTED BY

FOR

DATE

(KIND OF SYSTEM)

HOLD PENDING FURTHER TESTS

DATE

AND RETURNED 6-3-85

REASONS FOR REJECTION OR HOLDING


3/14/78 HOLD FOR REVIEW RH

3/15/78 HELD FOR REVIEW PERC OK BUT DM WANTS TO DISCUSS NEW HOUSE

SITE & WELL SITE WITH SOUTHALL RH. 3/16/78

THIS IS NOT A PERMIT

CEDAR LANE

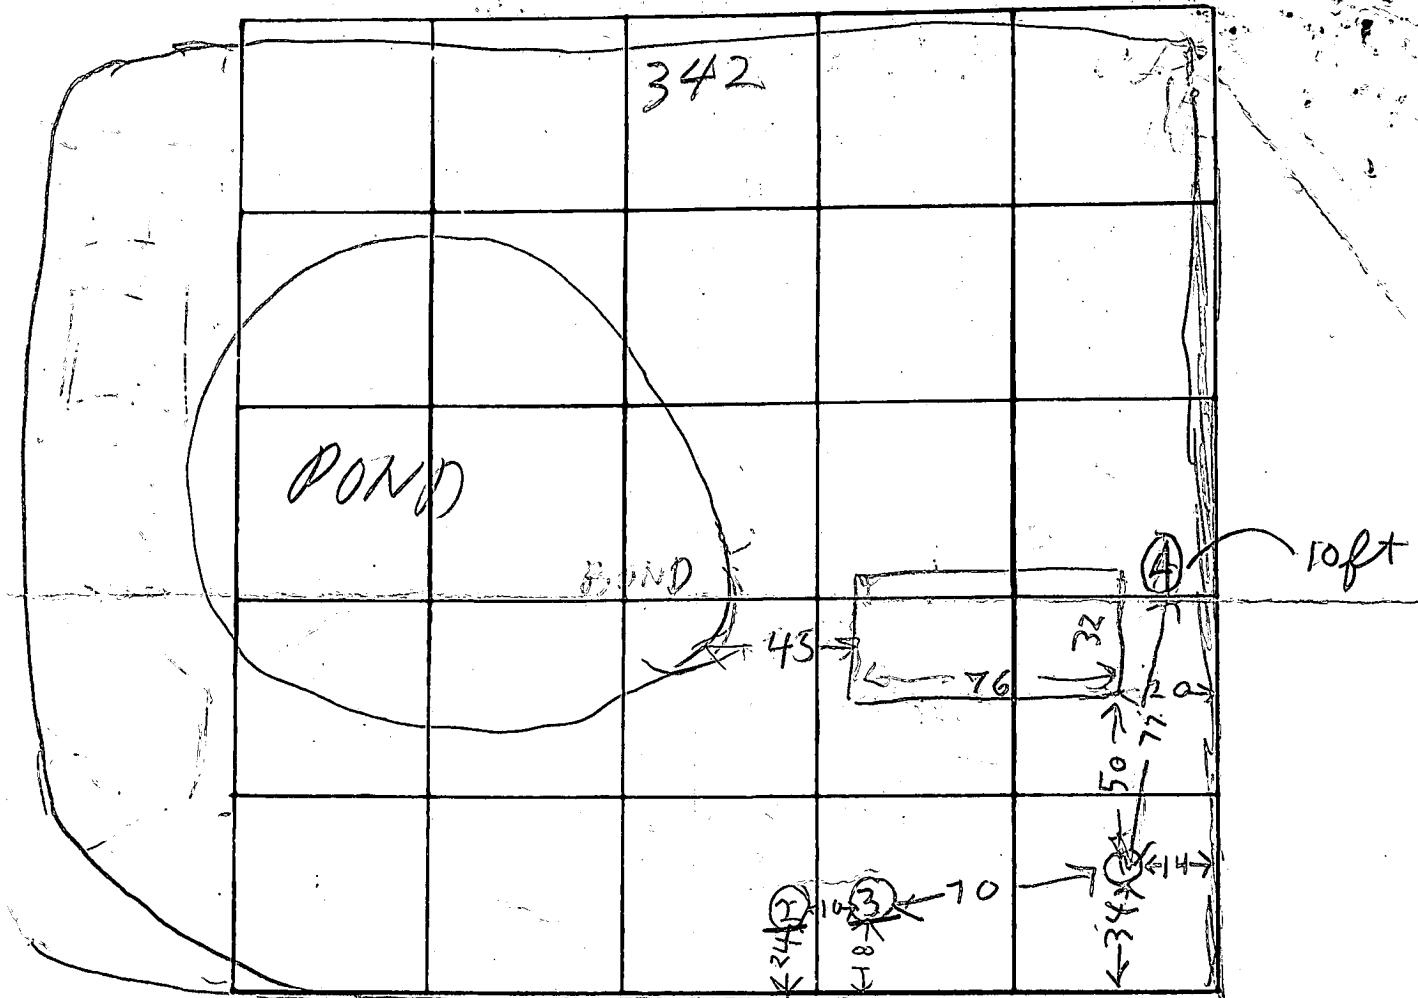

INDICATE NORTH - NAME ADJOINING ROADWAY AS BASE LINE

BRADBURN DR

DATE	TEST NO.	DEPTH	PRE-WET		TEST - 1" DROP		TIME
			START	STOP	START	STOP	
3/14/78	1 D	13	958	1020	1028	1036	16
3/14/78	1 S	3	959	1002	1002	1004	2
↑	2 S	3 1/2	1010	1012	1012	1016	4
↓	2 D	13	ALL SAND BUT WATER LEFT				
	3 D	13 1/2	ALL SAND BUT WATER LEFT				
↓	4 D	13	1039	1050	1050	1101	11
3/14/79	4 S	2 1/2	1039	1041	1041	1047	6

In 2 1/2
wat. 1.10

REMARKS _____

TYPE OF SOIL _____

TESTED BY B. HODGES

Hi EDWARDS BACKHOE
 ALSO PRESENT: MR & MRS BOYD REALE
 MR & MRS SOUTHALL