

9/24/65 - Ch. out in P.M.

Approved 9/24/65 - R.F.

PERMIT

P-10947

A-

SEWAGE DISPOSAL SYSTEM

MARYLAND STATE DEPARTMENT OF HEALTH

HOWARD COUNTY

INDEXED

ELLCOTT CITY

DISTRICT 3

DATE 9/22/65

Jenkins & Yowell IS PERMITTED TO INSTALL ALTER

ADDRESS Baltimore National Pike, E. C. PHONE 465-3876

A SEWAGE DISPOSAL SYSTEM LOCATED AT

SUBDIVISION ROAD Rt. 108 LOT

PROPERTY OWNER Ernest Miles next door to Club 108 Elloak, Maryland

ADDRESS

SPECIFICATIONS

DRAIN FIELD DEPTH FEET, BOTTOM AREA SQ. FT.

SEEPAGE PITS ABSORBENT SIDE-WALL AREA SQ. FT.

SEPTIC TANK CAPACITY GALLONS

FOR GARBAGE GRINDER, INCREASE DISPOSAL AREA 22% & TANK CAPACITY 50%.

OTHER REPAIR - 300 sq. ft. drain field

PLANS APPROVED BY DATE 9/22/65


FILL SEPTIC TANK AND DISTRIBUTION BOX WITH WATER BEFORE CALLING FOR AN INSPECTION. COVER NO WORK UNTIL INSPECTED AND APPROVED.

NEITHER THE HOWARD COUNTY COMMISSIONERS NOR THE HEALTH DEPARTMENT IS RESPONSIBLE FOR THE SUCCESSFUL OPERATION OF ANY SYSTEM.

10947

$$\begin{array}{r} 90 \\ 90 \\ \hline 180 \\ 2 \\ \hline 290 \end{array}$$

$$\begin{array}{r} 140 \\ 2.2 \\ \hline 280 \\ 290 \\ \hline 308.0 \end{array}$$

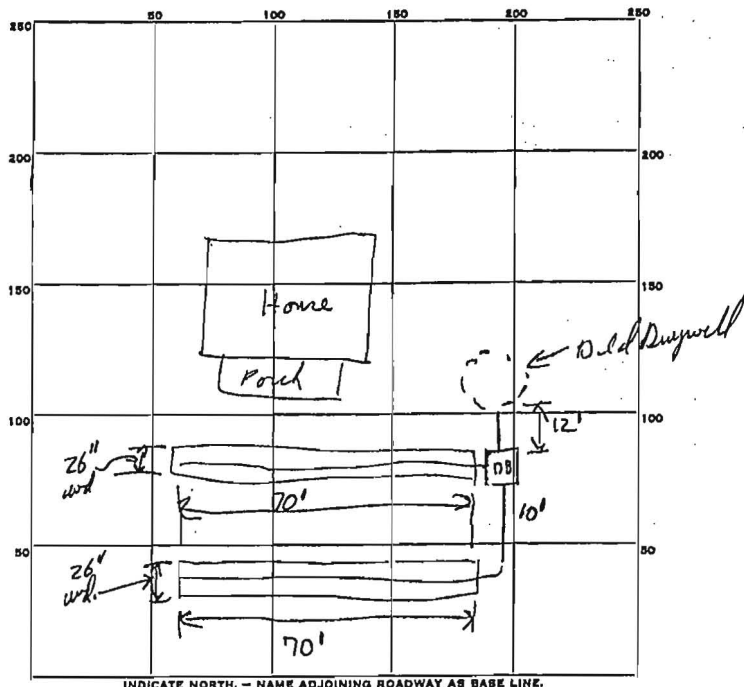

INDICATE NORTH. - NAME ADJOINING ROADWAY AS BASE LINE.

PERMIT CARD OK KT. 108
 SEPTIC TANK, LEVEL _____ CLEANOUTS _____
 DISTRIBUTION BOX, LEVEL OK
 TILE FIELD, DEPTH 3-4 FT. TRENCH WIDTH 2'-2" FT.
 GRAVEL DEPTH 13 IN. TOTAL LENGTH 140 FT.
 NUMBER OF TRENCHES 2 TOTAL BOTTOM AREA 308 sq ft.
 SEEPAGE PITS, INSIDE DIAMETER _____ FT. DEPTH BELOW INLET _____ FT.
 ABSORBENT AREA _____ SQ. FT.
 REMARKS _____

 DATE SYSTEM APPROVED 9/24/65 INSPECTOR R. F. [Signature]