

# APPLICATION

## FOR PERCOLATION TESTING AND SITE EVALUATION

Total of \$330 paid

TEST DATE(S) \_\_\_\_\_ TEST TIME \_\_\_\_\_

APP 525164

AGENCY REVIEW: \_\_\_\_\_

DATE 7/14/06

DO NOT WRITE ABOVE THIS LINE

I HEREBY APPLY FOR THE NECESSARY TESTING/EVALUATION PRIOR TO ISSUANCE OF SEWAGE DISPOSAL SYSTEM PERMIT(S) TO:

CHECK AS NEEDED:

- CONSTRUCT NEW SEPTIC SYSTEM(S)
- REPAIR/ADD TO AN EXISTING SEPTIC SYSTEM
- REPLACE AN EXISTING SEPTIC SYSTEM

CHECK AS NEEDED:

- NEW STRUCTURE(S)
- ADDITION TO AN EXISTING STRUCTURE
- REPLACE AN EXISTING STRUCTURE

CHECK ONE:

- CREATE NEW LOT(S)
- BUILD ON AN EXISTING LOT IN A SUBDIVISION
- BUILD ON AN EXISTING PARCEL OF RECORD

IS THE PROPERTY WITHIN 2500' OF ANY RESERVOIR?

- YES
- NO

THE TYPE OF STRUCTURE IS:

- RESIDENTIAL WITH 5 Brm PROPOSED BEDROOMS IN THE COMPLETED STRUCTURE (NOTE **UNKNOWN** IF APPROPRIATE)
- COMMERCIAL (PROVIDE DETAIL OF NUMBERS AND TYPES OF EMPLOYEES/ CUSTOMERS ON ACCOMPANYING PLAN)
- INSTITUTIONAL/GOVERNMENT (PROVIDE DETAIL OF NUMBERS AND TYPES OF EMPLOYEES/USERS ON ACCOMPANYING PLAN)

PROPERTY OWNER(S) Jackie Graybill

DAYTIME PHONE 410 988-9537 CELL \_\_\_\_\_ FAX \_\_\_\_\_

MAILING ADDRESS 11905 Frederick Rd Ellicott City MD 21042  
STREET CITY/TOWN STATE ZIP

APPLICANT Fogle's Septic

DAYTIME PHONE 410 795-5670 CELL \_\_\_\_\_ FAX \_\_\_\_\_

MAILING ADDRESS 580 Obrecht Rd Sykesville MD 21784  
STREET CITY/TOWN STATE ZIP

APPLICANT'S ROLE: DEVELOPER BUILDER BUYER RELATIVE/FRIEND REALTOR CONSULTANT

PROPERTY LOCATION  
SUBDIVISION/PROPERTY NAME 11905 Frederick Rd LOT NO. \_\_\_\_\_

PROPERTY ADDRESS Same TOWN/POST OFFICE \_\_\_\_\_  
STREET

TAX MAP PAGE(S) \_\_\_\_\_ GRID \_\_\_\_\_ PARCEL(S) \_\_\_\_\_ PROPOSED LOT SIZE \_\_\_\_\_

AS APPLICANT, I UNDERSTAND THE FOLLOWING: THE SYSTEM INSTALLED SUBSEQUENT TO THIS APPLICATION IS ACCEPTABLE ONLY UNTIL PUBLIC SEWERAGE IS AVAILABLE. THIS APPLICATION IS COMPLETE WHEN ALL APPLICABLE FEES AND A SUITABLE SITE PLAN HAVE BEEN RECEIVED. I ACCEPT THE RESPONSIBILITY FOR COMPLIANCE WITH ALL M.O.S.H.A. AND "MISS UTILITY" REQUIREMENTS. APPROVAL IS BASED UPON SATISFACTORY REVIEW OF A PERC CERTIFICATION PLAN.

TEST RESULTS WILL BE MAILED TO APPLICANT. Rand A. Casell  
SIGNATURE OF APPLICANT

HOWARD COUNTY HEALTH DEPARTMENT, BUREAU OF ENVIRONMENTAL HEALTH, WELL AND SEPTIC PROGRAM  
7178 COLUMBIA GATEWAY DRIVE COLUMBIA, MARYLAND 21046 (410) 313-2640 FAX (410) 313-2648  
TDD (410) 313-2323 TOLL FREE 1-877-4MD-DHMH

A/P

(A)

3-4' Dense Brown  
Silt/clay  
loam  
trace rock


8' Dense Light  
Br silt Loam  
Trace Rock

17' Light Br.  
Sa. Loam  
~10%  
Rock and  
Saprolite  
Dry

(B)

3.5'-4.5' Dense Br.  
Si Cl. Loam  
25-30%  
Rock

14' Light Br  
Sa Loam  
5-10%  
Saprolite

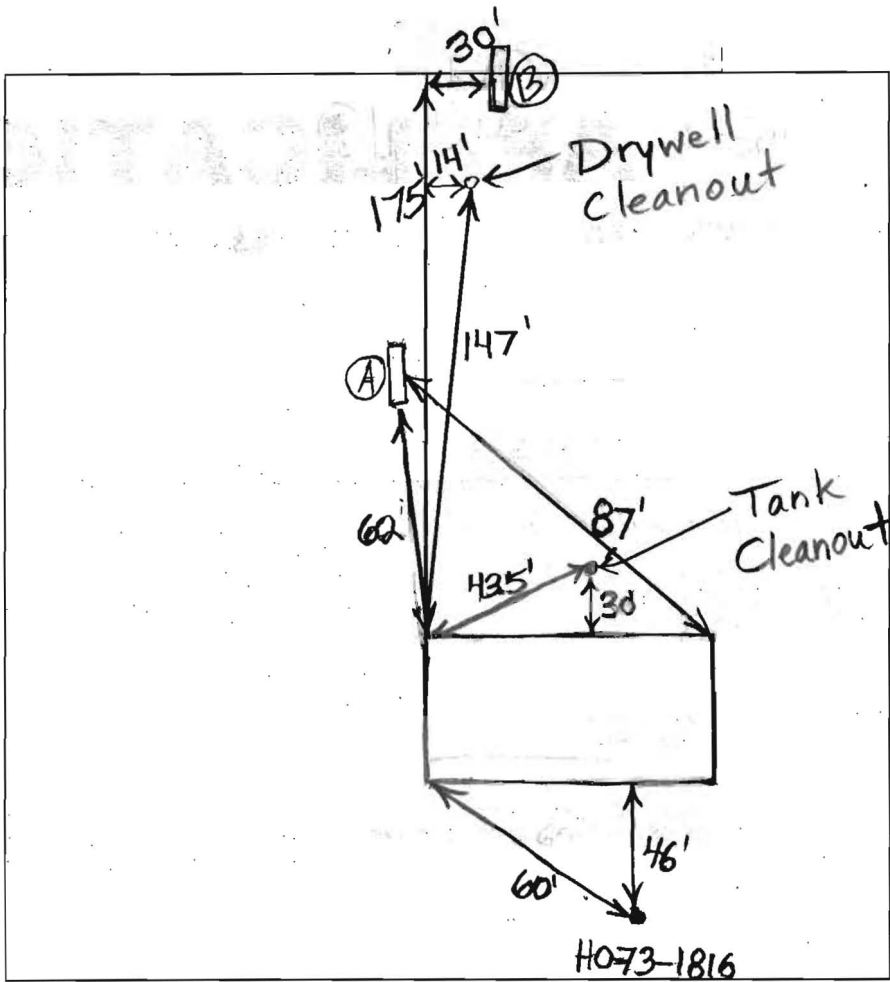

DATE	TEST #	DEPTH	START	BREAK 1" DROP	STOP 2" DROP	TIME OF 2ND INCH	P/F/H
7/26/2006	A	17'V					P
7/26/2006	B	14'V					P

REMARKS Water Poured in Bottom of Hole B - rate O.K.

SANITARIAN B. Baker/K. Wolf BACKHOE Fogles OTHERS \_\_\_\_\_

TEST HOLES USED IN SDA \_\_\_\_\_ AVG. PERC TIME \_\_\_\_\_ SQ. FT/BR \_\_\_\_\_

TRENCH WIDTH \_\_\_\_\_ INLET DEPTH \_\_\_\_\_ MAX. BOT DEPTH \_\_\_\_\_ EFFECTIVE S/W \_\_\_\_\_

# APPLICATION

A 18784

## SEWAGE DISPOSAL TESTING

P \_\_\_\_\_

STATE OF MARYLAND - DEPARTMENT OF HEALTH AND MENTAL HYGIENE

HOWARD COUNTY HEALTH DEPARTMENT  
ENVIRONMENTAL HEALTH SERVICES

DISTRICT THIRD ELEC.

P. O. BOX 476, ELLICOTT CITY, MARYLAND 21043  
TELEPHONE: 485-5000, EXT. 356

DATE JULY 25, 1973

TO: THE COUNTY HEALTH OFFICER  
ELLICOTT CITY, MARYLAND

I, HEREBY, APPLY FOR THE NECESSARY TEST IN ORDER TO CONSTRUCT (OR RECONSTRUCT) A SEWAGE DISPOSAL SYSTEM.

PROPERTY OWNER ✓ FERDINAND P. KELLY

ADDRESS ✓ 2508 NORTH CALVERT ST., BALTO., MD. PHONE ✓ 889-2613

### PROPERTY LOCATION:

SUBDIVISION ✓ MAYFIELD MANOR LOT NO. ✓ 18

ROAD AND DESCRIPTION direction ✓ SOUTH SIDE OF FREDERICK RD. (RT. #144) APPROX. ONE QUARTER MILE WEST OF INTERSECTION OF FREDERICK & TRIDELPHIA ROADS.

SIZE OF LOT ✓ 5.799 ACRES TYPE BLDG. ✓ FIVE  
NUMBER OF BEDROOMS \_\_\_\_\_

IF NOT SINGLE RESIDENCE DESCRIBE \_\_\_\_\_

THE SYSTEM INSTALLED UNDER THIS APPLICATION IS ACCEPTABLE ONLY UNTIL PUBLIC FACILITIES BECOME AVAILABLE.

SIGNATURE OF APPLICANT ✓ Floyd Kenneth Grubill, II (727-7240)

APPROVED BY \_\_\_\_\_ FOR \_\_\_\_\_ DATE \_\_\_\_\_  
(KIND OF SYSTEM)

REJECTED BY \_\_\_\_\_ FOR \_\_\_\_\_ DATE \_\_\_\_\_  
(KIND OF SYSTEM)

HOLD PENDING FURTHER TESTS \_\_\_\_\_ DATE \_\_\_\_\_

REASONS FOR REJECTION OR HOLDING \_\_\_\_\_

# THIS IS NOT A PERMIT

# APPLICATION


INDICATE NORTH - NAME ADJOINING ROADWAY AS BASE LINE

DATE	TEST NO.	DEPTH	PRE-WET		TEST - 1" DROP		TIME
			START	STOP	START	STOP	
8/17/73	1	11	200	515	247	248	
	2	5"	245	247	247	248	1
	3	11	247	248	248	250	2
	4	11	TOP OF 7" F7 SAND		7" F7 SAND		
	5	4 1/2	302	302	302	304	2
8/17/73	6	11	200	515	247	248	

all sand  
all sand

REMARKS \_\_\_\_\_

TYPE OF SOIL \_\_\_\_\_