

PUB. SEWER STATUS VERIFIED BY _____

ISSUE DATE: 7/19/06

APPROVAL DATE: 7/20/06

PERMIT

INDEXED

TAX ID# 04-335422

ON-SITE SEWAGE DISPOSAL SYSTEM HOWARD COUNTY HEALTH DEPARTMENT BUREAU OF ENVIRONMENTAL HEALTH

P 525172

A REPAIR

Hatfields Equipment IS PERMITTED TO INSTALL ALTER

ADDRESS: PO Box 519, Annapolis Junction 20701 PHONE NUMBER: 301-854-6172

SUBDIVISION: Glenwood Estates LOT NUMBER: 10

ADDRESS: 14652 Mustang Path PROPERTY OWNER: Abbie Thompson

SEPTIC TANK CAPACITY (GALLONS):	<u>Existing</u>	- Trench 3' Wide
PUMP CHAMBER CAPACITY (GALLONS):	<u>N/A</u>	- Inlet 4.5'
NUMBER OF BEDROOMS:	<u>4</u>	- Bottom 6'
SQUARE FEET PER BEDROOM:	<u>180</u>	- 1.5' of Gravel Below
LINEAR FEET OF TRENCH REQUIRED:	<u>200</u>	Pipe

TRENCHES:	Trench to be _____ feet wide. Inlet _____ feet below original grade. Bottom maximum depth _____ feet below original grade. Effective area begins at _____ feet below original grade. _____ feet of stone below distribution pipe.
LOCATION:	<u>Locations are Staked in Back Yard (Trenches)</u> <u>Can Keep Drywell if Filled With Gravel</u>
PURPOSE:	Existing septic system has failed. Call for inspection when ground is opened so sanitarian can recommend repair.


PLANS APPROVED: _____ DATE: _____

- NOTE: PERMIT VOID AFTER 2 YEARS
- NOTE: CONTRACTOR RESPONSIBLE FOR SCHEDULING A PRE-CONSTRUCTION INSPECTION FOR ALL INSTALLATIONS
- NOTE: WATERTIGHT SEPTIC TANKS REQUIRED
- NOTE: ALL PARTS OF SEPTIC SYSTEM SHALL BE 100 FEET FROM ANY WATER WELL
- NOTE: MANHOLE RISERS REQUIRED ON ALL SEPTIC TANKS AND PUMP CHAMBERS

NEITHER THE HOWARD COUNTY COUNCIL OR THE HEALTH DEPARTMENT IS RESPONSIBLE FOR THE SUCCESSFUL OPERATION OF ANY SYSTEM PERMITTEE RESPONSIBLE FOR OBTAINING FINAL APPROVAL ON THIS PERMIT CALL 410-313-2640 FOR INSPECTION OF SEPTIC SYSTEM

P525172

NOT TO SCALE

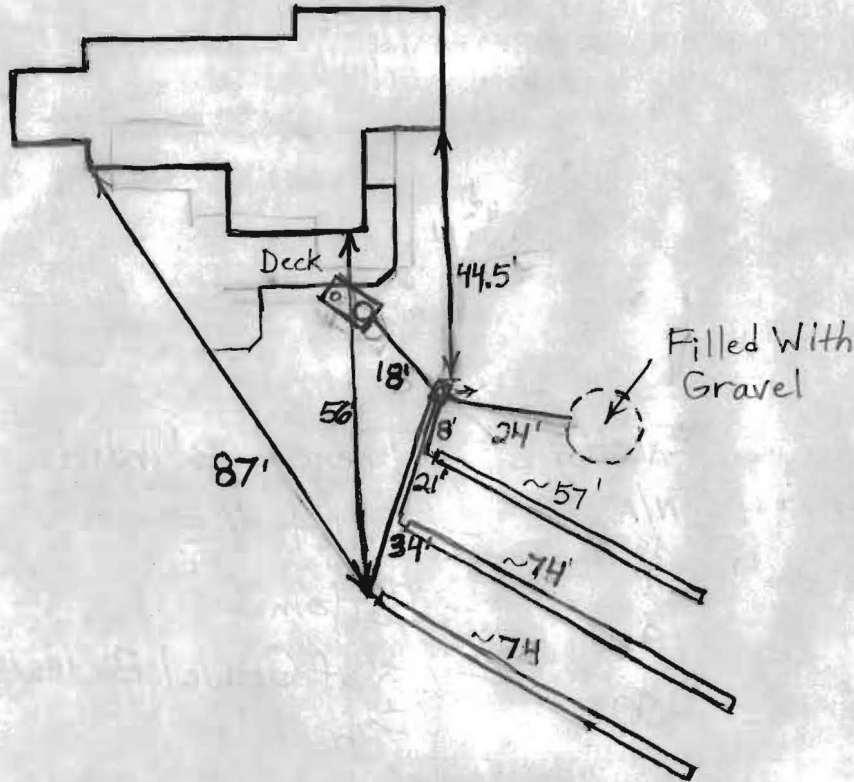

TRENCH/DRAINFIELD DATA		
WIDTH	INLET	BOTTOM
3'	4.5	6'
NUMBER OF TRENCHES		3
TOTAL LENGTH		~205'
ABSORPTION AREA		615 + Sidewall
DISTRIBUTION BOX LEVEL		Levelers
DISTRIBUTION BOX BAFFLE		Yes
DISTRIBUTION BOX PORT		Yes

SEPTIC TANK DATA	
SEPTIC TANK 1 LEVEL	Yes
CAPACITY	Existing GAL
SEAM LOC	Midseam
TANK LID DEPTH	2.5'-3.5'
BAFFLES	Yes
BAFFLE FILTER	No
MANHOLE LOC	Rear
6" PORT LOC	Front
WATERTIGHT TEST	No
SEPTIC TANK 2 LEVEL	N/A
CAPACITY	GAL
SEAM LOC	
TANK LID DEPTH	
BAFFLES	
BAFFLE FILTER	
MANHOLE LOC	
6" PORT LOC	
WATERTIGHT TEST	

PRE-CONSTRUCTION 7/11/06 Trench layout done. I install one shorter trench on contour towards cedar tree then 2 longer trenches directly below it. (BB)

7/20/06 System installed. Drywell filled with gravel. O.K. to backfill. (BB)

FINAL INSPECTOR B. Baker

DATE OF APPROVAL 7/20/06