

DATE RECEIVED (WHERE APPLICABLE) June 15 1971 DEPTH OF WELL 130 PERMIT NO. FROM "PERMIT TO DRILL WELL" 100-111-111

OWNER Goehring STREET OR RFD 7702 Branchley POST OFFICE Randall's Town, Md

WELL LOG: STATE THE KIND OF FORMATIONS PENETRATED, THEIR COLOR, DEPTH, THICKNESS AND IF WATER BEARING.

DESCRIPTION (USE ADDITIONAL SHEETS IF NECESSARY)	FEET		CHECK OFF (WATER BEARING)
	FROM	TO	
<u>1.5 ft. sand</u>		<u>79</u>	
<u>Hard gray R. L.</u>	<u>79</u>	<u>130</u>	

**GROUTING RECORD**  
 WELL HAS BEEN GROUTED (CIRCLE APPROPRIATE BOX)  G  N  
 TYPE OF GROUTING MATERIAL (CIRCLE BOX):  
 CEMENT  C M  B C  
 NO. OF BAGS 24 NO. OF POUNDS 225  
 BALLONS OF WATER 1.44  
 DEPTH OF GROUT SEAL (TO NEAREST FOOT):  
 FROM 0 FT. TO 81 FT.  
 (ENTER 0 IF FROM SURFACE)

**CASING RECORD**  
 CASING TYPES (CIRCLE APPROPRIATE CODE BELOW):  
 S T  P L  C O  O T  
 STEEL PLASTIC CONCRETE OTHER  
 MAIN CASING TYPE: S T NOMINAL DIAMETER TOP (INCH): 6 TOTAL DEPTH OF MAIN CASING (NEAREST FOOT): 82

**OTHER CASING (IF USED)**  
 DIAMETER (INCH) \_\_\_\_\_ DEPTH (FEET) FROM \_\_\_\_\_ TO \_\_\_\_\_

**SCREEN RECORD**  
 SCREEN TYPE OR OPEN HOLE (CIRCLE APPROPRIATE CODE BELOW):  
 S T  B R  O P  
 STEEL BRASS OR COPPER OPEN HOLE  
 P L  O T  
 PLASTIC OTHER

**DEPTH (NEAREST WHOLE FOOT):**  
 FROM 81 TO 130  
 1 81 15 17 21  
 2 89 23 24 28 30 32 36  
 3 97 38 41 45 47 51  
 SLOT SIZE 1. \_\_\_\_\_ 2. \_\_\_\_\_ 3. \_\_\_\_\_


DIAMETER OF SCREEN \_\_\_\_\_ (NEAREST INCH)  
 FROM \_\_\_\_\_ TO \_\_\_\_\_  
 BRAVEL PACE \_\_\_\_\_  
 IF WELL DRILLED WAS A FLOWING WELL (CIRCLE BOX)  F  P  
 (FOR USE ONLY - NOT TO BE FILLED IN BY DRILLER)  
 TELESCOPE CASING  T  W  O  
 LOG INDICATOR  72  74  76  78  
 OTHER DATA AVAILABLE

**PUMPING TEST**  
 HOURS PUMPED (TO NEAREST HOUR) 3  
 PUMPING RATE (GALLONS PER MINUTE TO NEAREST GALLON) 7  
 METHOD USED TO MEASURE PUMPING RATE Gal Bucket  
 WATER LEVEL (DISTANCE FROM LAND SURFACE):  
 BEFORE PUMPING 45 (NEAREST FOOT)  
 AFTER PUMPING 90 (NEAREST FOOT)

**TYPE OF PUMP USED (CIRCLE APPROPRIATE BOX) (FOR PUMPING TEST)**  
 S  P  T  C  R  O  
 CENTRIFUGAL PISTON TURBINE  
 J  B  O  
 JET SUBMERSIBLE OTHER (DESCRIBE BELOW)

**PUMP INSTALLED**  
 TYPE OF PUMP (ENTER APPROPRIATE LETTER IN BOX - SEE ABOVE: A, C, J, P, R, S, T, O) 20  
 DRILLER WILL INSTALL PUMP (CIRCLE APPROPRIATE BOX)  Y  N  
 CAPACITY: \_\_\_\_\_  
 GALLONS PER MINUTE (TO NEAREST GALLON) \_\_\_\_\_  
 PUMP HORSE POWER \_\_\_\_\_  
 PUMP COLUMN LENGTH (NEAREST FOOT) 49 47

**CASING HEIGHT (CIRCLE APPROPRIATE BOX AND ENTER CASING HEIGHT):**  
 F ABOVE } LAND SURFACE  
 B BELOW } (NEAREST FOOT)  
48 51

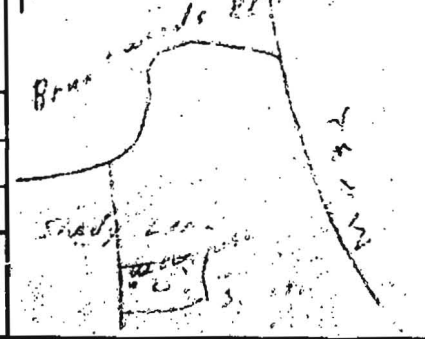

**CIRCLE APPROPRIATE BOXES**  
 A WELL WAS ABANDONED AND SEALED WHEN THIS WELL WAS COMPLETED  
 E ELECTRIC LOG OBTAINED  
 P TEST WELL CONVERTED TO PRODUCTION WELL  
 I HEREBY CERTIFY THAT I HAVE COMPLIED WITH ALL CONDITIONS STATED IN THE ABOVE-CAPTIONED "PERMIT TO DRILL WELL", AND THAT INFORMATION CONTAINED IN THIS REPORT IS TRUE, ACCURATE, AND COMPLETE TO THE BEST OF MY KNOWLEDGE, INFORMATION AND BELIEF.  
 DRILLER'S NAME \_\_\_\_\_  
 (PLEASE PRINT) John W. ...  
 SIGNATURE John W. ...

8-7-87 Septic tank cleanout was buried. Drywell cleanout located approximately 49 feet from front of septic tank. Used installation sketch to locate approximate front of septic tank. Tank appears to be about 26.5 feet from the house-garage wall. Will be underneath the addition and deck. Deck over the septic tank. Recommend disapproval. J.E. Nadeau

NORTH  
 9-1-87  
 Deck may have to be lowered  
 (SA)  
 9-1-87  
 Deck 26.5' 18-24'  
 OFF GROUND, C/O ACCESS  
 ITS DESIGNER. ONLY PROBLEM  
 SHOULD BE W/ TRAIL PROVISION.  
 WITH A LETTER FROM OWNER  
 BRING NUMBER THAT IS  
 THEY NEED APPROVAL  
 (REPLYMENT THAT THE  
 DECK MAY HAVE TO BE LOWERED  
 10' 4" 11'  
 NEW CK TO EIGHT (SA)

S 67° 44' 38" W 569.80'

