

10/31/77  
as soon as possible

# PERMIT

27034  
21057  
19184  
F.C.O.

SEWAGE DISPOSAL SYSTEM

MARYLAND STATE DEPARTMENT OF HEALTH

HOWARD COUNTY

ELLICOTT CITY

DISTRICT 4th

DATE 10/11/77

## INDEXED

Jack Rynck IS PERMITTED TO INSTALL  ALTER

ADDRESS 13775 Triadelphia Road, Cispark, Md. PHONE \_\_\_\_\_

A SEWAGE DISPOSAL SYSTEM LOCATED AT \_\_\_\_\_

SUBDIVISION Glenwood Estates ROAD 14652 Mustang Path LOT 10, Sec. 1

PROPERTY OWNER John Cochrane

ADDRESS 9702 Branchley Road, Randallstown, Md. 21133

SPECIFICATIONS 3 bedrooms

DRAIN FIELD \_\_\_\_\_ DEPTH \_\_\_\_\_ FEET, BOTTOM AREA \_\_\_\_\_ SQ. FT.

SEEPAGE PITZ \_\_\_\_\_ ADSORBENT SIDE-WALL AREA \_\_\_\_\_ SQ. FT.

SEPTIC TANK CAPACITY 1000 GALLONS

FOR GARBAGE GRINDER, INCREASE DISPOSAL AREA 25% & TANK CAPACITY 50%.

**OTHER DRY WELL AND TRENCH** - Dry well to have 300 sq. ft. effective sidewall area. Inlet at 4 ft. and maximum depth 9 1/4 ft. below original grade. Effective depth starts at 4 1/4 ft. Locate dry well 75 ft. from the left lot line and 125 ft. from the front lot line as seen when facing lot from road. Trench to be ~~36 ft.~~ 36 ft. long for a total sidewall area of 180 sq. ft. Inlet to trench at 4 1/4 ft. (effective depth begins at 4 1/4 ft.) and maximum depth 9 1/4 ft. Come off left rear of dry well, run trench towards left rear portion of lot. Follow contour to keep trench level. NOTE: CALL FOR INSPECTION OF TRENCH BEFORE PLACING STONE IN TRENCH. NOTE: ALL PIPE FROM HOUSE TO DISPOSAL AREA MUST BE CAST IRON. PERMIT VOID AFTER THREE YEARS. NOTE: INSTALL STAND PIPE ON SEPTIC TANK AND DRY WELL. STAND PIPES MUST BE 6 INCHES IN DIAMETER. CAST IRON, CONCRETE OR TERRA


PLANS APPROVED BY William W. Zepp DATE 5/31/77

COTTA ACCEPTED.

FILL SEPTIC TANK AND DISTRIBUTION BOX WITH WATER BEFORE CALLING FOR AN INSPECTION. COVER NO WORK UNTIL INSPECTED AND APPROVED.

NEITHER THE HOWARD COUNTY COMMISSIONERS NOR THE HEALTH DEPARTMENT IS RESPONSIBLE FOR THE SUCCESSFUL OPERATION OF ANY SYSTEM.

BLDG. PERMIT SIGNED  
AND RETURNED 11/22/77  
Serial # 57547  
Summan

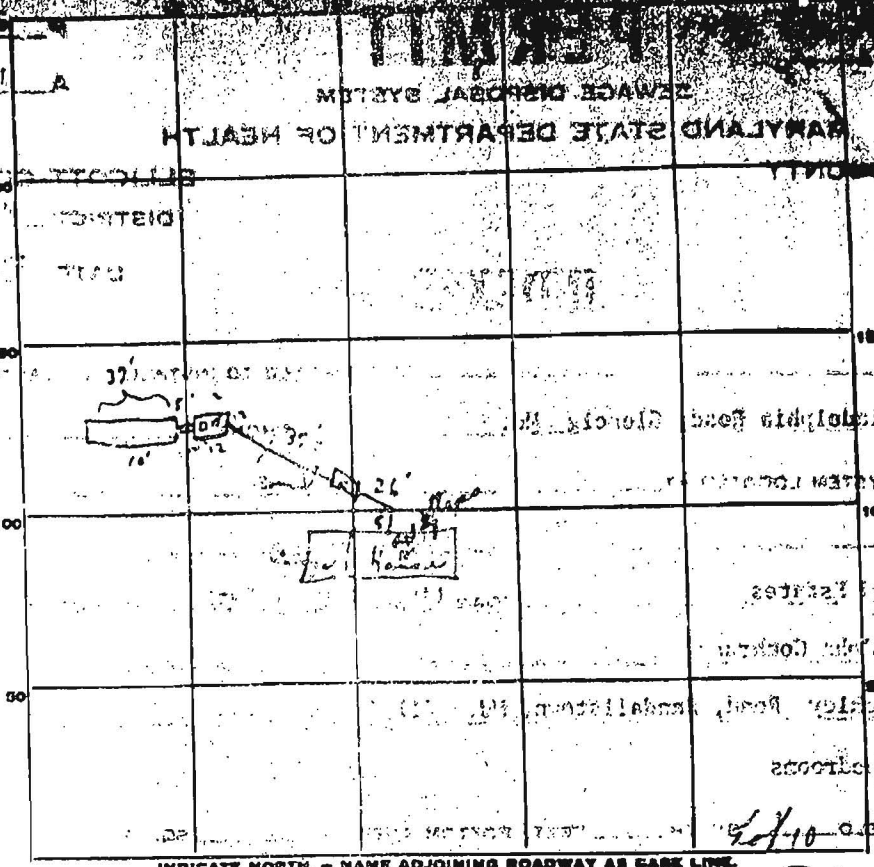

INDICATE NORTH. - NAME ADJOINING ROADWAY AS CASE LINE.

PERMIT CARD

No. 10

SEPTIC TANK, LEVEL

ok

CLEANOUTS

ok

DISTRIBUTION BOX, LEVEL

N/A

TILE FIELD, DEPTH

10

TRENCH WIDTH

GRAVEL DEPTH

7

TOTAL LENGTH

37

NUMBER OF TRENCHES

1

TOTAL BOTTOM AREA

SEEPAGE PITS, INSIDE DIAMETER

48 1/2

DEPTH

26

ABSORBENT AREA

574 SQ. FT.

REMARKS

10/31/77 Septic tank only, 0 Entire system  
Note: see - area - some - pipe - work - present - at - property

DATE SYSTEM APPROVED

10/31/77

INSPECTOR

C. B. Thacker