


U.S. Hwy
A-3, A-4
100 ft

E = 12 min

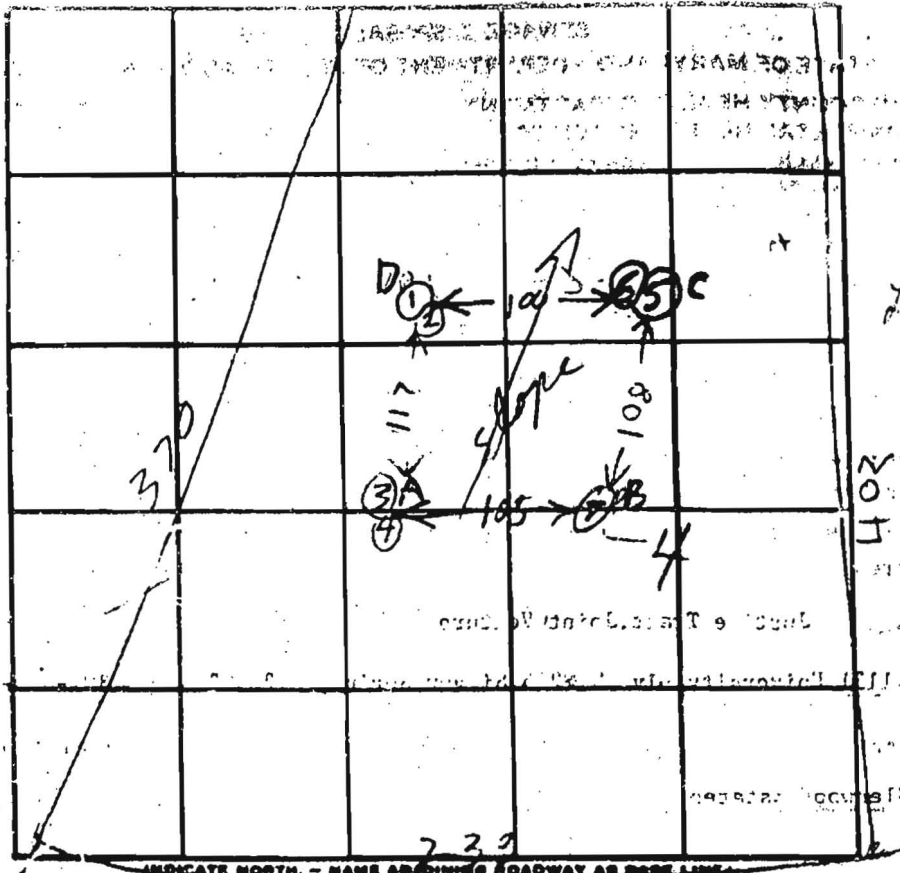

INDICATE NORTH - NAME ADJOINING ROADWAY AS BORE LINE

ELEVATION

DATE	TEST NO.	DEPTH	PRE-WET		TEST - 1" DROP		TIME	NEXT LOWEST
			START	STOP	START	STOP		
8/11/74	D1	4	147	152	152	200	8	26
	D2	12	147	202	202	210	18	
	A3	4 1/2	214	218	218	2:28	10	HIGHEST USE DN
	A4	12	210	214	214	2:22	8	18
	C5	4	2:36	239	239	257	18	LOWEST
	C6	12	2:34	2:40	2:40	245	5	23
9/11/74	B7	11	Visual; sim to A3;		dry			NEXT HIGHER

REMARKS SEE PLAN FOR LOCATION HOLES; ABCD
HIGHEST TOP OF Lot 11