

Building Address: 3230 Hayloft Ct
Woodbine MD 21797

Suite/Apt. # _____ SDP/WP/BA #: _____
 Census Tract: _____ Subdivision: Cabin Branch Farm
 Section: _____ Area: _____ Lot: 50
 Tax Map: 13 Parcel: 42 Grid: 19
 Zoning: _____ Map Coordinates: _____ Lot Size: 3.19

Existing Use: SFD
 Proposed Use: Inground pool

Estimated Construction Cost: \$ 29,999
 Description of Work: 22' X 44' inground concrete pool, depth 3' to 8', fence to code, filled by truck

Occupant or Tenant: _____
 Was tenant space previously occupied? Yes No

Contact Name: _____
 Address: _____
 City: _____ State: _____ Zip Code: _____
 Phone: _____ Fax: _____
 Email: _____

Property Owner's Name: Carroll Kline
 Address: 3230 Hayloft Ct

City: Woodbine State: MD Zip Code: 21797
 Home Phone: 4104892883 Work Phone: _____

Applicant's Name & Mailing Address, (If other than stated herein):
Karen Rowley
293 Southland Ct DunKort 2075
 Phone: 4105077705 Fax: _____

Email: _____

Contractor Company: Catalina Pools
 Contact Person: Karen Rowley
 Address: 836 Suite 8 Ritchie Hwy
 City: Severna Park Zip Code: 21146
 License no.: 126289

Phone: _____ Fax: _____
 Email: _____

Engineer/Architect Company: _____
 Responsible Design Prof.: _____

Address: _____
 City: _____ State: _____ Zip Code: _____
 Phone: _____ Fax: _____
 Email: _____

BUILDING DESCRIPTION - COMMERCIAL

Building Characteristics	Utilities
Height:	<u>Water Supply</u>
No. of stories:	<input type="checkbox"/> Public
Gross area, sq. ft./floor:	<input type="checkbox"/> Private
	<u>Sewage Disposal</u>
Area of construction (sq. ft.):	<input type="checkbox"/> Public
	<input type="checkbox"/> Private
Use group:	Electric: <input type="checkbox"/> Yes <input type="checkbox"/> No
	Gas: <input type="checkbox"/> Yes <input type="checkbox"/> No
<u>Construction type:</u>	<u>Heating System</u>
<input type="checkbox"/> Reinforced Concrete	<input type="checkbox"/> Electric <input type="checkbox"/> Oil
<input type="checkbox"/> Structural Steel	<input type="checkbox"/> Natural Gas <input type="checkbox"/> Propane Gas
<input type="checkbox"/> Masonry	<u>Sprinkler System:</u>
<input type="checkbox"/> Wood Frame	<input type="checkbox"/> N/A
<input type="checkbox"/> State Certified Modular	<input type="checkbox"/> Full
<input checked="" type="checkbox"/> <u>Roadside Tree Project Permit</u>	<input type="checkbox"/> Partial
<input type="checkbox"/> Yes <input type="checkbox"/> No	<input type="checkbox"/> Other Suppression
<u>Roadside Tree Project Permit #</u>	No. of Heads:

BUILDING DESCRIPTION - RESIDENTIAL

Building Characteristics	Utilities
<input type="checkbox"/> SF Dwelling <input type="checkbox"/> SF Townhouse	<u>Water Supply</u>
<u>Depth</u> <u>Width</u>	<input type="checkbox"/> Public
1 st floor:	<input checked="" type="checkbox"/> Private
2 nd floor:	<u>Sewage Disposal</u>
Basement:	<input type="checkbox"/> Public
<input type="checkbox"/> Finished Basement	<input checked="" type="checkbox"/> Private
<input type="checkbox"/> Unfinished Basement	Electric: <input checked="" type="checkbox"/> Yes <input type="checkbox"/> No
<input type="checkbox"/> Crawl Space	Gas: <input type="checkbox"/> Yes <input checked="" type="checkbox"/> No
<input type="checkbox"/> Slab on Grade	<u>Heating System</u>
No. of Bedrooms:	<input type="checkbox"/> Electric
<u>Multi-family Dwelling</u>	<input type="checkbox"/> Oil
No. of efficiency units:	<input type="checkbox"/> Natural Gas
No. of 1 BR units:	<input type="checkbox"/> Propane Gas
No. of 2 BR units:	
No. of 3 BR units:	
Other Structure:	
Dimensions:	
Footings:	<input checked="" type="checkbox"/> <u>Roadside Tree Project Perm</u>
Roof:	<input type="checkbox"/> Yes <input checked="" type="checkbox"/> No
<input type="checkbox"/> State Certified Modular	<u>Roadside Tree Project Permit #</u>
<input type="checkbox"/> Manufactured Home	

THE UNDERSIGNED HEREBY CERTIFIES AND AGREES AS FOLLOWS: (1) THAT HE/SHE IS AUTHORIZED TO MAKE THIS APPLICATION; (2) THAT THE INFORMATION IS CORRECT; (3) THAT HE/SHE WILL COMPLY WITH ALL REGULATIONS OF HOWARD COUNTY WHICH ARE APPLICABLE THERETO; (4) THAT HE/SHE WILL PERFORM NO WORK ON THE ABOVE REFERENCED PROPERTY NOT SPECIFICALLY DESCRIBED IN THIS APPLICATION; (5) THAT HE/SHE GRANTS COUNTY OFFICIALS THE RIGHT TO ENTER ONTO THE PROPERTY FOR THE PURPOSE OF INSPECTING THE WORK PERMITTED AND POSTING NOTICES.

Karen Rowley
 Applicant's Signature

Karen Rowley
 Print Name

Agent Catalina Pools
 Email Address
 Title/Company

8/7/2014
 Date

Checks Payable to: DIRECTOR OF FINANCE OF HOWARD COUNTY

PLEASE WRITE NEATLY & LEGIBLY

-FOR OFFICE USE ONLY-

AGENCY	DATE	SIGNATURE OF APPROVAL
State Highways		
Building Officials		
PSZA (Zoning)		
PSZA (Engineering)		
Health	<u>8-7-14</u>	<u>Dana Beard</u>
Fire Protection		

DPZ SETBACK INFORMATION
Front
Rear
Side
Side U
All minimum setbacks met? <input type="checkbox"/> Yes <input type="checkbox"/> No
Is Erosion Permit Required? <input type="checkbox"/> Yes <input type="checkbox"/> No
Historic District? <input type="checkbox"/> Yes <input type="checkbox"/> No
Lot coverage for New Town Zone:
SDP red-line approval date:

Filing Fee	\$
Permit Fee	\$
Tech Fee	\$
Excise Tax	\$
PSFS	\$
Guaranty Fund	\$
Add'l per Fee	\$
Total Fees	\$
Sub- Total Paid	\$
Balance Due	\$

MATCH LINE
S27°05'41"W
190.00'

100 YR. FLOODPLAIN
DRAINAGE & UTILITY
EASEMENT
SEE SHEET 5 OF 10


LOT 49
0.6534 AC.

LANDS BUFFER

30' BR
30' BR
30' BR


LOT 50
0.5191 AC

NON-TID
WETLAN

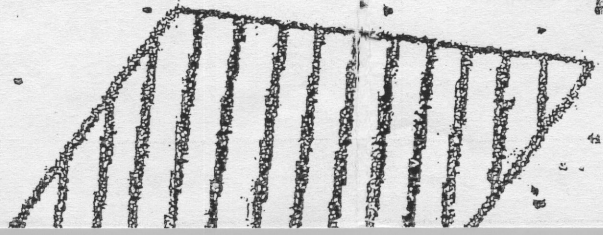

585.04'

N 70°34'29" W

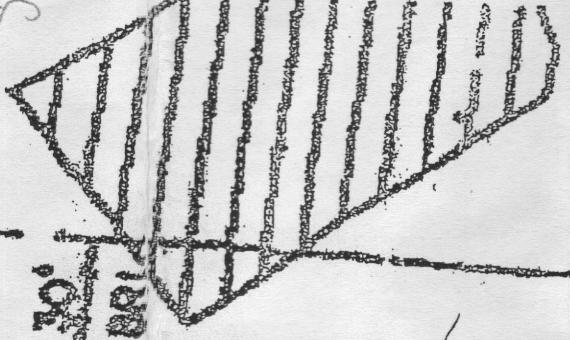

APPROVED

ped equip
FENCED
COEDY
LED AREA

WALK LIMIT
OF INDUSTRIAL

APPROVED
BUILDING PERMIT

APR 11 2014
DATE: 8-1-14
DESC. OF WORK: 22' x 44' ingo and
22' x 44' ingo and
22' x 44' ingo and

Scale slightly
off

30' BR
645.00'

N 19°25'31" E
724.90'

RONALD LEE WILKINSON
S W I R

SCALE 1"=50'

Kim, Robyn & Michael
3230 Haylett Ct.
Woodbine, MD 21791
Account # 35422