

9/3/76  
2nd

# PERMIT

SEWAGE DISPOSAL SYSTEM

23358

17266

MARYLAND STATE DEPARTMENT OF HEALTH

HOWARD COUNTY

ELLICOTT CITY

DISTRICT 5th

216 to Highland  
INDEXED  
APR 11-2  
9-3-76

DATE 6/8/76

Edwin G. Willson Builder, Inc.

IS PERMITTED TO INSTALL  ALTER

ADDRESS P. O. Box 32, Ashton, Maryland 20702

PHONE 774-9698

A SEWAGE DISPOSAL SYSTEM LOCATED AT \_\_\_\_\_

SUBDIVISION Country Lane S/D ROAD 7475 Mink Hollow Road LOT 7, Sec. 1

PROPERTY OWNER Edwin G. Willson *Jerry Walker*

ADDRESS ~~14507 Gilpin Road, Silver Spring, Md.~~ Phone: 774-9698

*6000 George Washington Drive, Holbrook, Md. 774-2597*

SPECIFICATIONS 4 bedrooms

DRAIN FIELD \_\_\_\_\_ DEPTH \_\_\_\_\_ FEET, BOTTOM AREA \_\_\_\_\_ SQ. FT.

SEEPAGE PITS \_\_\_\_\_ ABSORBENT SIDE-WALL AREA \_\_\_\_\_ SQ. FT.

SEPTIC TANK CAPACITY XXXXX 1250 GALLONS

FOR GARBAGE GRINDER, INCREASE DISPOSAL AREA 22% & TANK CAPACITY 50%.

OTHER DRY WELL - 400 sq. ft. sidewall area. Dry well inlet to be 4 ft. deep and dry well bottom to be 11 ft. deep maximum. Place the dry well 160 ft. from the right side of the lot as seen when facing the lot from Country Farm Lane and 50 ft. from the lot line which runs along Country Farm Lane.

NOTE: ALL PIPE FROM HOUSE TO DISPOSAL AREA MUST BE CAST IRON.  
PERMIT VOID AFTER THREE YEARS.

NOTE: INSTALL STAND PIPE ON SEPTIC TANK AND DRY WELL. STAND PIPES MUST BE 6 INCHES MINIMUM IN DIAMETER. CAST IRON, CONCRETE OR TERRA COTTA ACCEPTED.

PLANS APPROVED BY Raymond Hodges

DATE 6/21/73


FILL SEPTIC TANK AND DISTRIBUTION BOX WITH WATER BEFORE CALLING FOR AN INSPECTION. COVER NO WORK UNTIL INSPECTED AND APPROVED.

NEITHER THE HOWARD COUNTY COMMISSIONERS NOR THE HEALTH DEPARTMENT IS RESPONSIBLE FOR THE SUCCESSFUL OPERATION OF ANY SYSTEM.

*Must follow Rd. Dept. and not left before front Co. line*

*NOBWOOD JAN 25-E-P*

17266

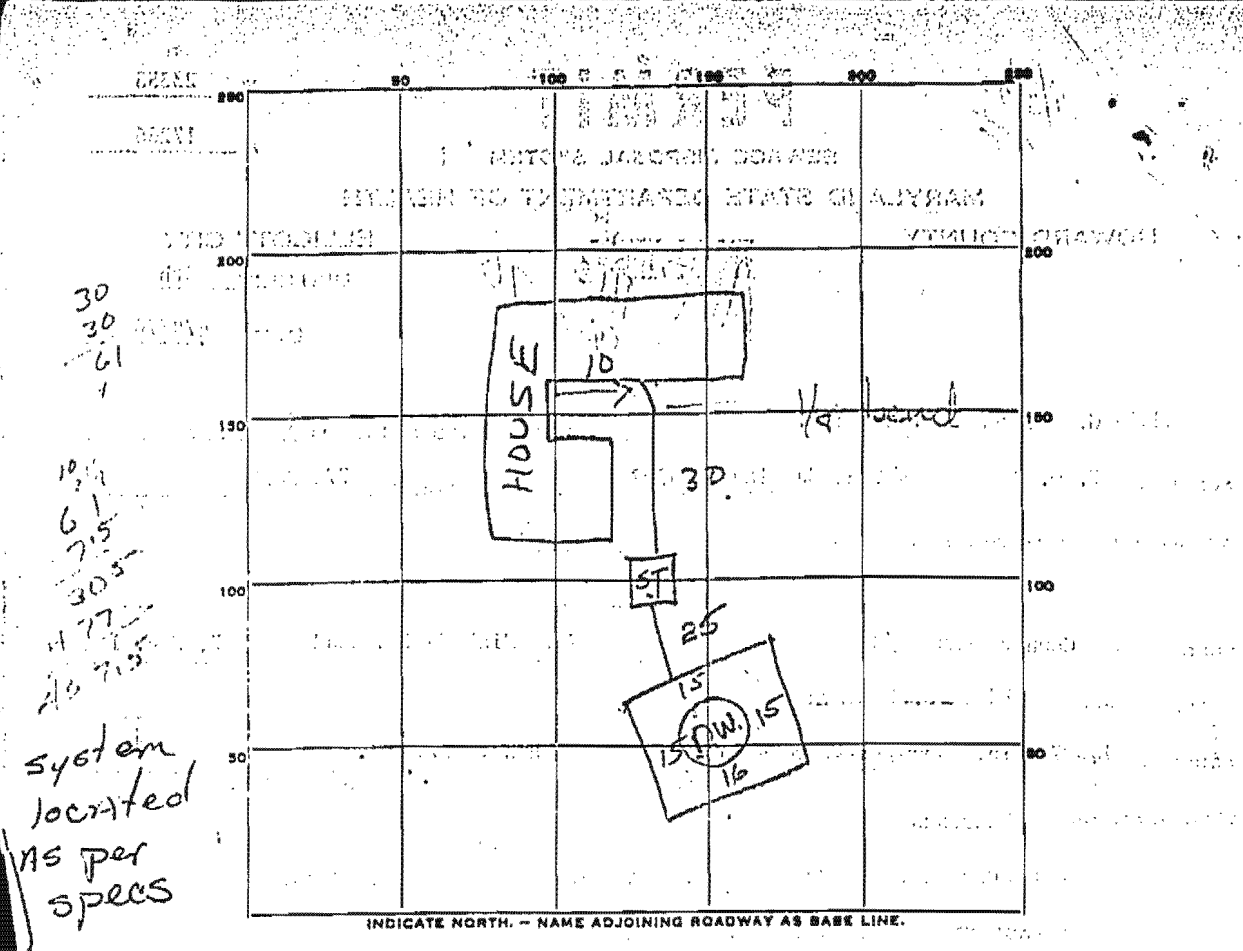

30  
30  
61  
1

10 1/4  
61  
7 1/2  
30 5  
4 7 1/2  
20 7 1/2

System located as per specs

INDICATE NORTH. - NAME ADJOINING ROADWAY AS BASE LINE.

PERMIT CARD \_\_\_\_\_

SEPTIC TANK, LEVEL 1258 CLEANOUTS OW | ST

DISTRIBUTION BOX, LEVEL \_\_\_\_\_

TILE FIELD, DEPTH \_\_\_\_\_ FT. TRENCH WIDTH \_\_\_\_\_ FT.

GRAVEL DEPTH \_\_\_\_\_ IN. TOTAL LENGTH \_\_\_\_\_ FT.

NUMBER OF TRENCHES \_\_\_\_\_ TOTAL BOTTOM AREA \_\_\_\_\_

SEEPAGE PITS, Perimeter INSIDE DIAMETER 61 FT. DEPTH BELOW INLET 7 1/2 FT.

ABSORBENT AREA 457.5 SQ. FT.

REMARKS \_\_\_\_\_

\_\_\_\_\_

\_\_\_\_\_

\_\_\_\_\_

DATE SYSTEM APPROVED 9-3-76 INSPECTOR hal benson

# APPLICATION

A 17266

SEWAGE DISPOSAL TESTING

P \_\_\_\_\_

MARYLAND STATE DEPARTMENT OF HEALTH

HOWARD COUNTY

ELLICOTT CITY

DISTRICT 5

DATE 7/26/72

TO: THE COUNTY HEALTH OFFICER  
ELLICOTT CITY, MARYLAND

I, HEREBY, APPLY FOR THE NECESSARY TESTS IN ORDER TO CONSTRUCT (OR RECONSTRUCT) A SEWAGE DISPOSAL SYSTEM.

PROPERTY OWNER Edwin G. Willson

ADDRESS 14507 Gilpin Road, Silver Spring, Md. PHONE 774-9698

PROPERTY LOCATION:

SUBDIVISION Mink Farm LOT NO. 7, Sect. 1

ROAD AND DESCRIPTION Unnamed Road

OCCUPANT \_\_\_\_\_ PHONE \_\_\_\_\_

PERSON TO CONSTRUCT SYSTEM \_\_\_\_\_

ADDRESS \_\_\_\_\_ PHONE \_\_\_\_\_

SIZE OF LOT 5.87 acres TYPE BLDG. 3 or 4 bedrooms  
NUMBER OF BEDROOMS

IF NOT SINGLE RESIDENCE DESCRIBE \_\_\_\_\_

SIGNATURE OF APPLICANT /s/ Edwin G. Willson

APPROVED BY \_\_\_\_\_ FOR \_\_\_\_\_ DATE \_\_\_\_\_  
(KIND OF SYSTEM)

REJECTED BY \_\_\_\_\_ FOR \_\_\_\_\_ DATE \_\_\_\_\_  
(KIND OF SYSTEM)


HOLD PENDING FURTHER TESTS \_\_\_\_\_ DATE \_\_\_\_\_

REASONS FOR REJECTION OR HOLDING \_\_\_\_\_

## THIS IS NOT A PERMIT

ADJACENT

ADJACENT

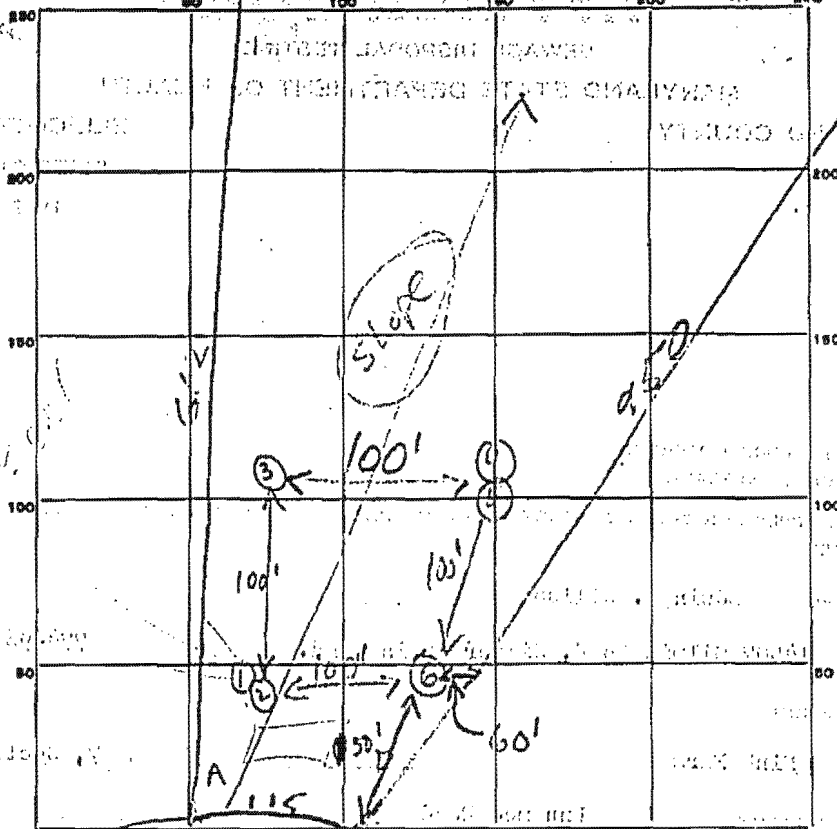

INDICATE NORTH - NAME ADJOINING ROADWAY AS BASE LINE.

UNNAMED ST

	DATE	TEST NO.	DEPTH	PRE-WET		TEST - 1" DROP		TIME
				START	STOP	START	STOP	
A	7/27/72	1	53 1/4'	2:25	2:26	2:26	2:28	3 min
		2	11'	2:25	2:27	2:27	2:28	3 min
B		3	10'	TOP 3' Clay Bottom 7'		Sandy loam		Dray
C		4	10 1/2'	2:40	2:42	2:42	2:43	3 min
		5	4'	2:40	2:42	2:42	2:43	3 min
D		6	11'	TOP 5' Clay Bottom 6'		Sandy loam		Dray

artome  
3/2/72

max  
depth  
4F7

SOIL AUGER FINDING

TESTED BY

REMARKS

*B. H. Miller*