

APPLICATION

FOR PERCOLATION TESTING AND SITE EVALUATION

TEST DATE(S) _____

TEST TIME _____

AP 522987

AGENCY REVIEW: _____

DATE 7/22/05

DO NOT WRITE ABOVE THIS LINE

I HEREBY APPLY FOR THE NECESSARY TESTING/EVALUATION PRIOR TO ISSUANCE OF SEWAGE DISPOSAL SYSTEM PERMIT(S) TO:

CHECK AS NEEDED:

- CONSTRUCT NEW SEPTIC SYSTEM(S)
- REPAIR/ADD TO AN EXISTING SEPTIC SYSTEM
- REPLACE AN EXISTING SEPTIC SYSTEM

CHECK AS NEEDED:

- NEW STRUCTURE(S)
- ADDITION TO AN EXISTING STRUCTURE
- REPLACE AN EXISTING STRUCTURE

CHECK ONE:

- CREATE NEW LOT(S)
- BUILD ON AN EXISTING LOT IN A SUBDIVISION
- BUILD ON AN EXISTING PARCEL OF RECORD

IS THE PROPERTY WITHIN 2500' OF ANY RESERVOIR?

- YES
- NO

THE TYPE OF STRUCTURE IS:

- RESIDENTIAL WITH PROPOSED BEDROOMS IN THE COMPLETED STRUCTURE (NOTE UNKNOWN IF APPROPRIATE)
- COMMERCIAL (PROVIDE DETAIL OF NUMBERS AND TYPES OF EMPLOYEES/CUSTOMERS ON ACCOMPANYING PLAN)
- INSTITUTIONAL/GOVERNMENT (PROVIDE DETAIL OF NUMBERS AND TYPES OF EMPLOYEES/USERS ON ACCOMPANYING PLAN)

PROPERTY OWNER(S) Frances Devlin

DAYTIME PHONE 410-997-4600 Goodier Bldrs. CELL _____ FAX _____

MAILING ADDRESS Echo Farm Route 3, 43 East Litchfield Rd., Litchfield CT 06750

STREET CITY/TOWN STATE ZIP

APPLICANT Heritage Land Development

DAYTIME PHONE 410-489-7900 CELL 410-982-2882 FAX 410-489-9768

MAILING ADDRESS 3060 Washington Road, Suite 220 Glenwood MD 21738

STREET CITY/TOWN STATE ZIP

APPLICANT'S ROLE DEVELOPER BUILDER BUYER RELATIVE/FRIEND REALTOR CONSULTANT

PROPERTY LOCATION

SUBDIVISION NAME Meriweather Farm - Section 3 LOT NO. 66

PROPERTY ADDRESS 14944 Roxbury Road Glenelg

STREET TOWN/POST OFFICE

TAX MAP PAGE(S) 21 GRID 16 PARCEL(S) 28 PROPOSED LOT SIZE 1 Acre


AS APPLICANT, I UNDERSTAND THE FOLLOWING: THE SYSTEM INSTALLED SUBSEQUENT TO THIS APPLICATION IS ACCEPTABLE ONLY UNTIL PUBLIC SEWAGE IS AVAILABLE. THIS APPLICATION IS COMPLETE WHEN ALL APPLICABLE FEES AND A SUITABLE SITE PLAN HAVE BEEN RECEIVED. I ACCEPT THE RESPONSIBILITY FOR COMPLIANCE WITH ALL M.O.S.H.A. AND "MISS UTILITY" REQUIREMENTS. APPROVAL IS BASED UPON SATISFACTORY REVIEW OF A PERC CERTIFICATION PLAN. TEST RESULTS WILL BE MAILED TO APPLICANT.

Jimmy Rutter
SIGNATURE OF APPLICANT

HOWARD COUNTY HEALTH DEPARTMENT, BUREAU OF ENVIRONMENTAL HEALTH, WELL AND SEPTIC PROGRAM
3525-H ELLICOTT MILLS DRIVE, ELLICOTT CITY, MARYLAND 21043-4544 (410) 313-1771 FAX (410) 313-2648
TDD (410) 313-2323 TOLL FREE 1-877-4MD-DHMH

A/P

@ rock
 brown
 4-6" 10
 angular clay
 3
 TRAs 1101
 4
 4-6
 sandy
 loam
 silty
 mix
 8
 11
 w
 black
 manganese
 12
 5020/5021
 brown
 4-6
 heavy loam
 7
 4-6
 compact
 sl
 w
 100% gravel
 -15%
 cobbles.
 7
 Stony
 coarse
 chert
 25-40%
 compact
 sl maty
 9
 5022
 brown
 0-b
 heavy loam
 (ab)
 Transition
 yellow
 brown
 sl
 4
 5
 Rock seam
 6
 25%
 cobbles,
 moist
 sl
 2
 water
 12 1/2

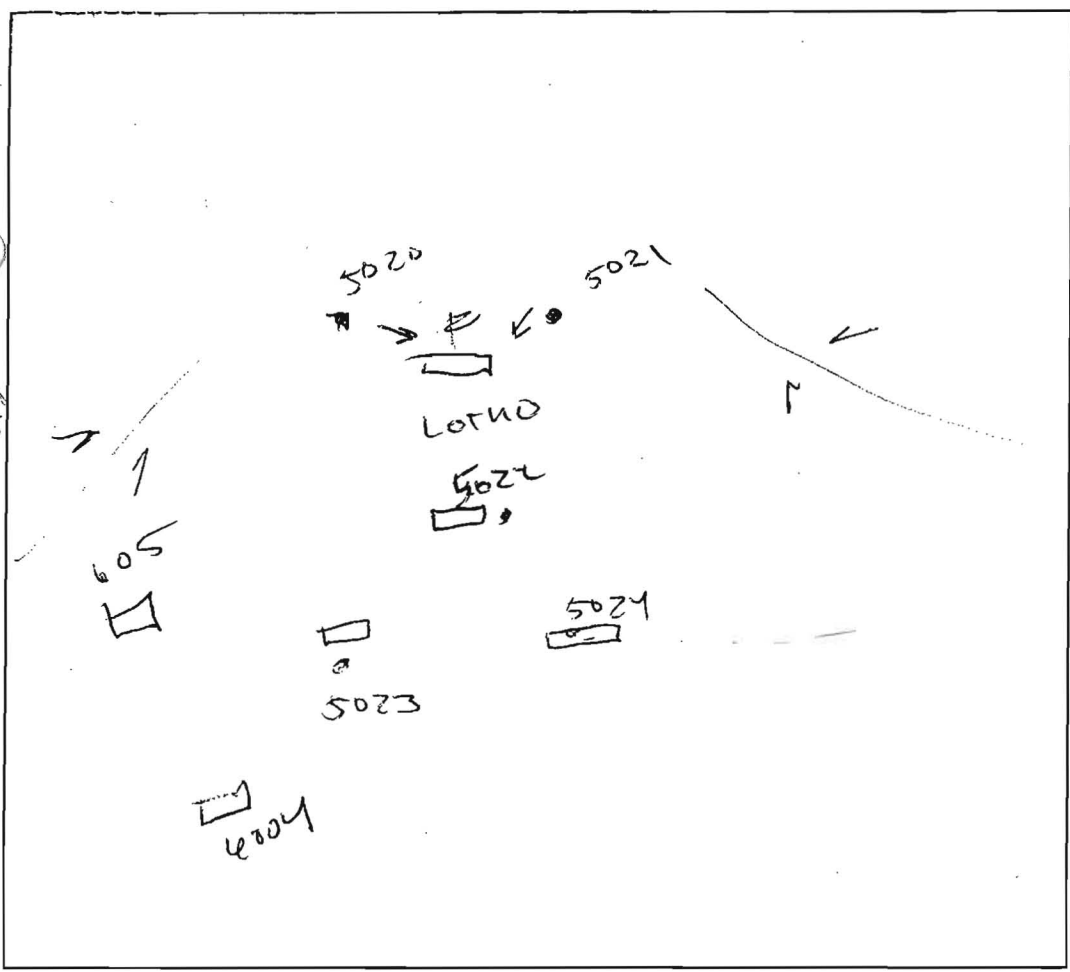


5023 + 5024
 brown
 0-6
 (ab) heavy
 sil
 heavy
 silty
 6
 4-6
 massive
 fine
 s-1
 11
 15%
 rock
 12

DATE	TEST #	DEPTH	START	BREAK 1" DROP	STOP 2" DROP	TIME OF 2nd INCH	P/F/H
9/14/65	5021/ 5020	@ 3	11:28	11:34	11:43	11	F
	3 9 1/2	@ 7	11:36	SLOW			F
	5022	12 1/2	11:41	11:55	12:16	21	P
	5023	6 13	12:42	12:47	12:54	7	P
	5024	5 1/2 13	12:48	12:59	1:23	24	P
		(Faster @ 6')					
9/16/65	6004	4 12	9:20	9:25	9:35	10	P
	6005	6 12	9:21	9:30	9:45	15	P

6005
 brown
 ab
 0-6-y
 sil
 yellow
 brown
 sandy
 silty
 loam
 massive
 12 1/2

REMARKS 5021-5020 - (NO 4' Buffer
 SANITARIAN PAY BACKHOE Zepp OTHERS Feager
 TEST HOLES USED IN SDA _____ AVG. PERC TIME _____ SQ. FT/BR _____
 TRENCH WIDTH _____ INLET DEPTH _____ MAX. BOT DEPTH _____ EFFECTIVE S/W _____

Approved P-Plan
1-25-08

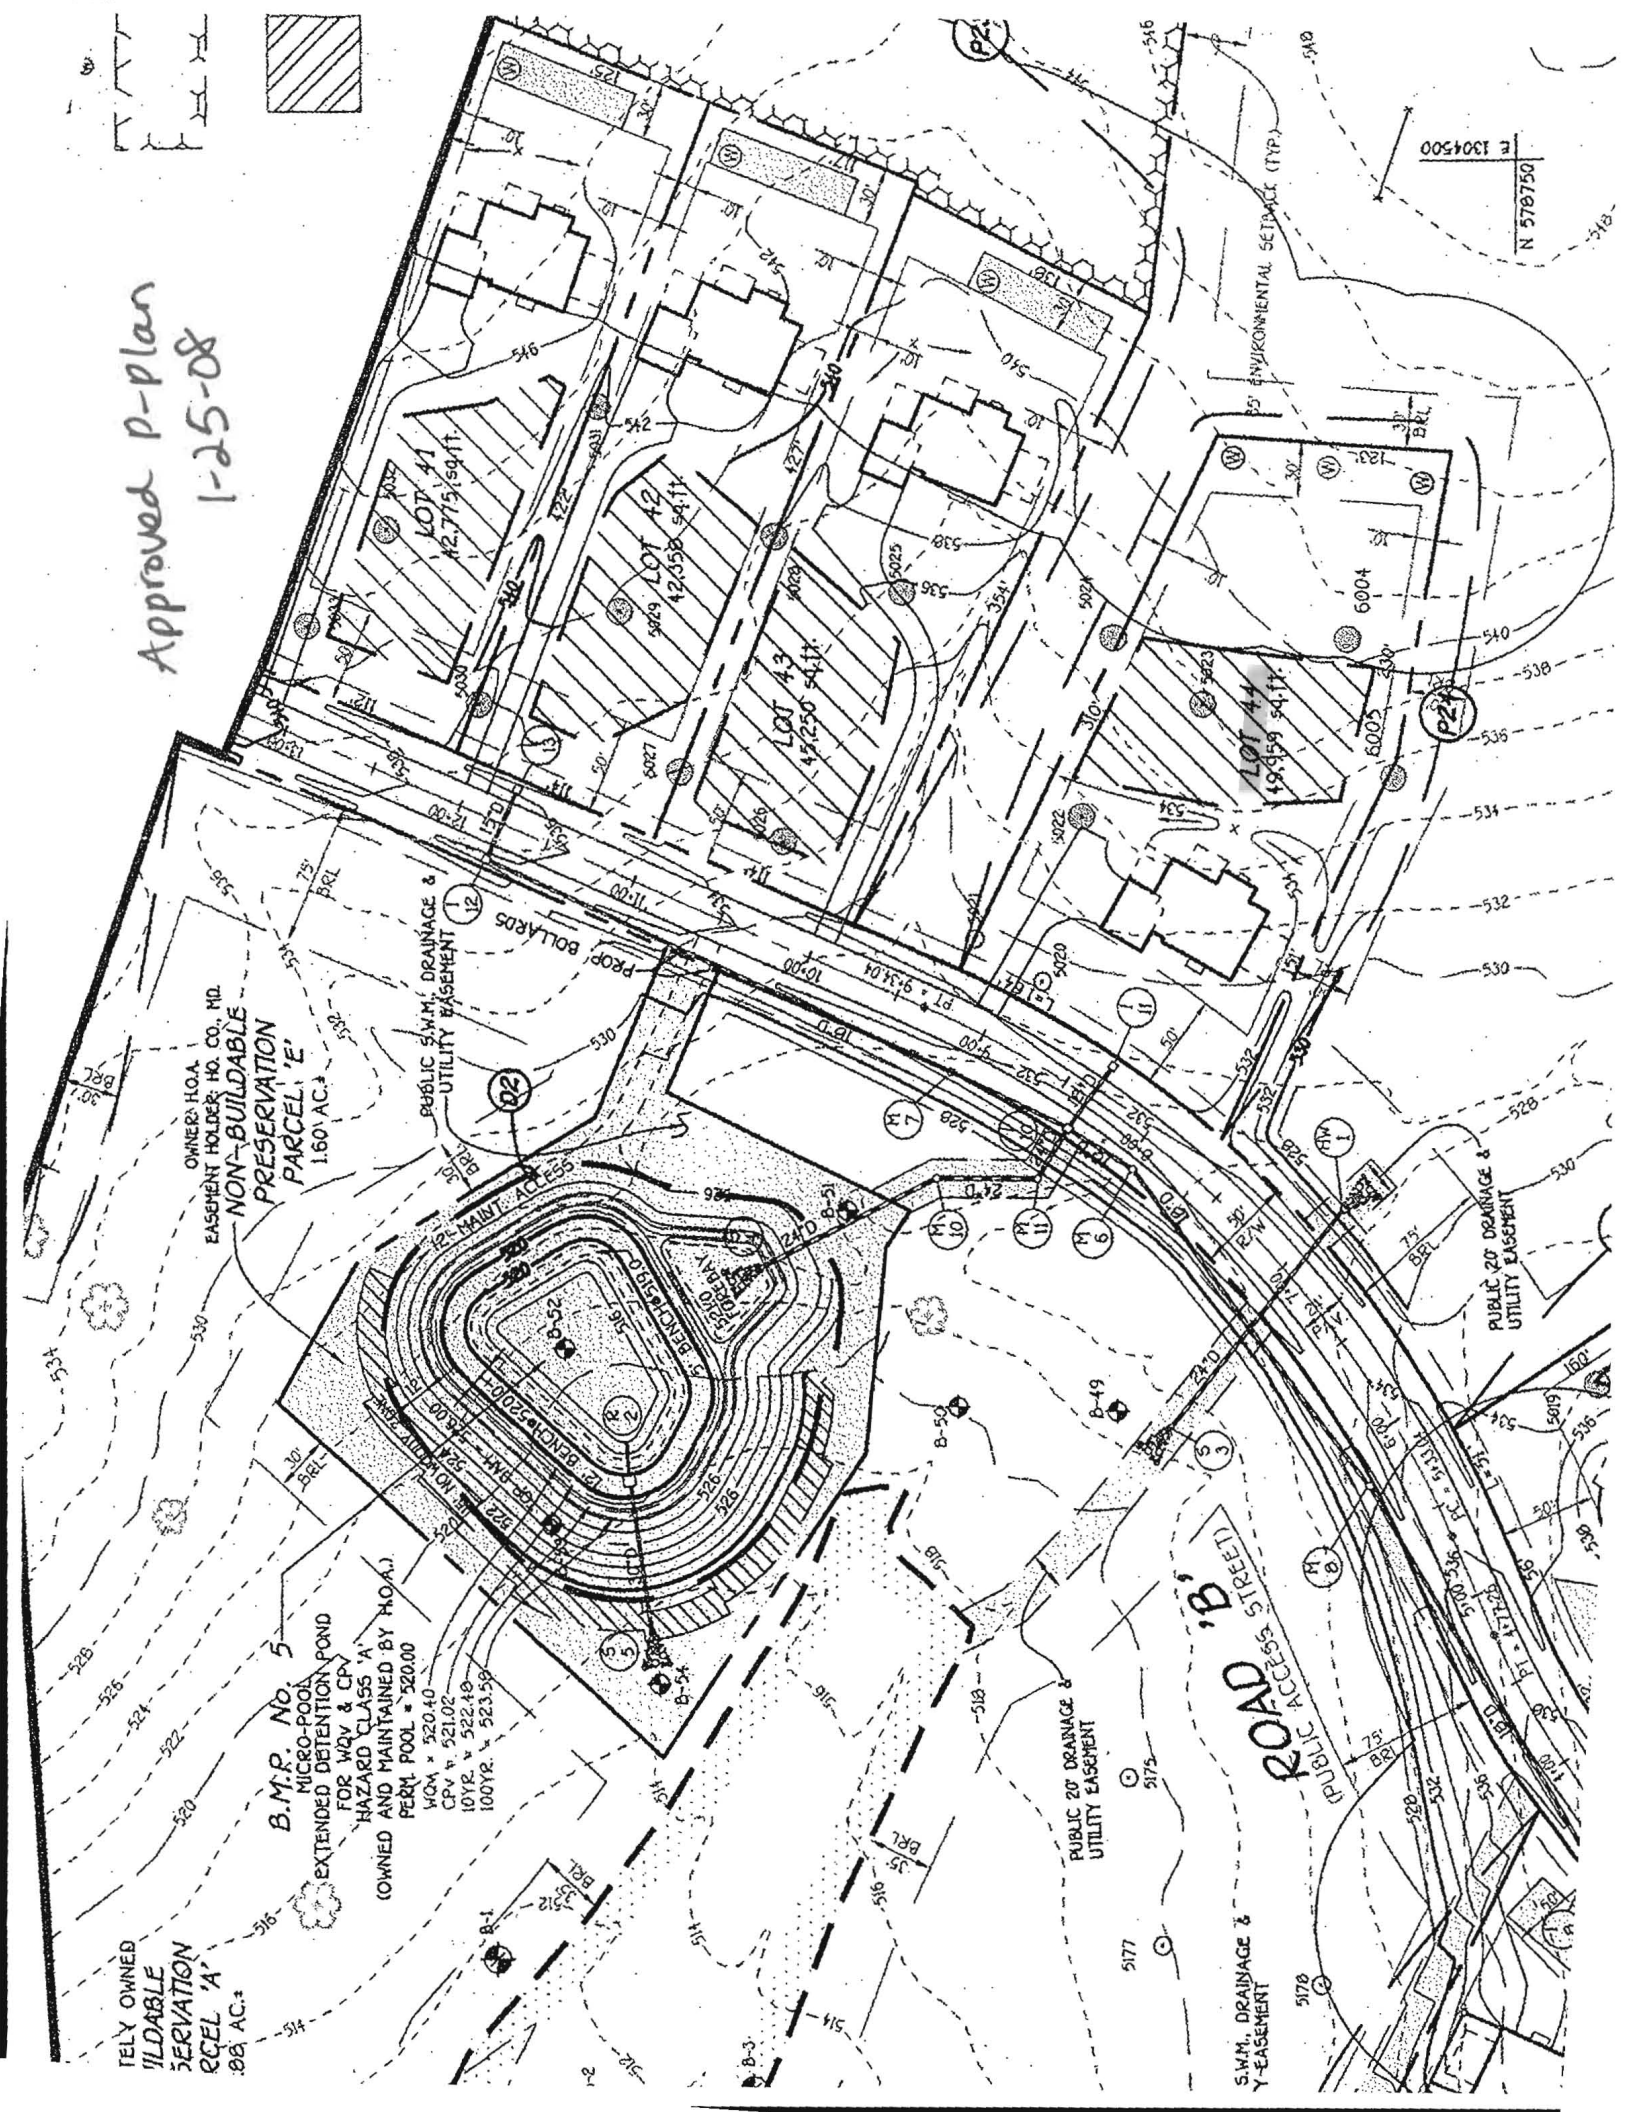

OWNER'S H.O.A. EASEMENT HOLDER HO. CO., MD. NON-BUILDABLE PRESERVATION PARCEL 'E' 1.60 AC.

B.M.P. No. 5
MICRO-POOND DETENTION POND FOR WQV & CPV HAZARD CLASS 'A' OWNED AND MAINTAINED BY H.O.A. PERM. POOL = 520.00
WQV = 520.40
CPV = 521.02
10YR = 522.48
100YR = 523.59

TELE OWNED BUILDABLE PRESERVATION PARCEL 'A' 0.86 AC.

ROAD 'B' (PUBLIC ACCESS STREET)

E 1304500
N 378750