

5/4/92
10/00

APPLICATION

PERCOLATION TESTING

PREVIOUS OK APPROVED LOT
TEST FOR RE-LOCATION
2/27/92 CW

A 47855

P _____

HOWARD COUNTY HEALTH DEPARTMENT
BUREAU OF ENVIRONMENTAL HEALTH
P.O. BOX 476 ELLICOTT CITY, MARYLAND 21043
TELEPHONE: 461-9933

DISTRICT 3 RD

DATE 3/27/92

TO: THE COUNTY HEALTH OFFICER
ELLICOTT CITY, MARYLAND

I, HEREBY, APPLY FOR THE NECESSARY TEST IN ORDER TO CONSTRUCT (OR RECONSTRUCT) A SEWAGE DISPOSAL SYSTEM.

PROPERTY OWNER CHARLES C. WIDZGA

ADDRESS 3230 TARTARIAN CT BALT 21227 PHONE 242 2969

PROSPECTIVE BUYER _____

ADDRESS _____ PHONE _____

PROPERTY LOCATION:

SUBDIVISION COVENTRY MEADOWS SECT 1 LOT NO. 5

ROAD AND DESCRIPTION COVENTRY MEADOWS DR, MID ROUTE 32 (WEST SIDE),

4,400 FT TO BEGINNING OF SITE FROM OLD FREDERICK RD (ROUTE 99 NORTH)

TAX MAP 9 PARCEL # 71

SIZE OF LOT 3 ACRES TYPE BLDG 4/5

(SINGLE FAMILY DWELLING OR COMMERCIAL)

THE SYSTEM INSTALLED UNDER THIS APPLICATION IS ACCEPTABLE ONLY UNTIL PUBLIC FACILITIES BECOME AVAILABLE. I FULLY UNDERSTAND THE FEE CONNECTED WITH THE FILING OF THIS PERC TEST APPLICATION IS NON-REFUNDABLE UNDER ANY CIRCUMSTANCES. I ALSO AGREE TO COMPLY WITH ALL M.O.S.H.A. REQUIREMENTS IN TESTING THIS LOT.

Charles C. Widzga
(SIGNATURE OF APPLICANT)

APPROVED BY _____ FOR _____ DATE _____

REJECTED BY _____ FOR _____ DATE _____


HOLD PENDING FURTHER TESTS _____ DATE _____

REASONS FOR REJECTION OR HOLDING 5/4/92 - RETESTED OK TO CHANGE SPECS R/H





HD-216

THIS IS NOT A PERMIT

SEE PLAT 882049

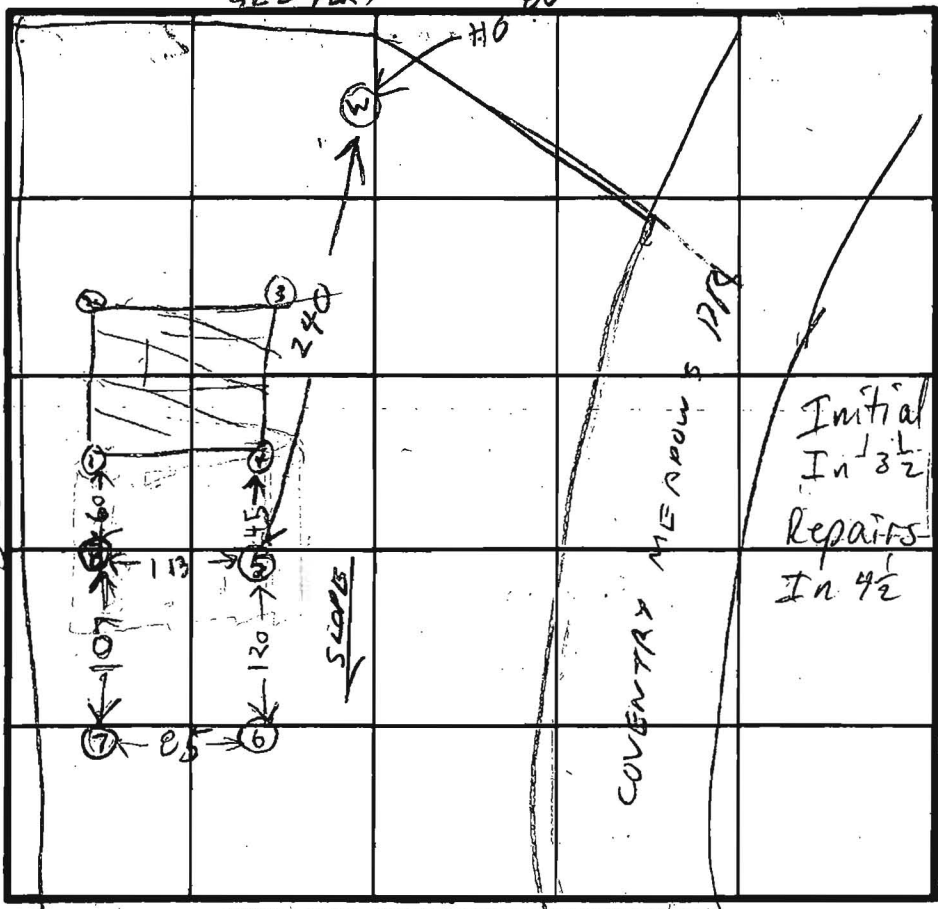

41
99
240
15
2
8
6
9/5
Initial 180 P/BLL
In 1 3/2 Bot 7 1/2
Repairs 210 P/BLL
In 4 1/2 Bot 6 1/2
4
NEW
SIEGS
USED LT
TEST
HOLES
① 3 ④
7 2
INLET 3 FT
DEPTH 6 FT

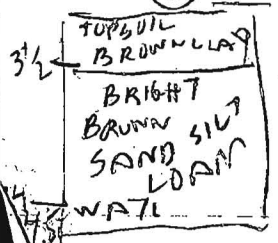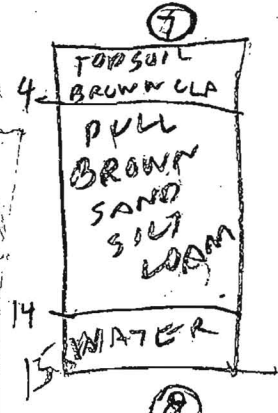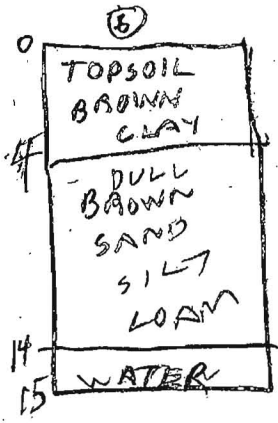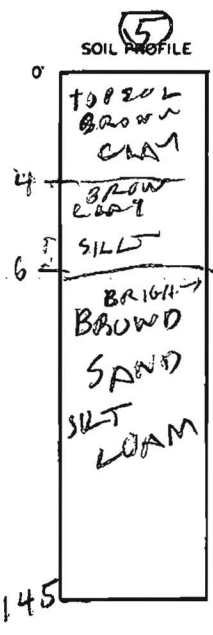

DATE	TEST NO.	DEPTH	PRE-WET		TEST - 1" DROP		TIME	
			START	STOP	START	STOP		
5/4/92	5 S	4.5	1035	1157	1st inch	82 F	10	
	5 D	9	1041	1045	1045	1055		
	5 V	14.5	OK DEEP					
	6 D	8.5	1102	1104	1104	1107	3	
	6 S	5	1104	1106	1108	1109	2	
	6 V	15	WATER DO NOT USE					
	7 D	10	1146	1153	1153	1220	27	
	7 S	5	1144	1147	1147	1153	4	
	7 V	15	WATER DO NOT USE					
	8 D	9.5	1215	1229	1220	1235	15	
	8 S	5	1218	1223	1223	1227	4	
5/4/92	8 V	14.5	OK					

REMARKS 5/4/92 DO NOT USE WATER HOLES ⑥ & ⑦

TYPE OF SOIL _____
TESTED BY B. HODGES
ALSO PRESENT STRATIS LER BACKHOLE
CHUCK WILDEN