

PUB. SEWER STATUS VERIFIED BY _____

ISSUE DATE:

12/11/07

PERMIT

P

527947

APPROVAL DATE:

12/20/2007

A

REPAIR

Tax ID #

**ON-SITE SEWAGE DISPOSAL SYSTEM
HOWARD COUNTY HEALTH DEPARTMENT
BUREAU OF ENVIRONMENTAL HEALTH**

Freedom Septic

IS PERMITTED TO INSTALL ALTER

ADDRESS:

PHONE NUMBER:

SUBDIVISION:

LOT NUMBER:

ADDRESS:

10817 Braeburn Rd.

PROPERTY OWNER:

SEPTIC TANK CAPACITY (GALLONS):

LAYOUT REQUIRED

PUMP CHAMBER CAPACITY (GALLONS):

Trenches 2' Wide

NUMBER OF BEDROOMS:

4

Inlet 3'

SQUARE FEET PER BEDROOM:

Bottom 9'

LINEAR FEET OF TRENCH REQUIRED:

100'

2-50' Trenches

TRENCHES:	
LOCATION:	
ADDITIONAL NOTES:	

PLANS APPROVED:

B. Baker

DATE:

12/14/07

NOTE: PERMIT VOID AFTER 2 YEARS

NOTE: CONTRACTOR RESPONSIBLE FOR SCHEDULING A PRE-CONSTRUCTION INSPECTION FOR ALL INSTALLATIONS


NOTE: WATERTIGHT SEPTIC TANKS REQUIRED

NOTE: ALL PARTS OF SEPTIC SYSTEM SHALL BE 100 FEET FROM ANY WATER WELL

NOTE: MANHOLE RISERS REQUIRED ON ALL SEPTIC TANKS AND PUMP CHAMBERS

**NEITHER THE HOWARD COUNTY COUNCIL OR THE HEALTH DEPARTMENT IS
RESPONSIBLE FOR THE SUCCESSFUL OPERATION OF ANY SYSTEM
PERMITTEE RESPONSIBLE FOR OBTAINING FINAL APPROVAL ON THIS PERMIT
CALL 410-313-2640 FOR INSPECTION OF SEPTIC SYSTEM**

NOT TO SCALE

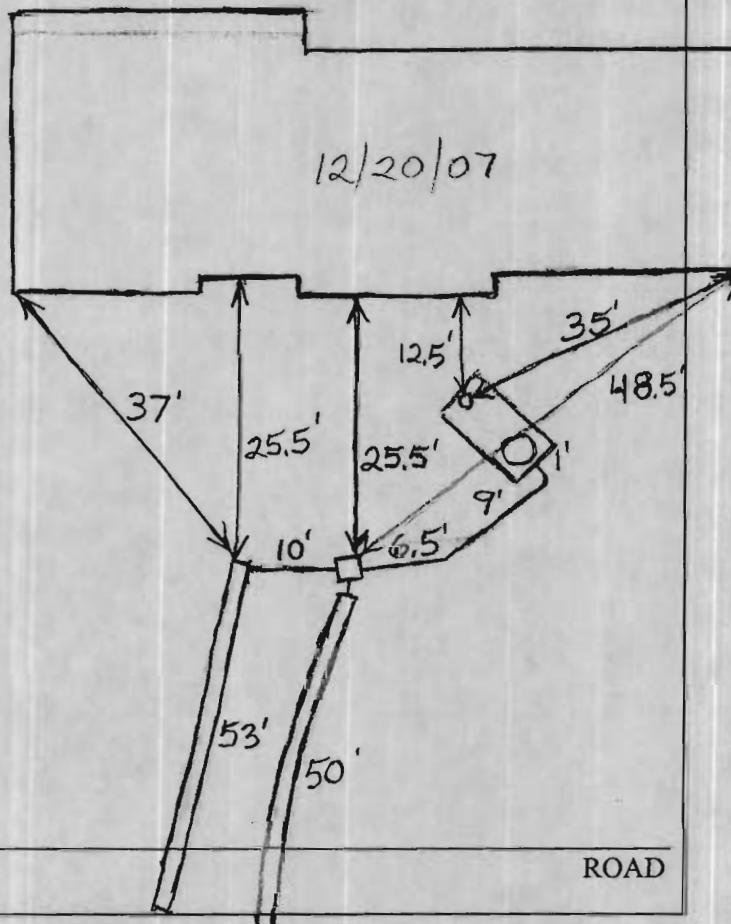

TRENCH/DRAINFIELD DATA		
WIDTH	INLET	BOTTOM
2'	3'	9'
NUMBER OF TRENCHES		2
TOTAL LENGTH		103'
ABSORPTION AREA		567
DISTRIBUTION BOX LEVEL		Levelers
DISTRIBUTION BOX BAFFLE		Yes
DISTRIBUTION BOX PORT		No

SEPTIC TANK DATA	
SEPTIC TANK 1 LEVEL	
CAPACITY	1500? GAL
SEAM LOC	Midseam
TANK LID DEPTH	1'-1.5'
BAFFLES	Yes
BAFFLE FILTER	No
MANHOLE LOC	Rear
6" PORT LOC	Front
WATERTIGHT TEST	No
SEPTIC TANK 2 LEVEL N/A	
CAPACITY	GAL
SEAM LOC	
TANK LID DEPTH	
BAFFLES	
BAFFLE FILTER	
MANHOLE LOC	
6" PORT LOC	
WATERTIGHT TEST	

PRE-CONSTRUCTION 12/14/07 I install 2-50' trenches directly downhill of tree near driveway. (BB)

INSTALLATION 12/20/07 System loops O.K. but trenches installed farther away from tree than desired. Home-owner worried about tree dying. Public sewer is supposed to be available some time in future. (BB)

FINAL INSPECTOR B. Baker DATE OF APPROVAL 12/20/2007

05-368243

9-13-85
ASAP

PERMIT

9-13-85
approved
B. Stuel

P 35980

A 27649

SEWAGE DISPOSAL SYSTEM

MARYLAND STATE DEPARTMENT OF HEALTH*

HOWARD COUNTY
BUREAU OF ENVIRONMENTAL HEALTH
992-2330

ELLICOTT CITY

DISTRICT 5th

DATE 9/13/85

INDEXED

Jack Fyock

IS PERMITTED TO INSTALL ALTER

ADDRESS 13775 Triadelphia Road, Glenelg, Md. 21737 PHONE 988-9270

SUBDIVISION Braeburn ROAD 10817 Braeburn Road LOT 1

PROPERTY OWNER David Southall

ADDRESS 5230 Patriot Lane, Columbia, Md. 21045 Phone: 997-2473

IF GARBAGE GRINDER IS USED INCREASE SEPTIC TANK CAPACITY BY 50% AND ABSORPTION AREA BY 22%.

GARBAGE GRINDER? YES NO

SEPTIC TANK CAPACITY 1,250 GALLONS

TEACHING BED